




APPENDIX E


AS-BUILT DRAWINGS FOR BUILDING 44

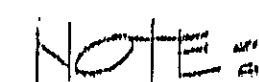

EXISTING PAIR OF MTL. HANGAR
SLIDING DOORS AND ACCESSIBLE
TO BE REMOVED ARE NOT
SHOWN. PROVIDE NEW CORRUGATED
MTL. SIDING AND INSULATION, SAME
MATERIAL AS THE EXISTING WORK,
TO COVER THE DOOR OPENING
SPACE ABOVE THE NEW ~~PAV-~~
AGENCY ADDITION.

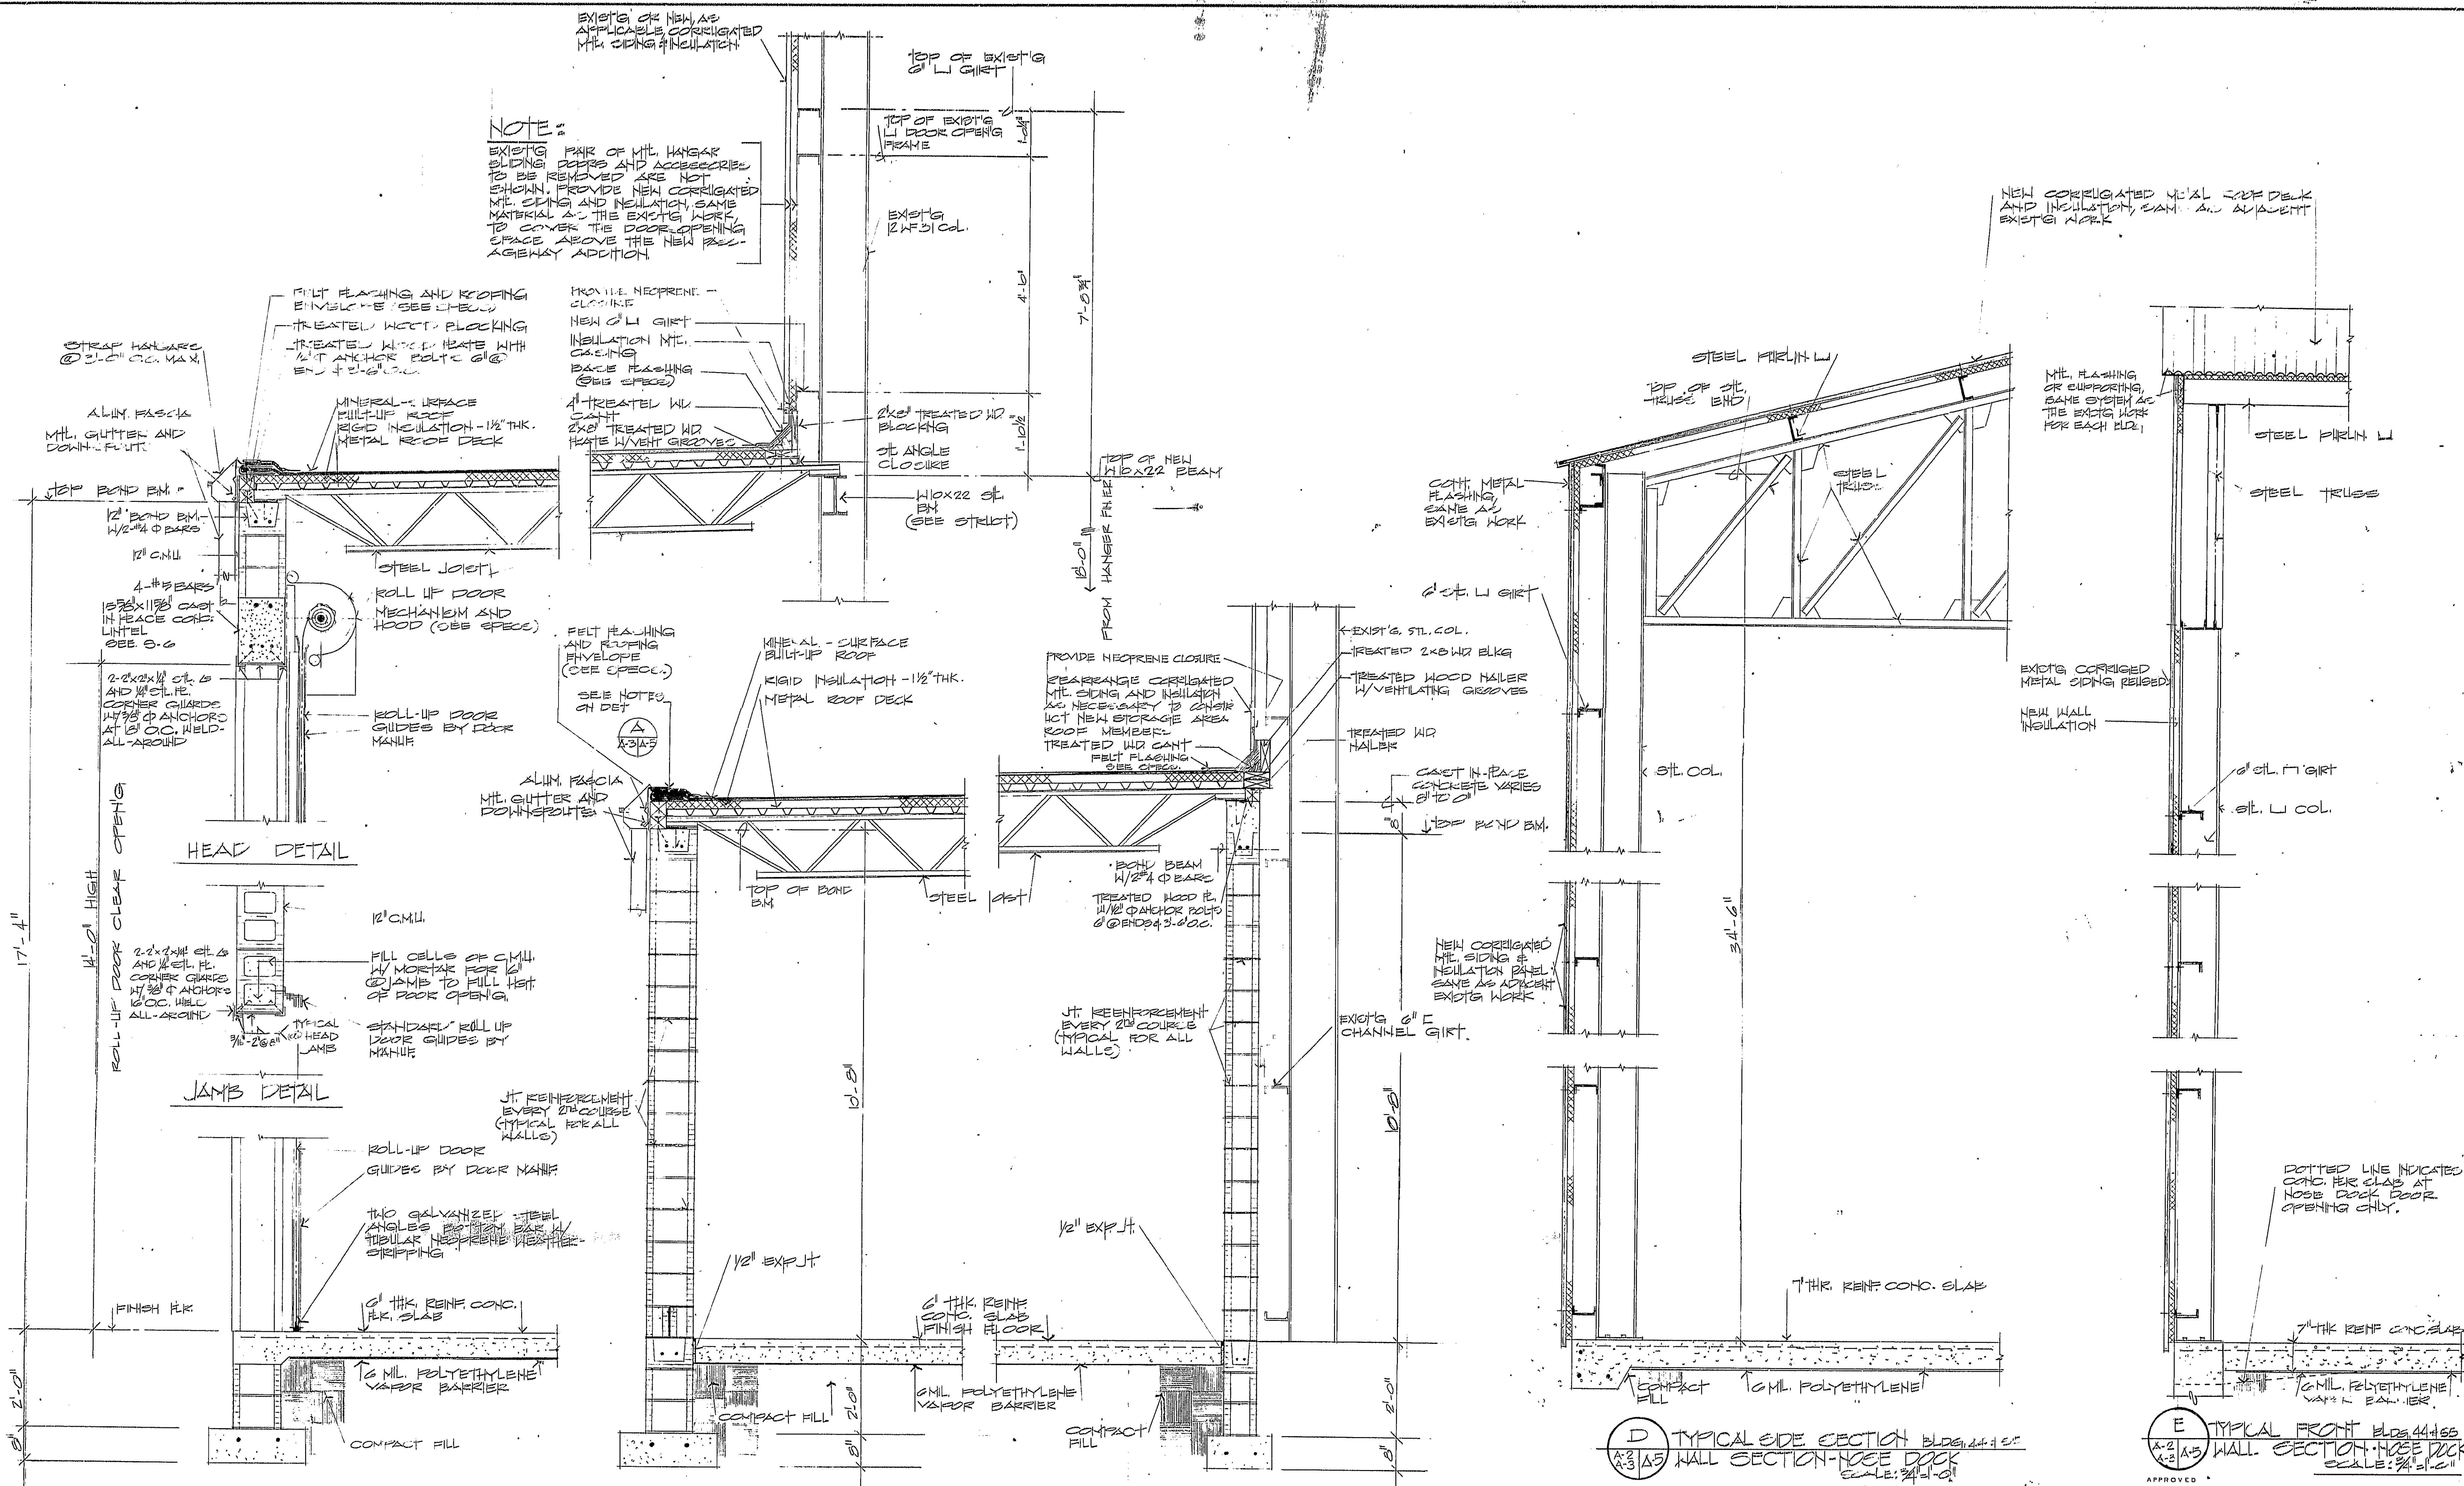


 WALL SECTION - BLDG. 44
 NEW PASSAGEWAY
 SCALE: 3/4" = 1'-0"








 WALL SECTION - PLUG 44
 STORAGE AREA
 SCALE 1/4" = 1'-0"

C WALL SECTION BLDG. - 44.
A-3 A-5 STORAGE AREA
SCALE: 3/4" = 1'-0"

D TYPICAL SIDE SECTION BLDG. 44-1-50
A-2 A-5 HALL SECTION-NOSE DOCK
SCALE: 1/4"=1'-0"

SEE SHEET 1 OF 31
FOR APPROVED SIGNATURES


[illegible]

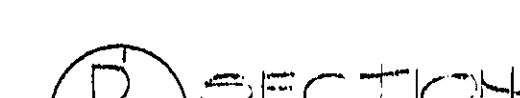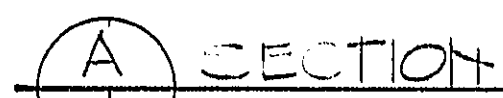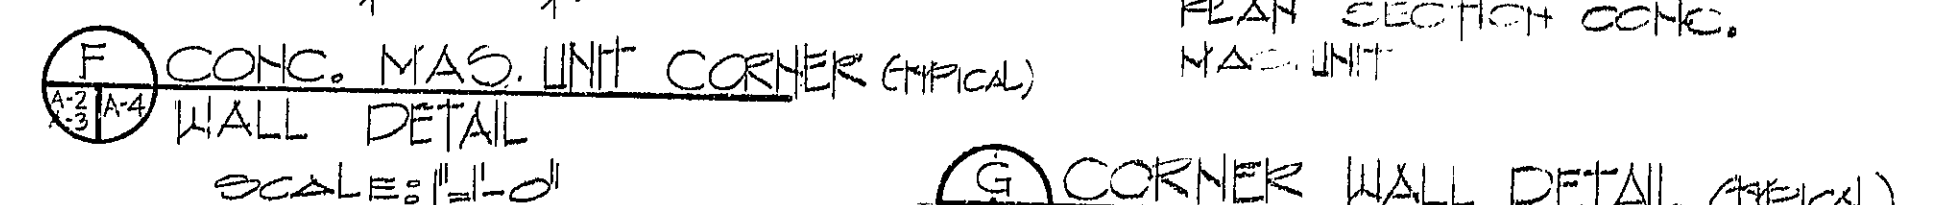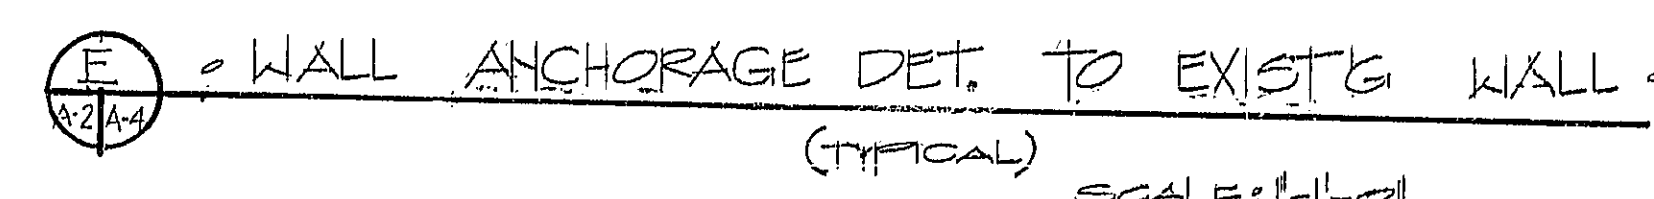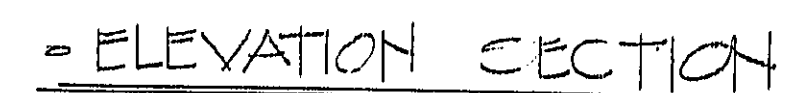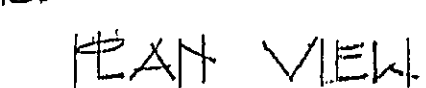

- NEW STORAGE KM. WALL SECTIONS FOR PLUG 55.



SCALE 3/4" = 1'-0"

END UNIT ALIC	DESIGNED <i>RK</i>	DRAWN <i>TJH</i>	CHECKED <i>BZ</i>	DATE	BY	REVISION	C
STRUCT				WARNER ROBINS ALC			
MACH				CIVIL ENGINEERING DIVISION			
ELECTR				ROBINS AIR FORCE BASE GEORGIA			
CIVIL							
APPR:							
	<u>SUPV. ENGINEERING SECTION</u>						
APPR:							
	<u>FIRE ENG'Y</u>						
APPR:							
	<u>ENGINEERING GENERAL ENGR.</u>						
APPR:							
	<u>GROUND SAFETY OFFICIAL</u>						
APPR:							
	<u>ENVIRONMENTAL ENGR.</u>						
APPR:							
	<u>CIVIL CONSTRUCTION SECTION</u>						
SHEET	OF SHEETS			DATE:	PROJECT NO.	DRAWING REV.	
<i>7</i>	<i>31</i>			<i>5 NOV 79</i>	<i>WFO-123-9</i>	<i>15-78-92</i>	

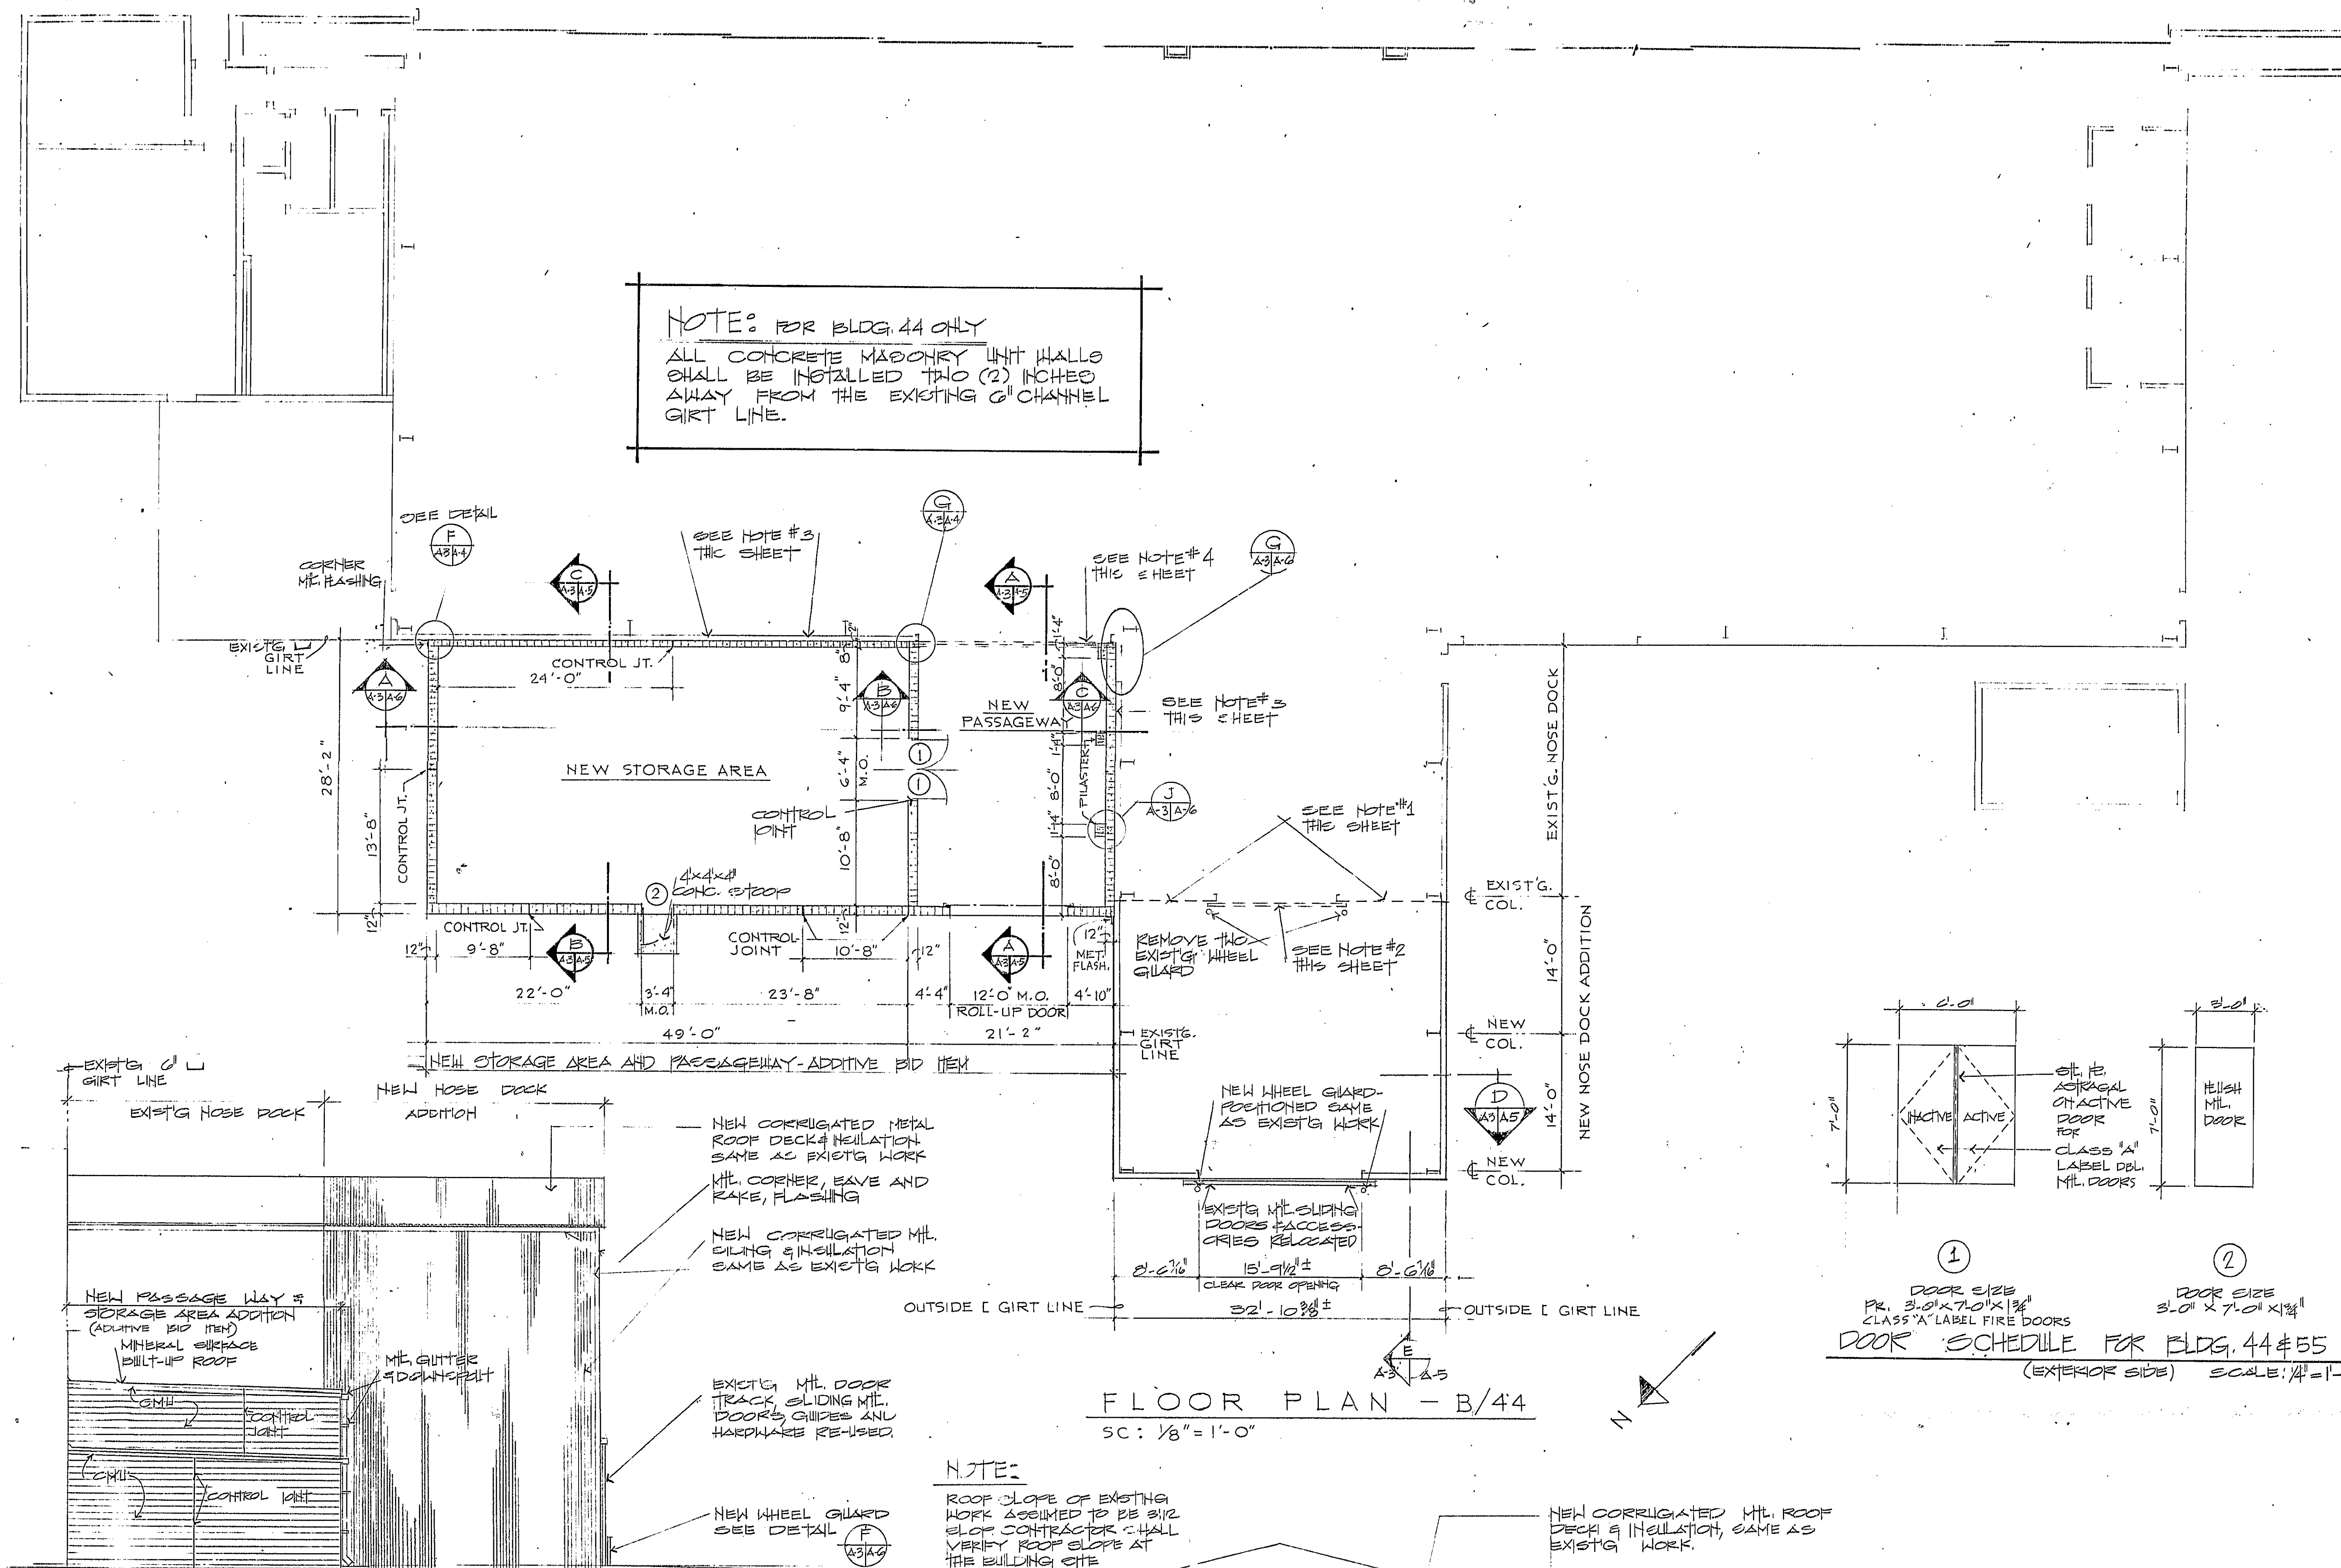

FLOOR PLAN - B/44
SC: 1/8" = 1'-0"

EAST ELEV. NEW ADDITION
SC: 1/8" = 1'-0"

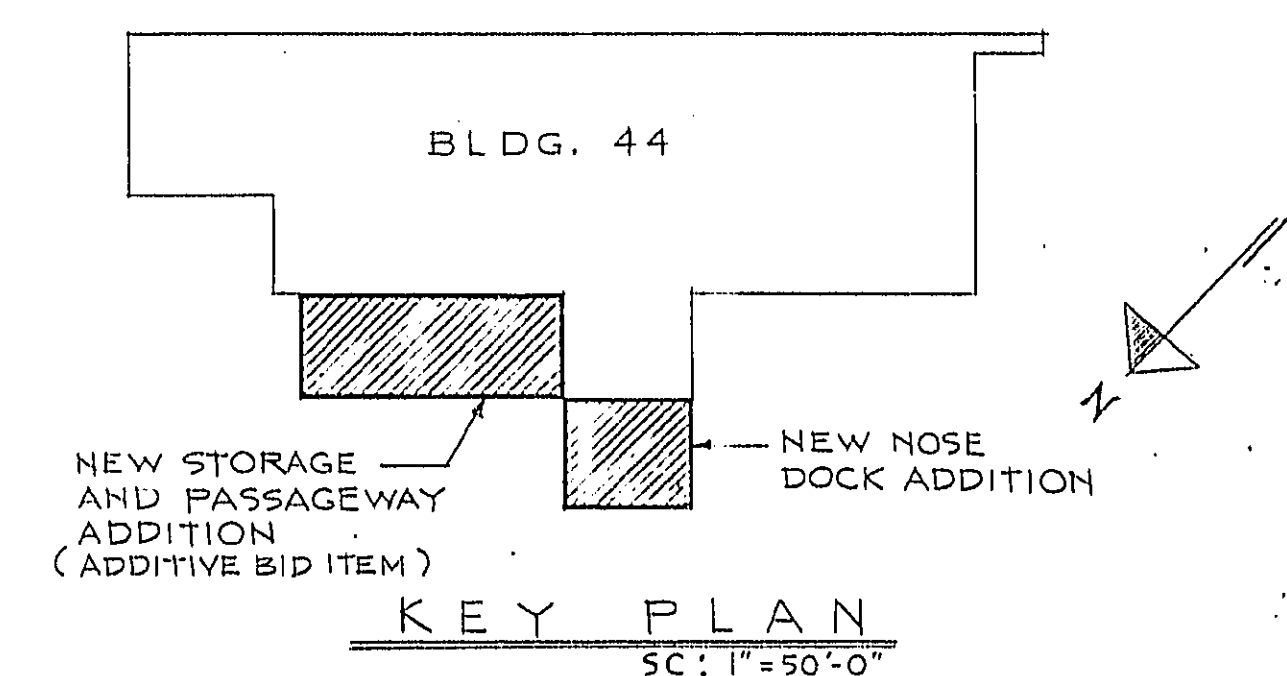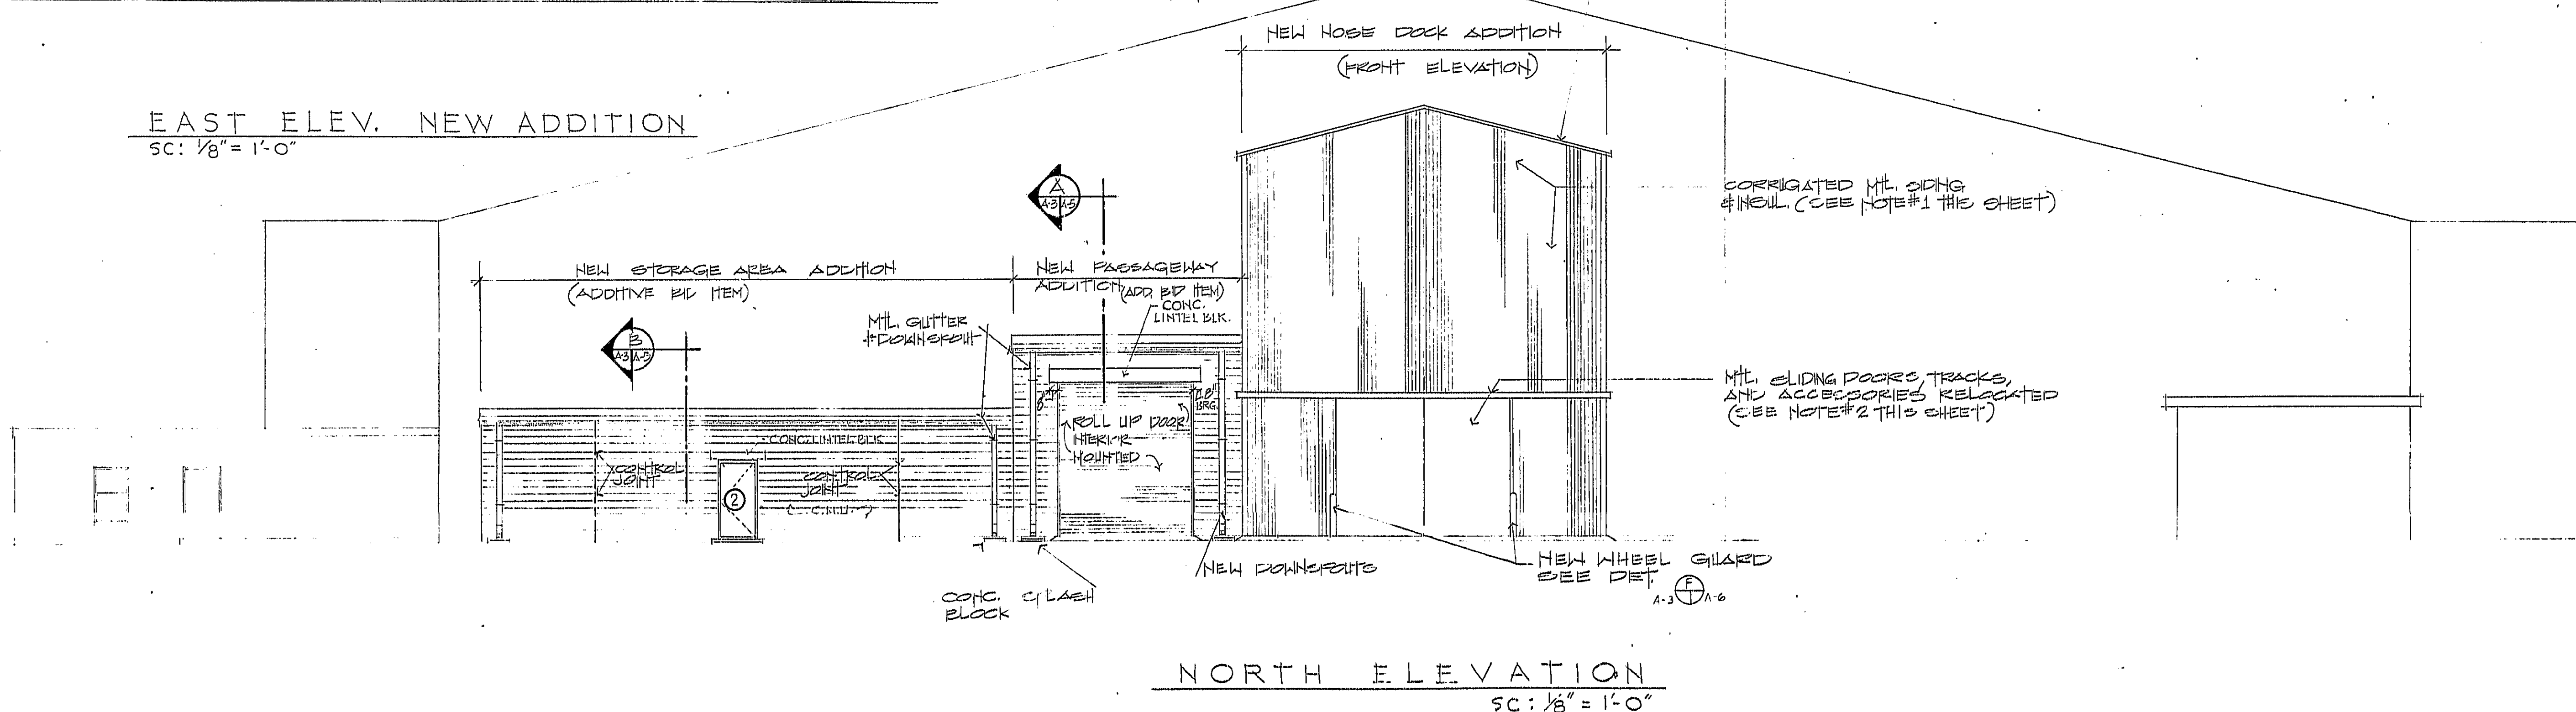


SEE SHEET 1 OF 31
FOR APPROVED SIGNATURES

APPROVED		NAME		TITLE											
[Signature]		[Name]		[Title]											
WARNER ROBINS ALC CIVIL ENGINEERING DIVISION ROBINS AIR FORCE BASE, GEORGIA ADAL A/C MAINTENANCE FACILITY NEW ADDITIONS BLDG 44 FLOOR PLAN AND ELEVATIONS (ARCHITECTURAL)															
<table border="1"> <thead> <tr> <th>NO.</th> <th>DATE</th> <th>REVISION</th> <th>BY</th> <th>CHKD.</th> </tr> </thead> <tbody> <tr> <td>1</td> <td>NOV 79</td> <td>1</td> <td>[Name]</td> <td>[Name]</td> </tr> </tbody> </table>						NO.	DATE	REVISION	BY	CHKD.	1	NOV 79	1	[Name]	[Name]
NO.	DATE	REVISION	BY	CHKD.											
1	NOV 79	1	[Name]	[Name]											
<table border="1"> <thead> <tr> <th>NO.</th> <th>DATE</th> <th>REVISION</th> <th>BY</th> <th>CHKD.</th> </tr> </thead> <tbody> <tr> <td>1</td> <td>NOV 79</td> <td>1</td> <td>[Name]</td> <td>[Name]</td> </tr> </tbody> </table>						NO.	DATE	REVISION	BY	CHKD.	1	NOV 79	1	[Name]	[Name]
NO.	DATE	REVISION	BY	CHKD.											
1	NOV 79	1	[Name]	[Name]											

PLATE
A-3

6 31 5 NOV 79 1123-9 15-74-d4

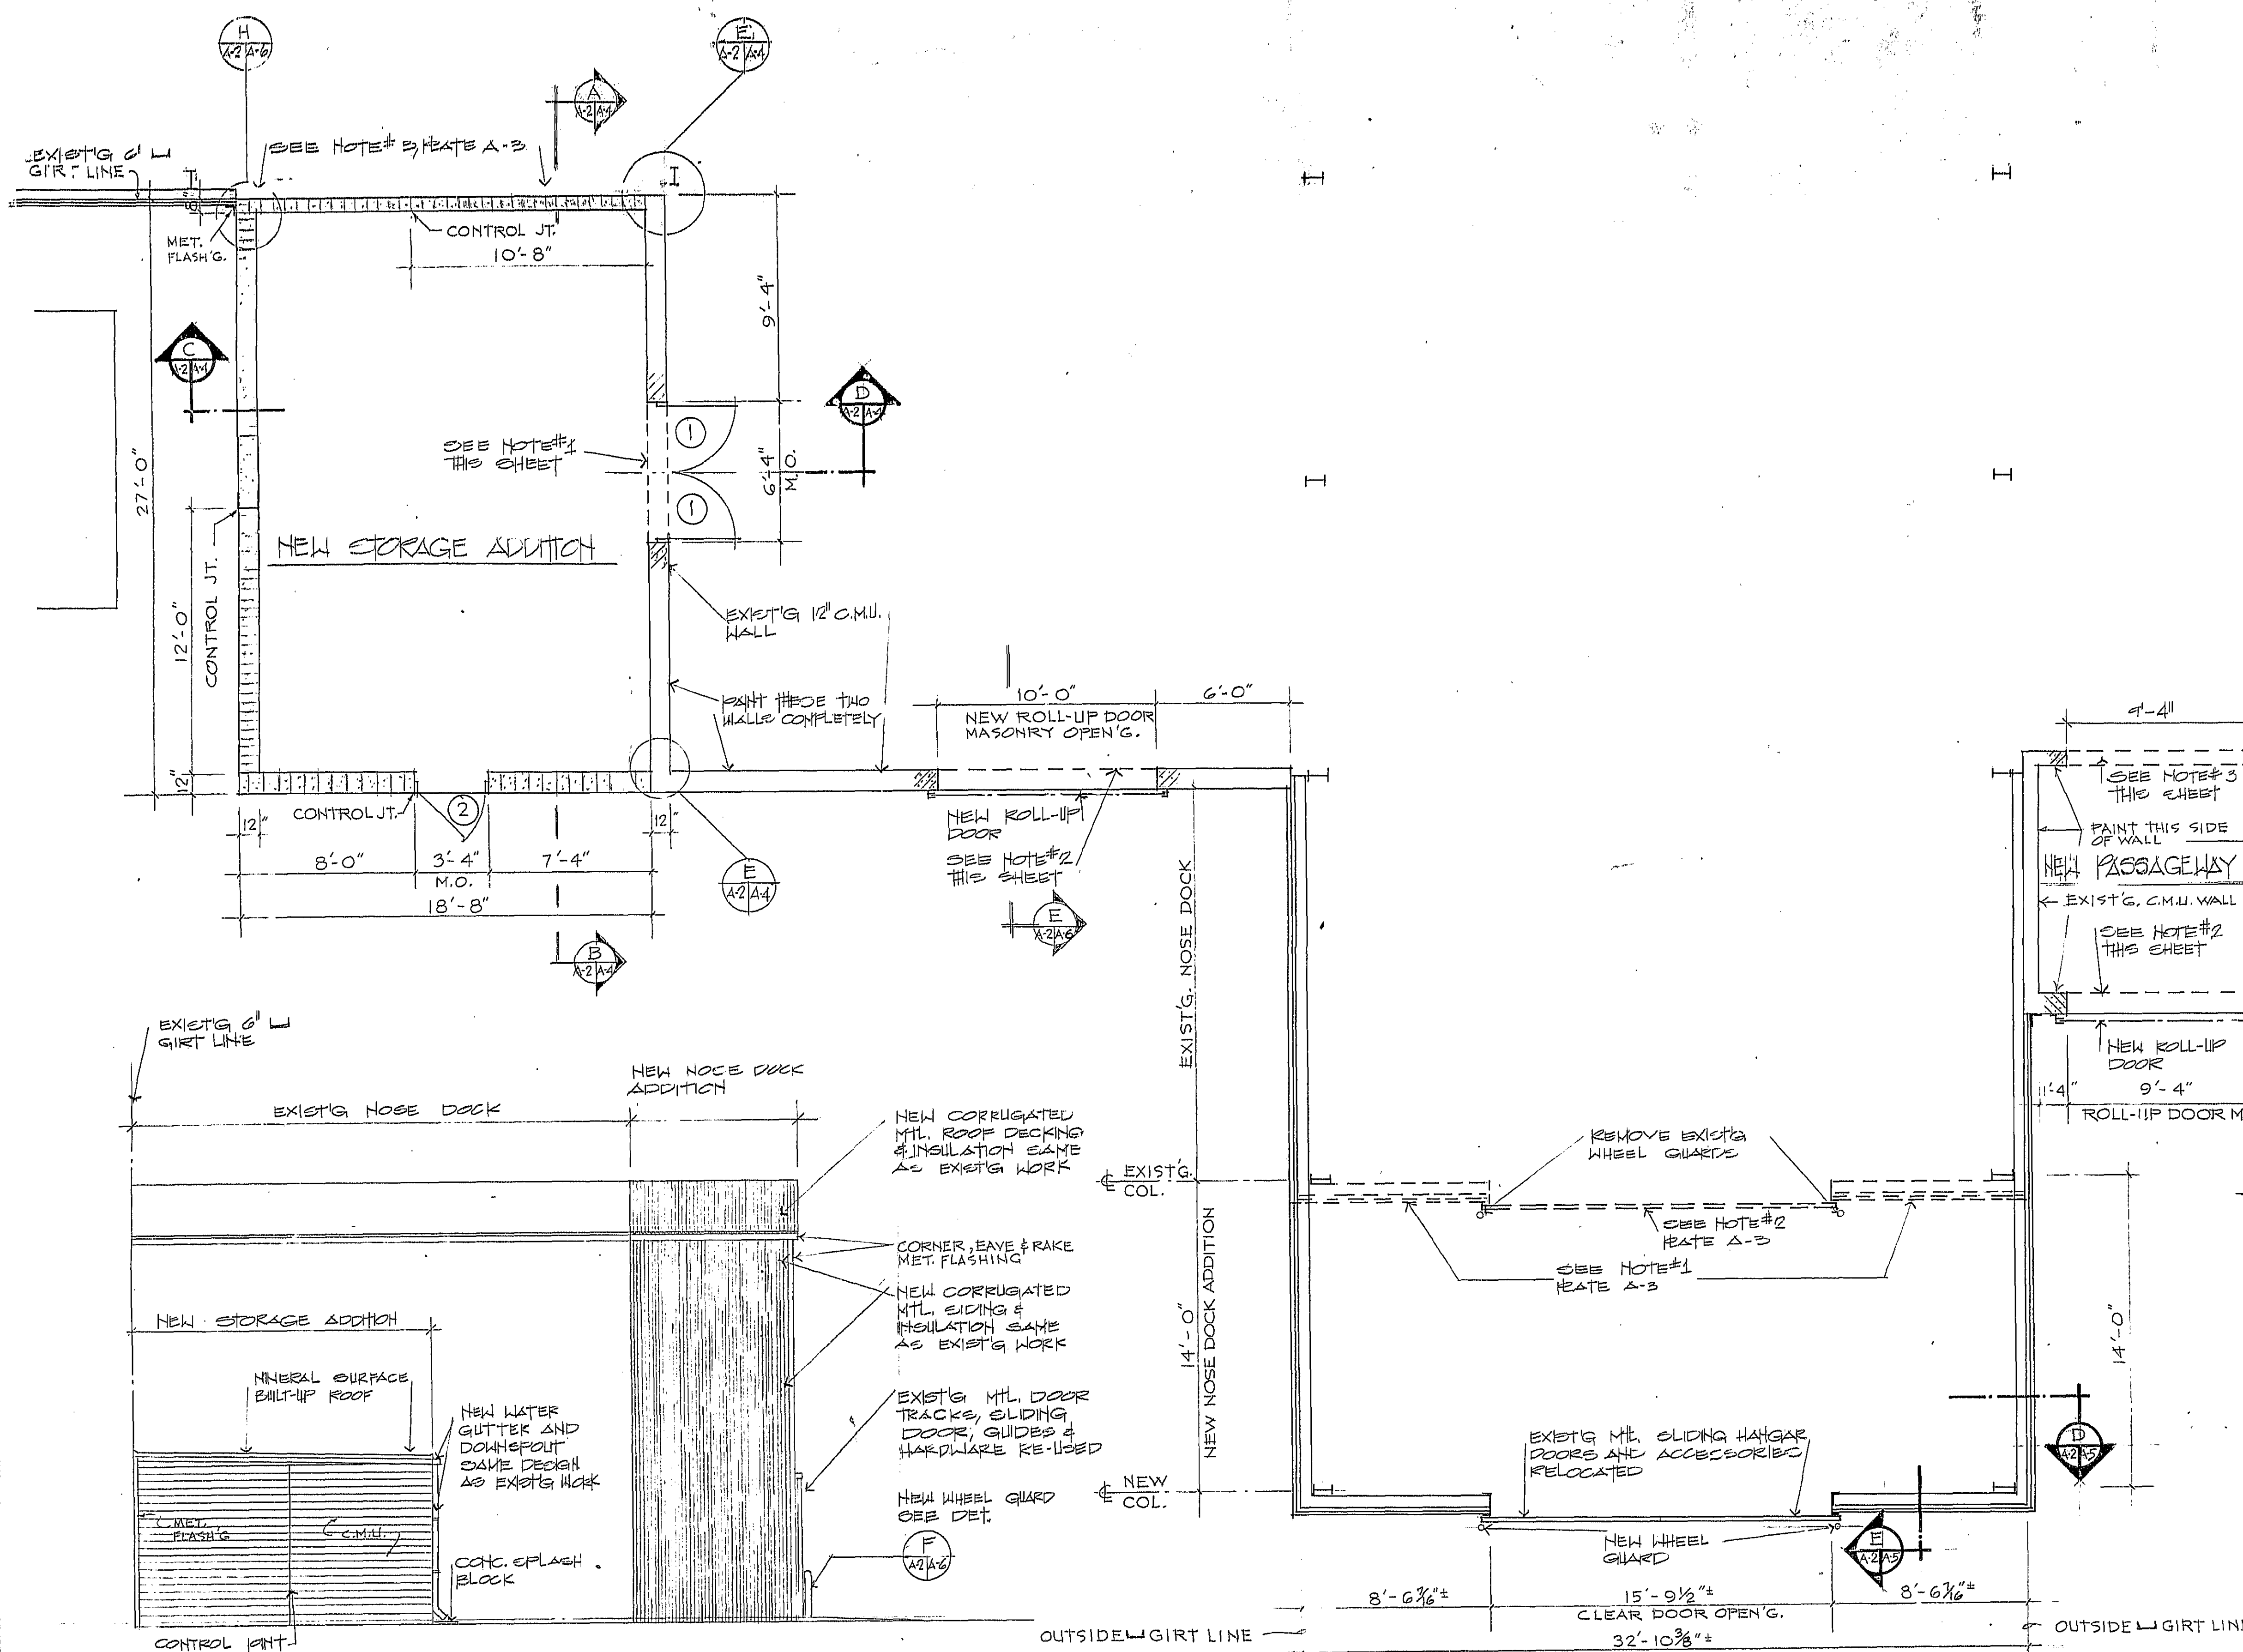

WEST ELEVATION
SC: 1/8" = 1'-0"


PARTIAL FLOOR PLAN - B/55
SC: 1/4" = 1'-0"

NOTES:

ROOF SLOPE OF EXIST'G WORK ASSUMED TO BE 3:12 SLOPE. CONTRACTOR SHALL VERIFY ROOF SLOPE AT THE BUILDING SITE.

ARCHITECTURAL NOTES:

1. REMOVE ENOUGH EXISTING MORTAR FILLED CONCRETE MASONRY UNITS TO PROVIDE A NEW 7'-0" HIGH X 9'-0" WIDE MASONRY DOOR OPENING FOR THE INSTALLATION OF GLASS "A" LABEL DOOR FRAME, GLASS "A" LABEL DOOR, AND STEEL 20-FT. LINTEL.
2. REMOVE ENOUGH EXISTING MORTAR FILLED CONCRETE MASONRY UNITS TO PROVIDE A 9'-0" WIDE AND A 10'-0" HIGH MASONRY OPENING FOR THE INSTALLATION OF THE NEW ROLL-UP DOORS (EXTERIOR MOUNT) AND STL. & FL. LINTELS.
3. REMOVE PORTION OF EXISTING 8" CMU WALL 9'-0" WIDE BY CLEAR OPENING TO CEILING. CASED STEEL JAMB OPENINGS WITH STEEL PLATE AND ANGLES SAME AS NEW ROLL-UP DOOR JAMB.
4. CONSTRUCT NEW 8" CMU WALL WITH JOINT REINFORCEMENT EVERY SECOND COURSE FULL HEIGHT FROM EXISTING FLOOR TO BOTTOM OF EXISTING METAL ROOF DECK.
5. FIELD MEASUREMENTS FOR ALL TYPES OF DOORS: THE CONTRACTOR SHALL VERIFY ALL MEASUREMENTS AT THE BUILDING SITE AND SHALL BE RESPONSIBLE FOR CORRECTION, FITTING, AND THE PROPER ATTACHMENT OF SAME. DIRECTLY CONNECTED WITH THE DOOR INSTALLATION.
6. WALL AND CEILING INSULATION USED IN CONNECTION WITH CORRUGATED SHEET METAL SIDING AND ROOFING SHALL BE APPROVED BY THE BASE FIRE DEPT. (DEPT) PRIOR TO DELIVERING ON THE JOB SITE. SUBMIT SAMPLES TO THE CONTRACTING OFFICER FOR APPROVAL.

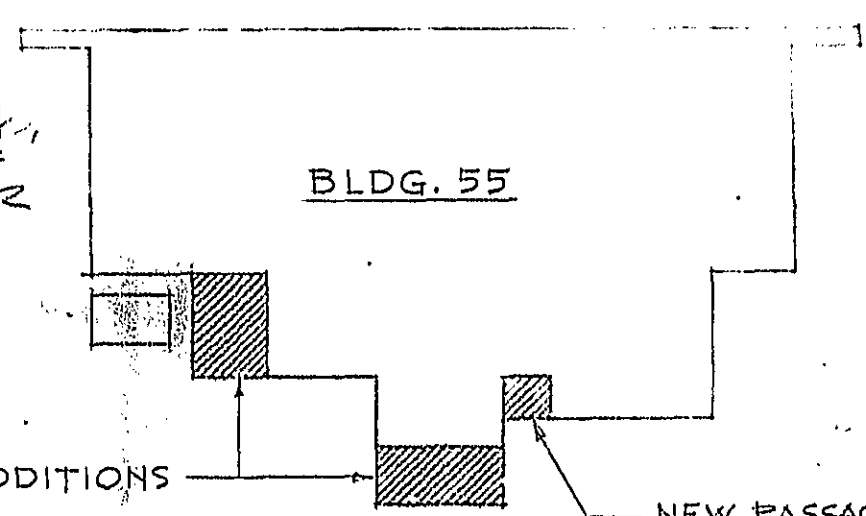


KEY PLAN
SC: 1" = 50'-0"

SEE SHEET 1 OF 31 FOR APPROVED SIGNATURES

NO.	UNIT	DESIGNED	DRAWN	CHECKED
1	KG	1/21/89	1/21/89	1/21/89
2	KG	1/21/89	1/21/89	1/21/89
3	KG	1/21/89	1/21/89	1/21/89
4	KG	1/21/89	1/21/89	1/21/89
5	KG	1/21/89	1/21/89	1/21/89


APPROVED		NAME		TITLE	
31					
USING AGENCY					
WARNER ROBINS ALC CIVIL ENGINEERING DIVISION ROBINS AIR FORCE BASE, GEORGIA					
ADAL A/C MAINTENANCE FACILITY NEW ADDITIONS AND ALTERATIONS BLDG 55 FLOOR PLAN AND ELEVATIONS (ARCHITECTURAL)					

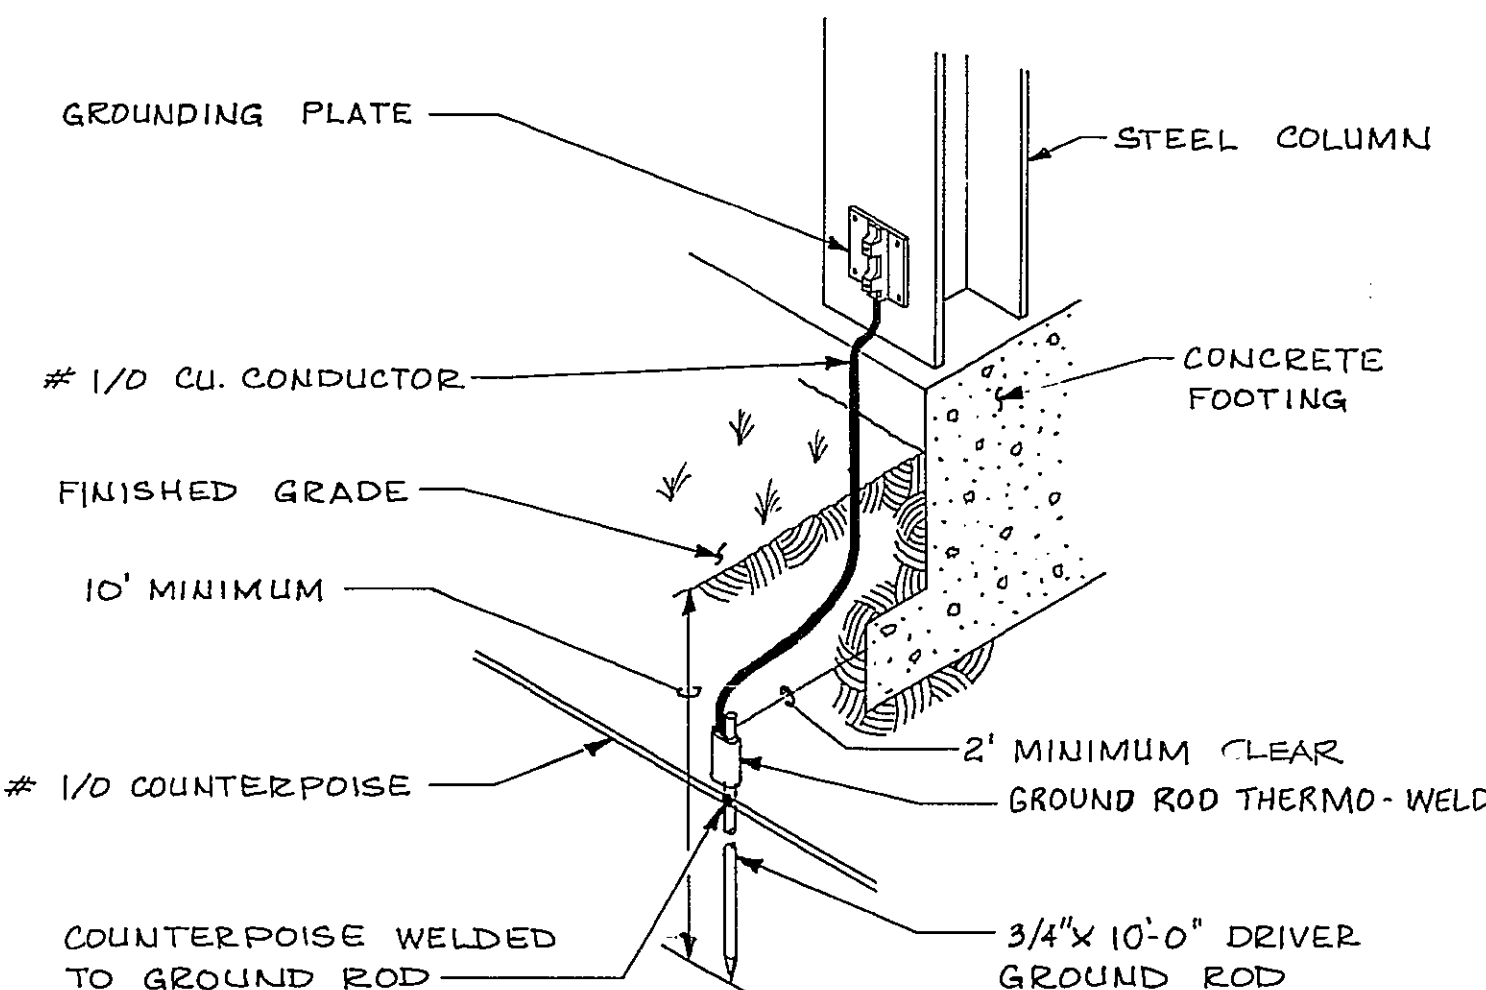

COLUMN BOND DETAIL
NO SCALE

27
E-3 E-22
E-7
E-11
E-15
E-19

NOTE: ELECTRICAL PANEL SHALL BE BOLTED TO THE CHANNEL. THE CHANNEL SHALL BE WELDED TO THE COLUMN.

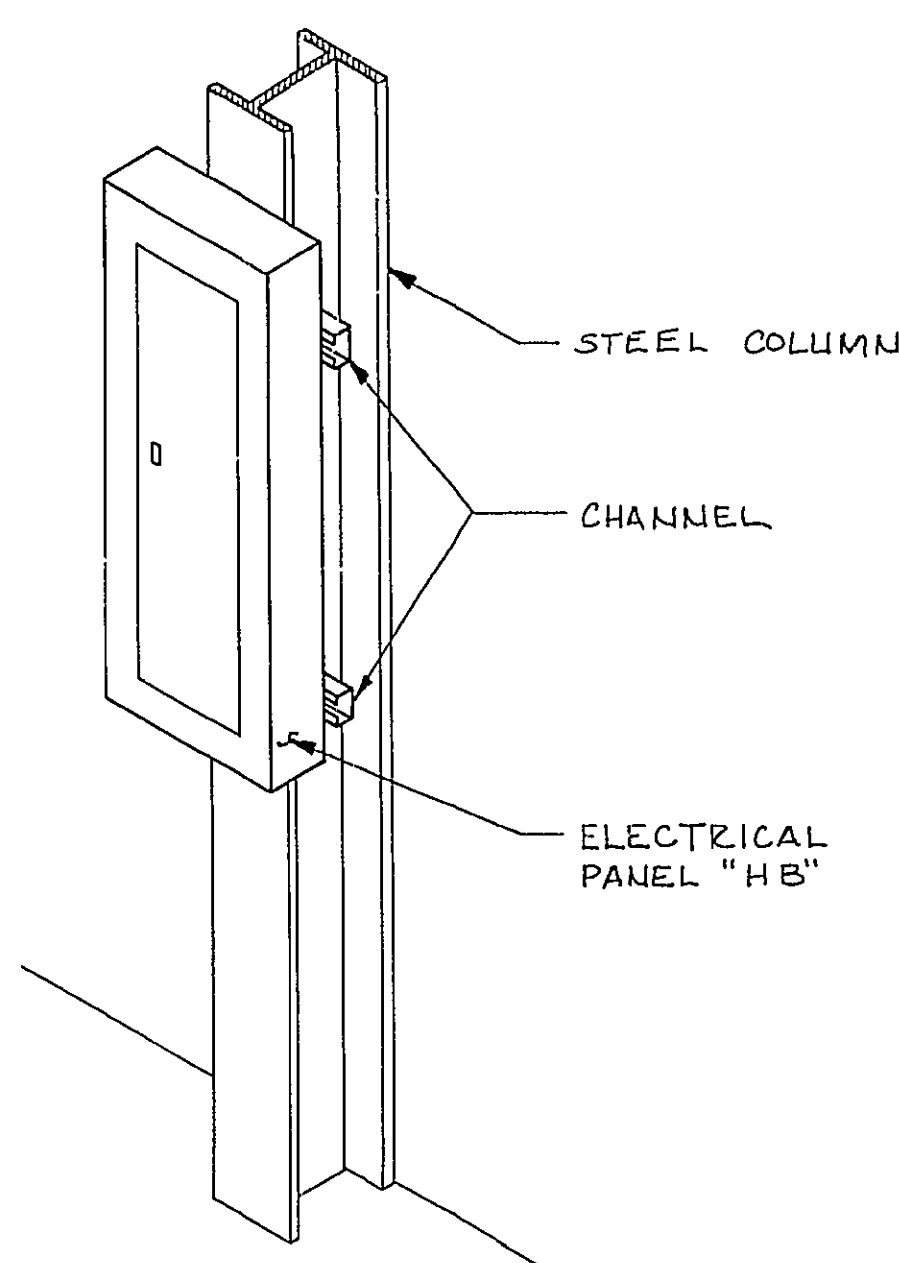


ELECTRICAL PANEL MOUNTING DETAIL
NO SCALE

28
E-2 E-22
E-6
E-10
E-14
E-18


NOTES (UNIQUE FOR 500 KVA PAD MTD. TRANSF. PAD DETAIL):

1. THESE DIMENSIONS ARE STANDARD FOR ALL SIZES.
2. CONNECT ALL GROUND RODS WITH #10 COUNTERPOISE AND TIE THIS SYSTEM INTO THE MAIN LIGHTNING PROTECTION SYSTEM.
3. PROVIDE PAD PER MANUFACTURER'S SPECIFICATIONS.

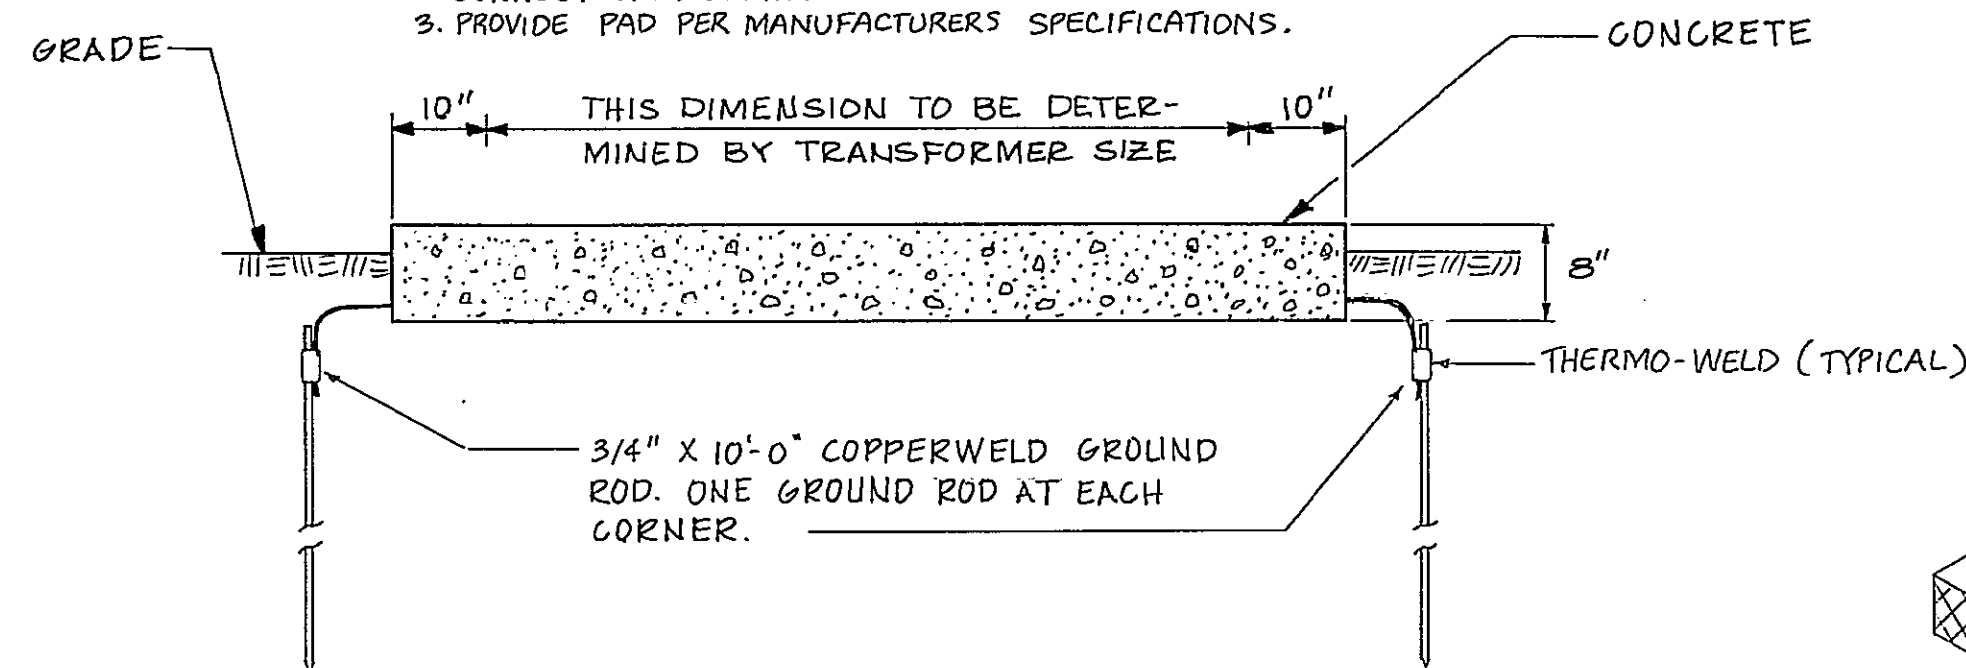

500 KVA PAD MOUNTED TRANSFORMER - PAD DETAIL
NO SCALE

30
E-1 E-22
E-5

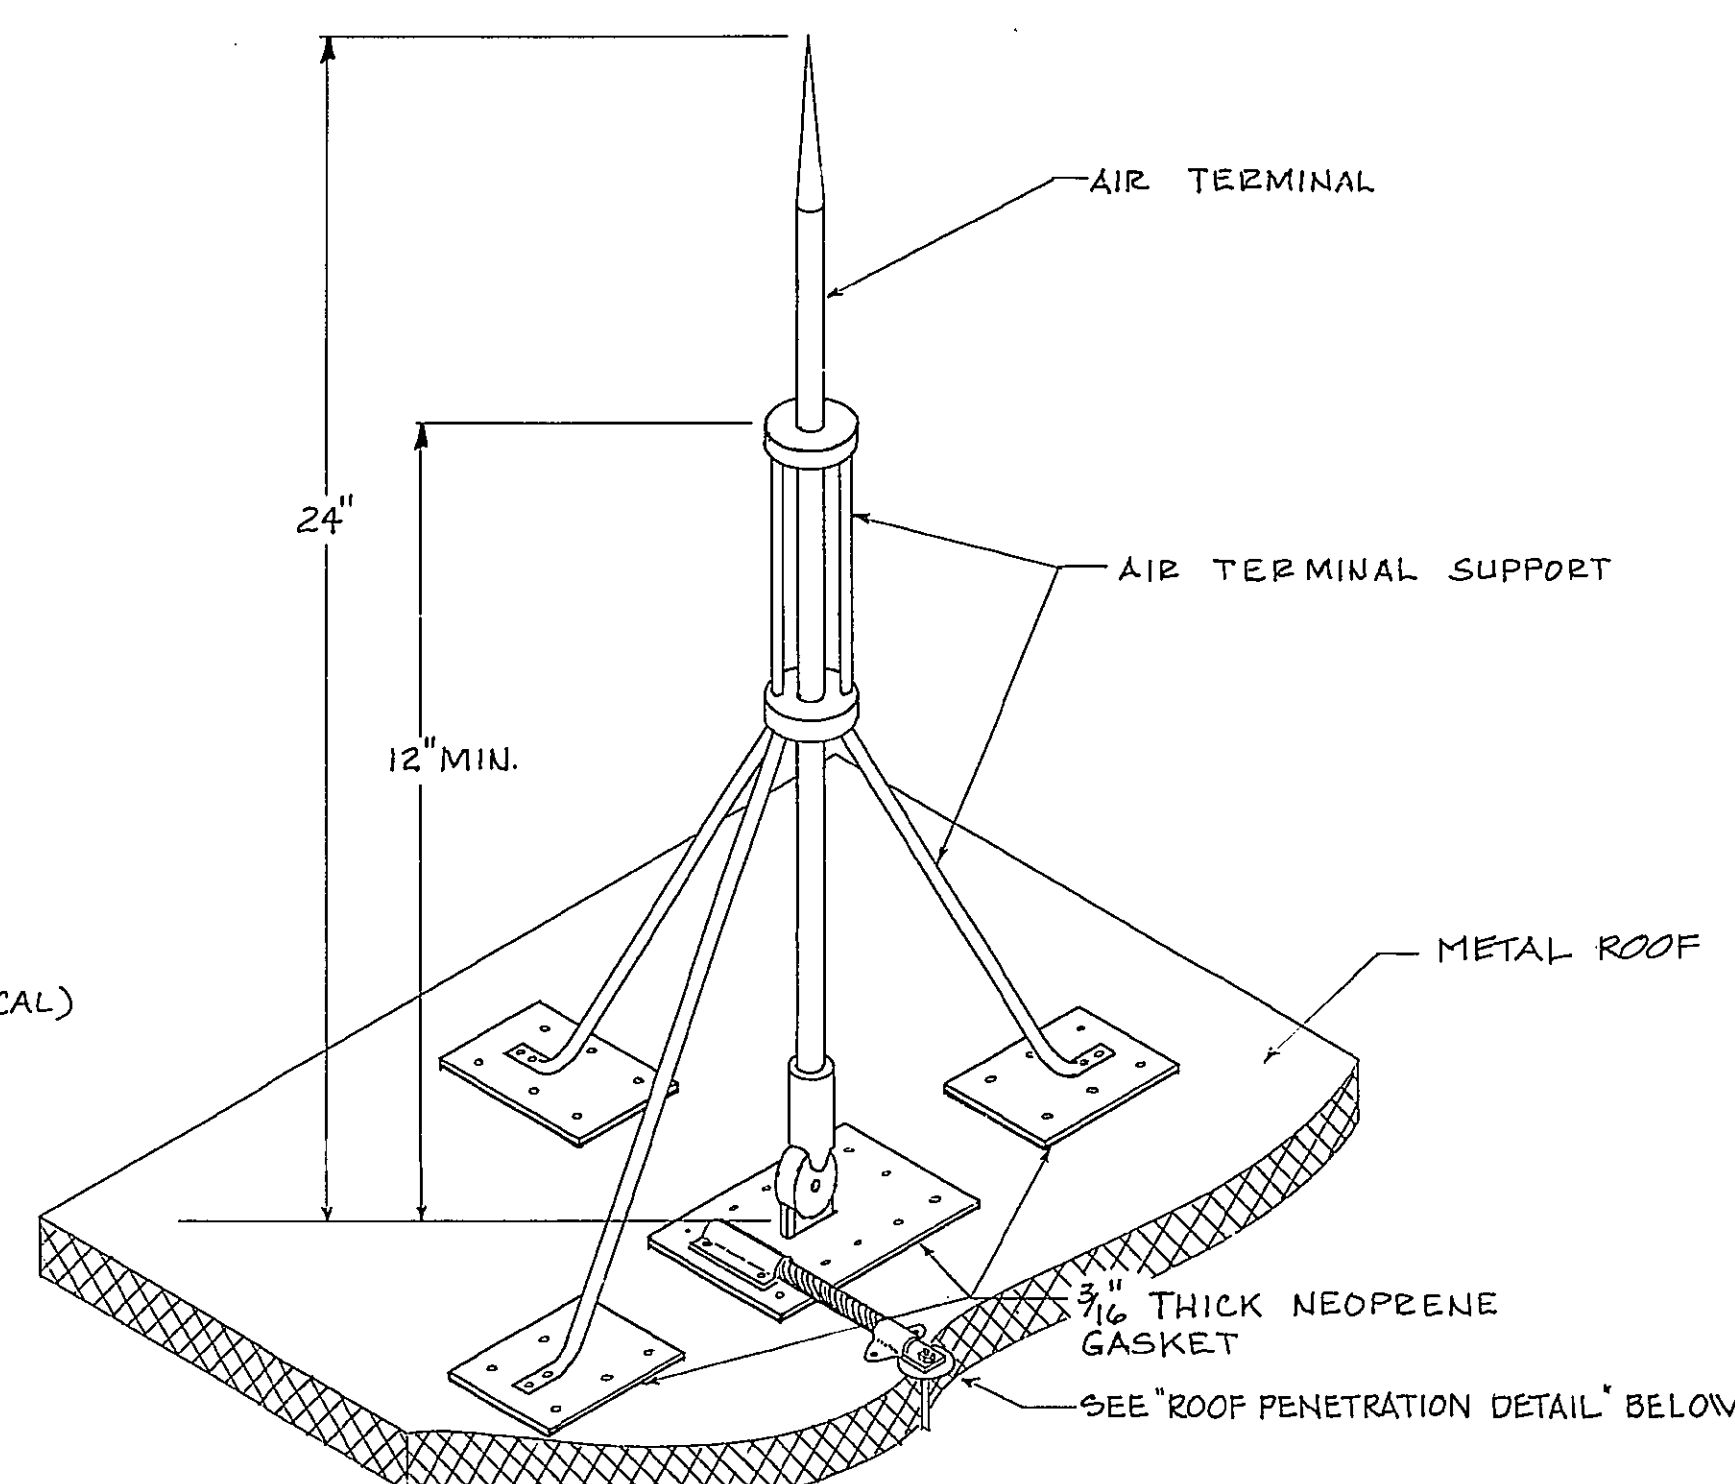


AIR TERMINAL SUPPORT DETAIL
NO SCALE

32
E-3 E-22
E-7
E-11
E-15
E-19

NOTES (UNIQUE FOR FLOOR JUNCTION BOX DETAIL):

1. CONDUIT AND JUNCTION BOX SHALL BE COATED WITH A WEATHERPROOF SEALER BEFORE CASTING IN CONCRETE.
2. THE CONCRETE SHOWN SHALL BE CONSIDERED PART OF THE FLOOR SLAB, IF APPLICABLE.

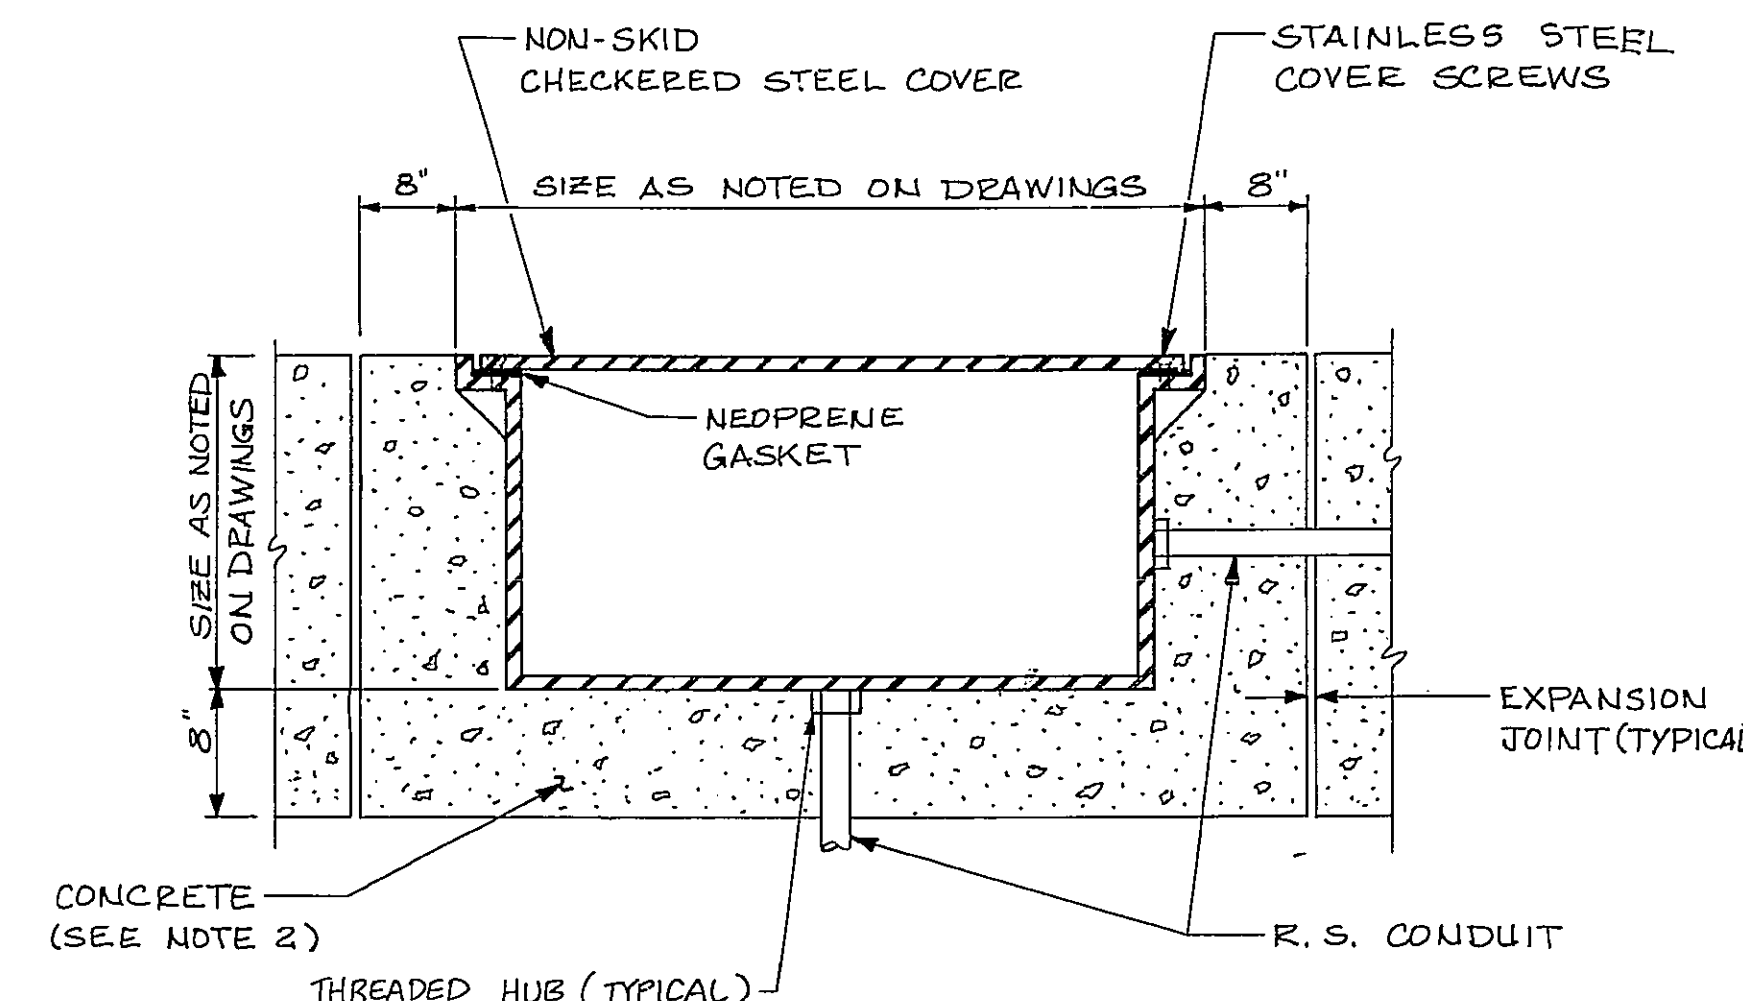


FLOOR JUNCTION BOX DETAIL
NO SCALE

34
E-2 E-22
E-6
E-10
E-14
E-18


NOTES (UNIQUE FOR BUILDINGS 44 & 55 OUTLET RELOCATION DETAIL):

1. CUT EXISTING CONDUIT AND INSTALL IN NEW JUNCTION BOX. A SUFFICIENT AMOUNT OF THE EXISTING CONDUCTORS SHALL BE LEFT IN THE NEW JUNCTION BOX SO THE NEW AND EXISTING CONDUCTORS CAN BE TAPPED TOGETHER.

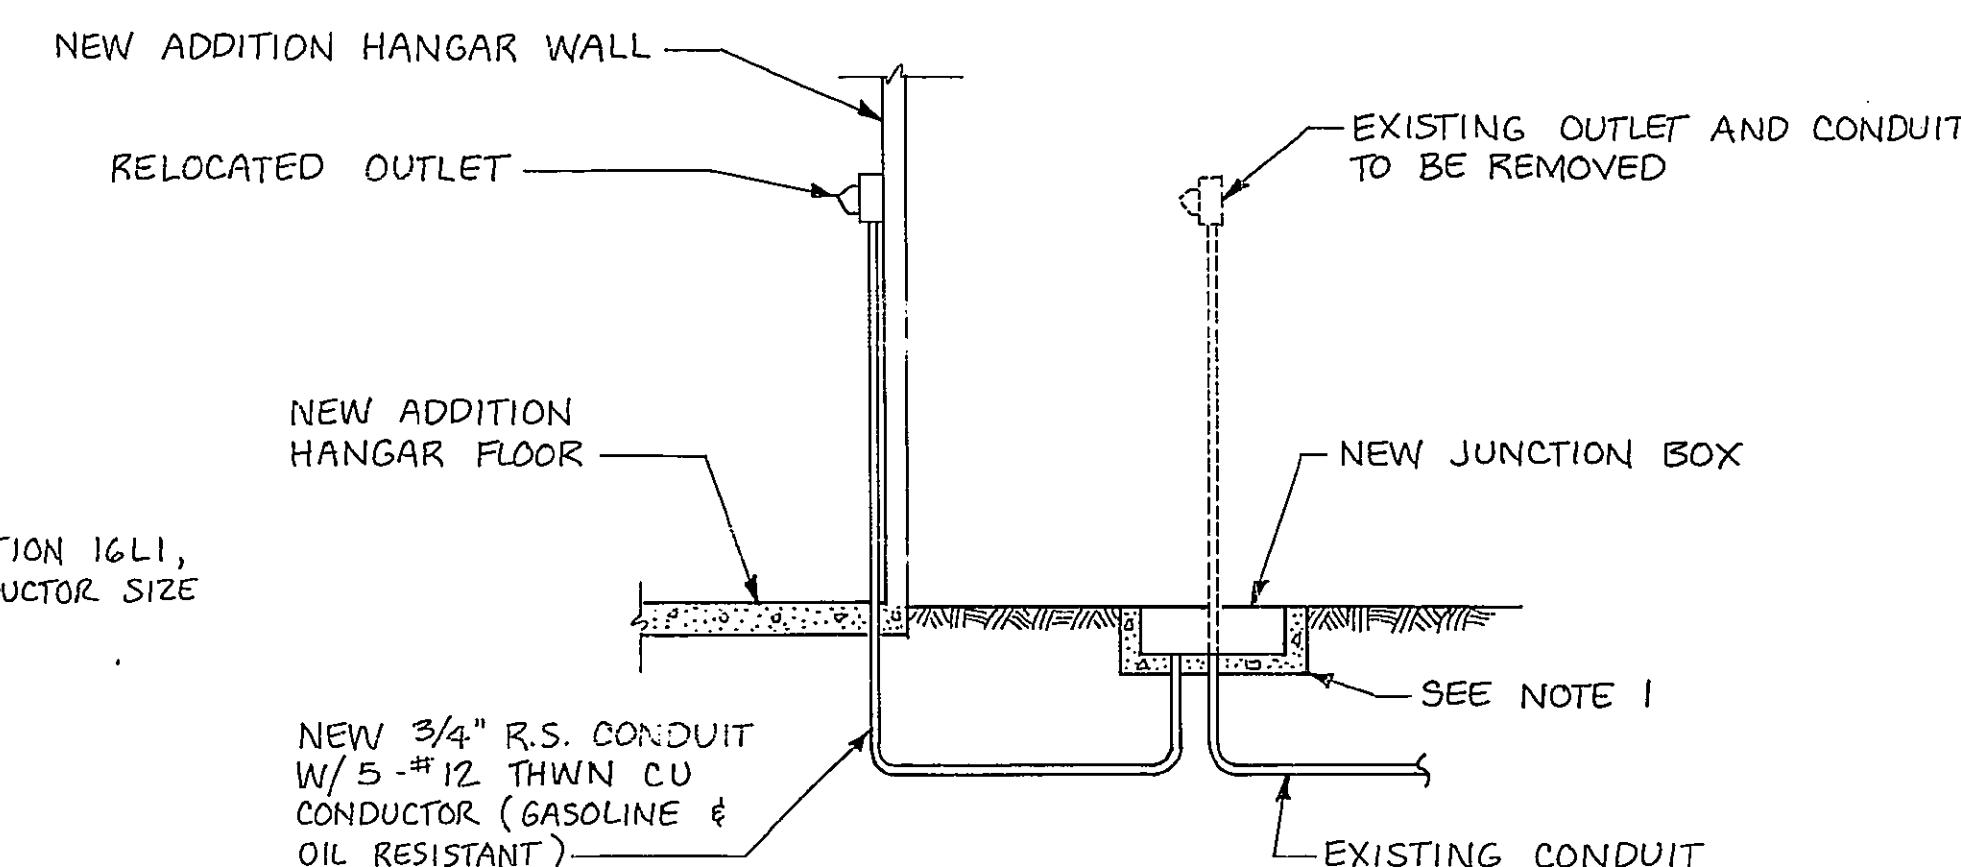


BUILDINGS 44 & 55 OUTLET RELOCATION DETAIL
NO SCALE

35
E-2 E-22
E-6

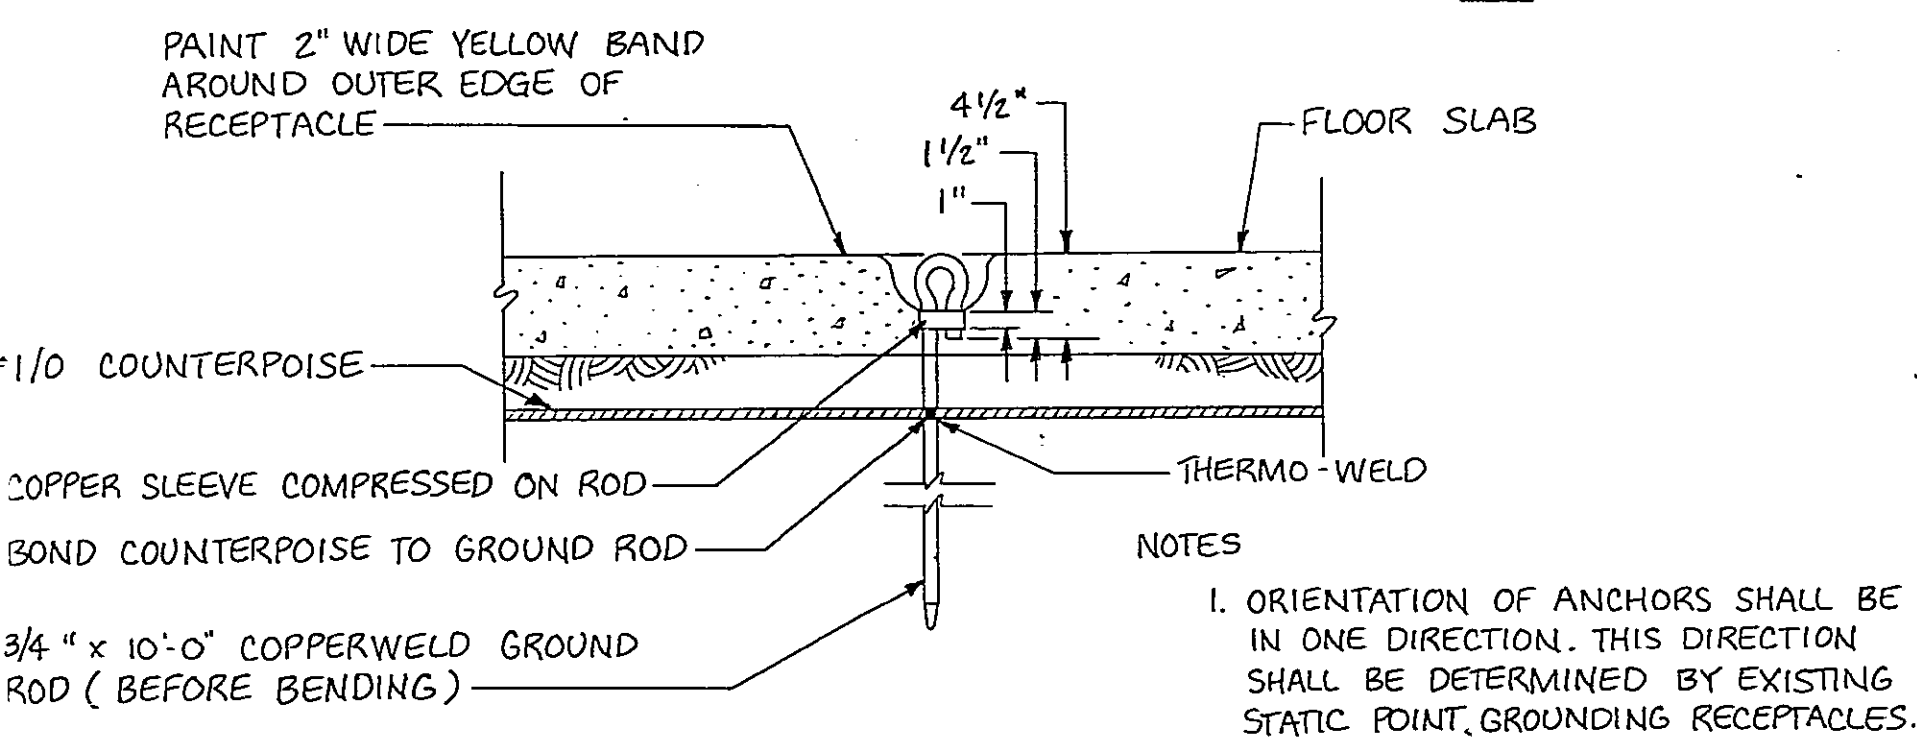

GROUNDING RECEPTACLE & ROD DETAIL
NO SCALE

29
E-3 E-22
E-7
E-11
E-15
E-19

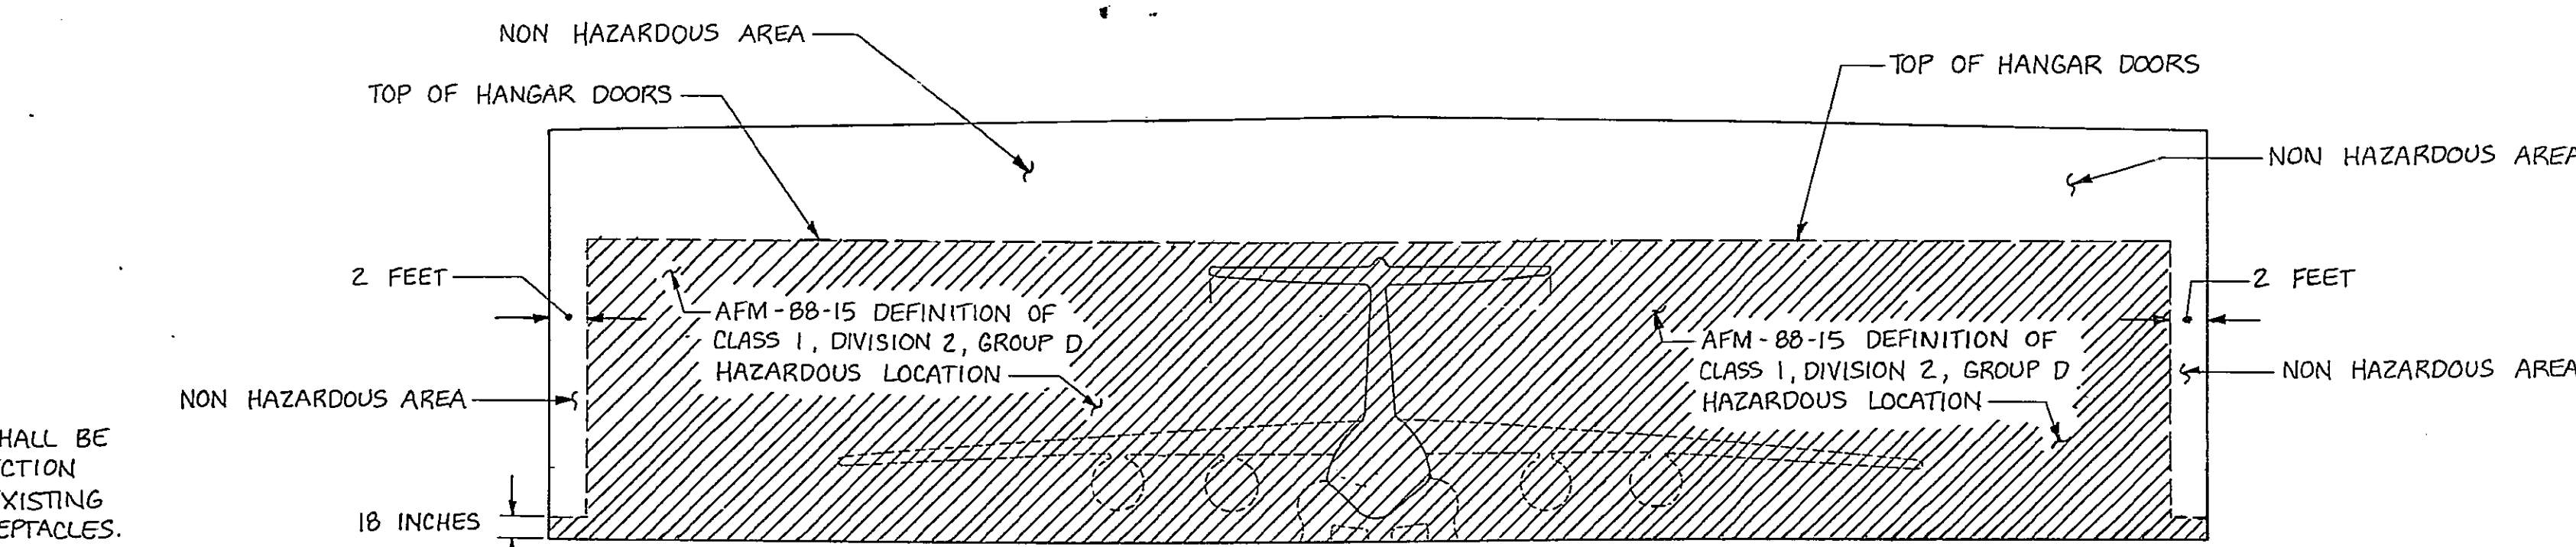

NOTES (UNIQUE FOR HAZARDOUS LOCATION ELEVATION):


1. AFM-88-15 HAZARDOUS LOCATION BOUNDRIES FOR CLASS 1, DIVISION 2, GROUP D ARE DEFINED AS THE FOLLOWING:
 - a) 18 INCHES MINIMUM ABOVE THE FINISHED FLOOR
 - b) 2 FEET MAXIMUM FROM HANGAR WALLS
 - c) TOP OF THE HANGAR DOORS

HAZARDOUS LOCATION ELEVATION
NO SCALE

37
E-2 E-22
E-6
E-10
E-14
E-18

LIGHTNING PROTECTION ROOF PENETRATION DETAIL
NO SCALE

33
E-3 E-22
E-7
E-11
E-15
E-19

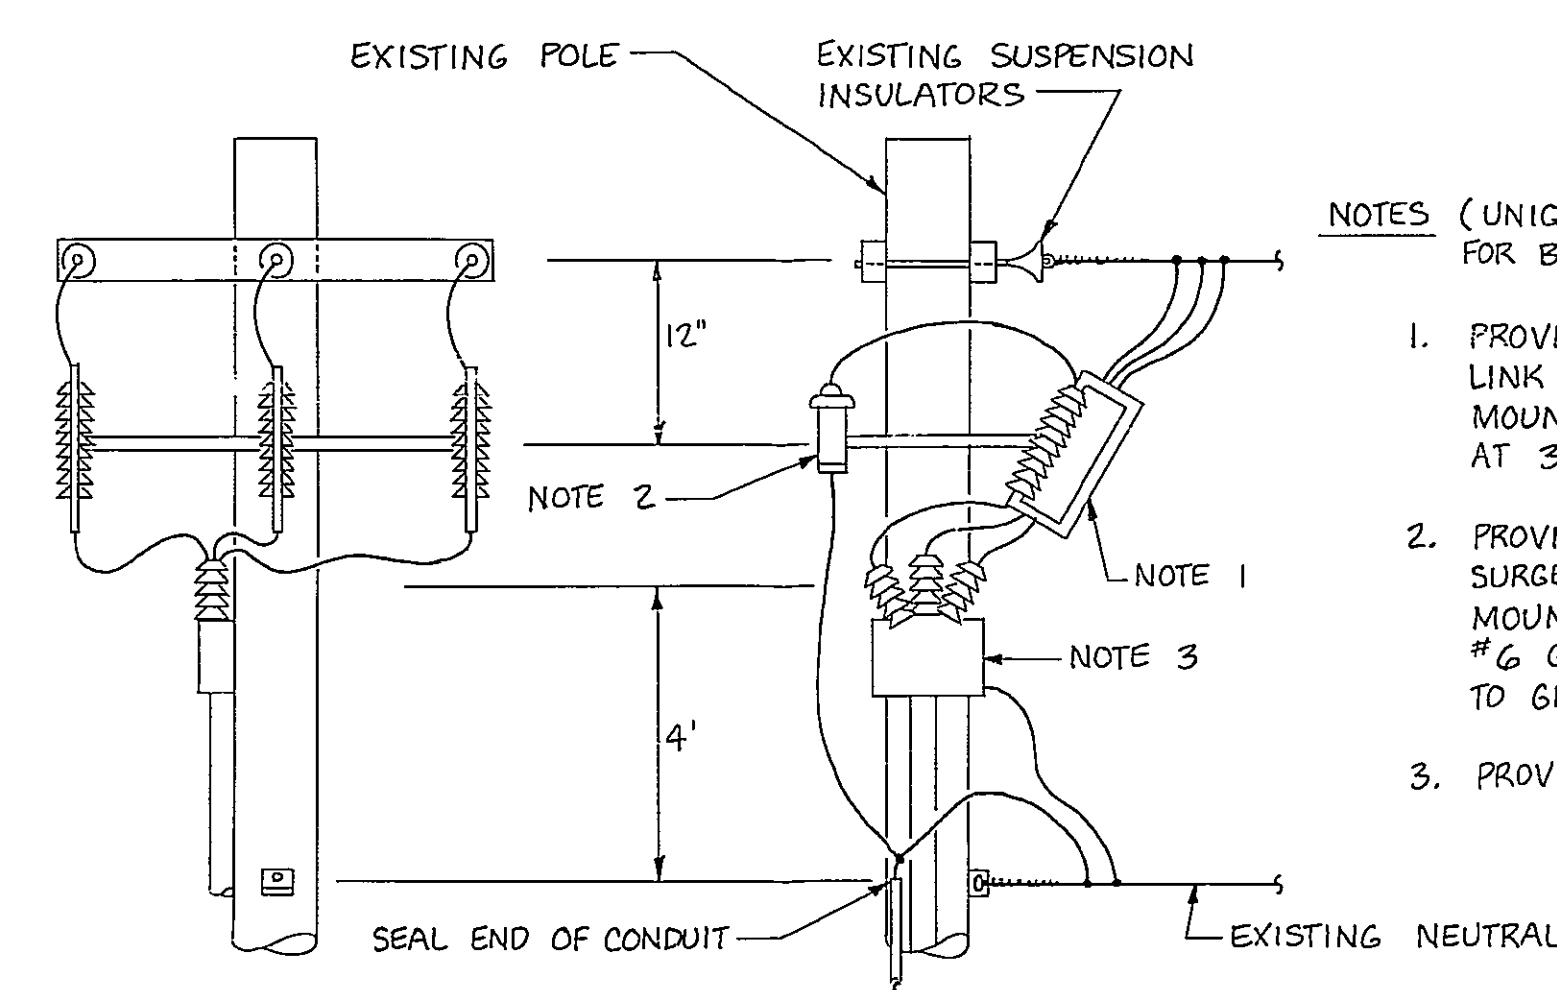

POLE DETAIL FOR BLDG'S 44 & 55
NO SCALE

36
P-2 E-22

NOTES (UNIQUE FOR POLE DETAIL FOR BUILDINGS 44 AND 55):


1. PROVIDE 100 AMP, 15 KV DROP LINK FUSED CUTOUPS AND MOUNTING HARDWARE. FUSE AT 32 AMPS.
2. PROVIDE 15 KV DISTRIBUTION SURGE ARRESTORS AND MOUNTING HARDWARE, PROVIDE #6 GROUND CONDUCTOR TO GROUND RODS.
3. PROVIDE 15 KV POTHEAD

WURZ, WISECARVER & PRUETT ARCHITECTS - ENGINEERS ATLANTA, GEORGIA		U. S. ARMY ENGINEER DISTRICT, SAVANNAH CORPS OF ENGINEERS SAVANNAH, GEORGIA	
NOSE DOCK EMPENNAGE ENCLOSURE			
ELECTRICAL DETAILS			
ROBINS AIR FORCE BASE		GEORGIA	
SIZE	INVTATION NO.	DRAWING NO.	PLATE
F	DACA21-85-B-0090	39-01-08	E-22
SCALE: AS SHOWN		SHEET 99	

SYMBOL	ZONE	DESCRIPTION	DATE	BY
REVISIONS				

NOTES (UNIQUE FOR "DETAIL LIGHT FIXTURE TYPE "A" "):

1. LIGHT FIXTURE SHALL BE SECURELY MOUNTED TO THE HANGAR WALL AS PER MANUFACTURERS REQUIREMENTS.
2. ALL LIGHTS OF THIS TYPE SHALL HAVE A PHOTO SWITCH.
3. MOUNTING HEIGHTS FOR BUILDINGS 44, 55, 47, 48 AND 49 SHALL BE 10 FEET.
4. FIXTURE TYPE "A"* DENOTES 120 V. FIXTURE.

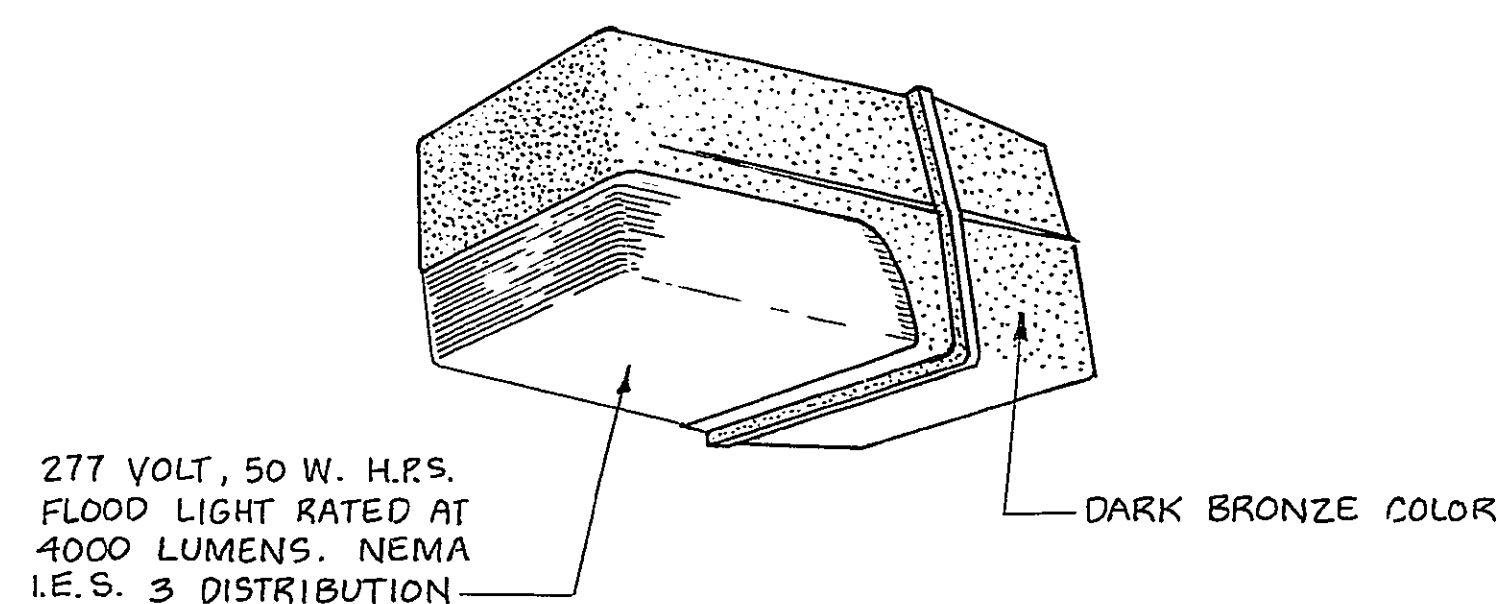


DETAIL LIGHT FIXTURE TYPE "A"
NO SCALE

20
E-1
E-2
E-5
E-6
E-9
E-10
E-13
E-14
E-17
E-18

NOTES (UNIQUE FOR "DETAIL LIGHT FIXTURE TYPE "C" "):

1. LIGHT FIXTURE SHALL BE SECURELY MOUNTED TO THE HANGAR WALL AS PER MANUFACTURERS REQUIREMENTS.
2. ALL LIGHTS OF THIS TYPE SHALL BE CONTROLLED AS NOTED ON THE PLANS.
3. MOUNTING HEIGHTS FOR BUILDINGS 44, 55, 47, 48 AND 49 SHALL BE 50 FEET.

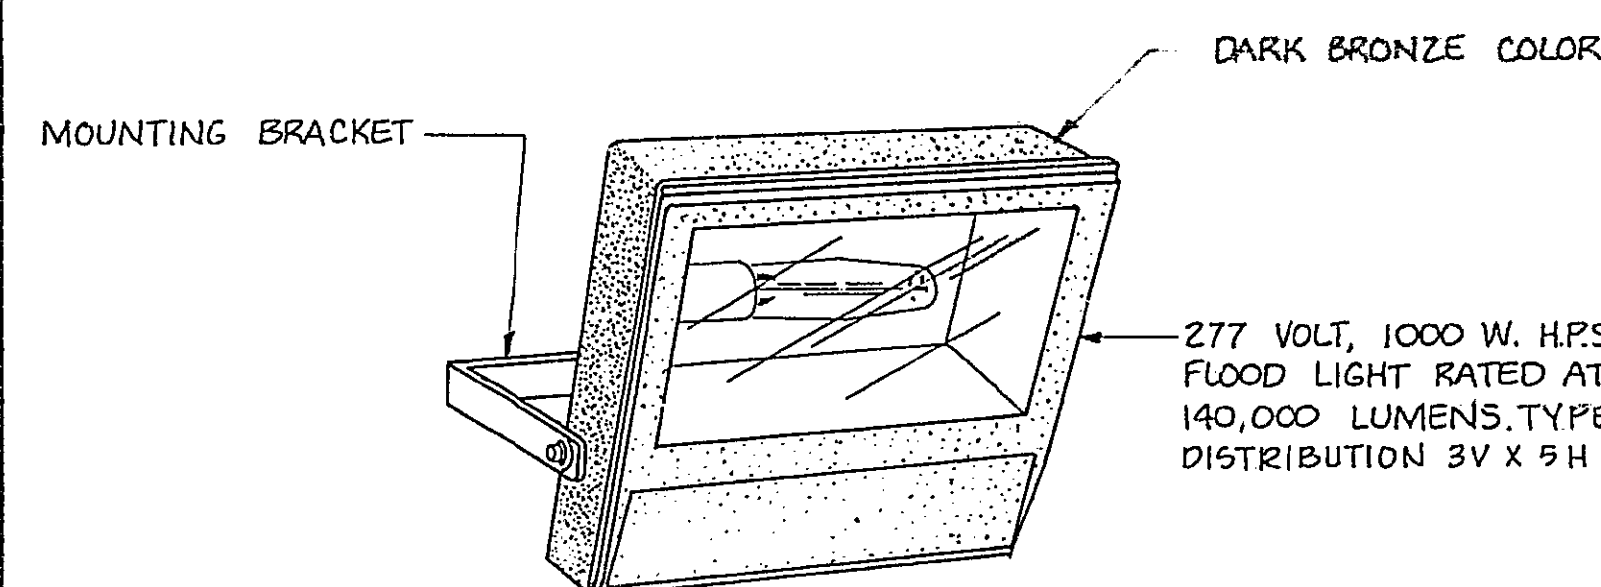


DETAIL LIGHT FIXTURE TYPE "C"
NO SCALE

21
E-2
E-5
E-6
E-10
E-14
E-18

NOTES (UNIQUE FOR "EXIT LIGHT TYPE "X" "):

1. 1 1/2 HOURS OF LIGHT TO AN END VOLTAGE OF 87 1/2 % OF NORMAL.
2. EXIT LIGHTS SHALL BE MOUNTED 1 FOOT ABOVE THE DOOR TOP.

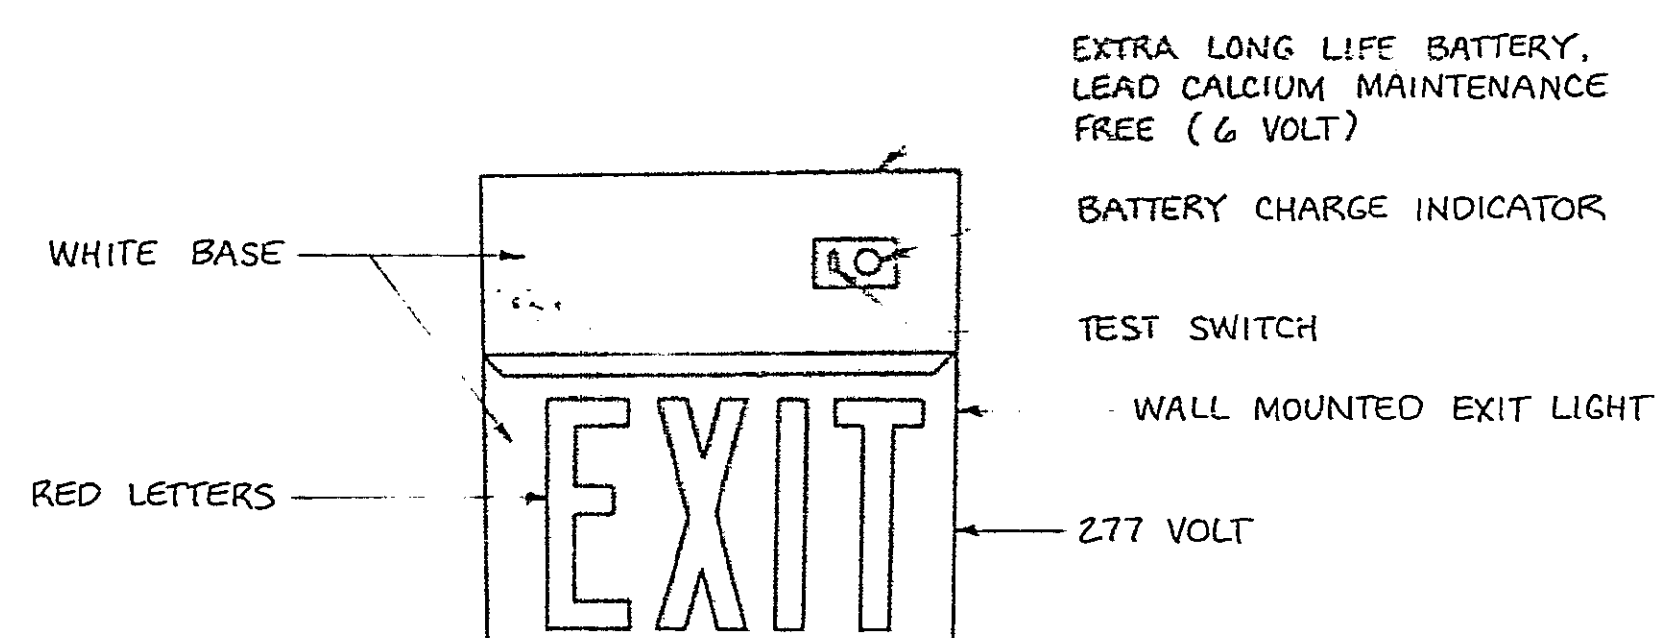


EXIT LIGHT TYPE "X"
NO SCALE

22
E-2
E-5
E-6
E-10
E-14
E-18

NOTES (UNIQUE FOR "DETAIL LIGHT FIXTURE TYPE "B" "):

1. TYPE "B"* FIXTURE DENOTES QUARTZ RESTRIKE OPTION.
2. THE FIXTURE BOTTOM SHALL BE MOUNTED AT THE SAME HEIGHT AS THE BOTTOM OF THE ROOF JOIST. THIS SHALL DETERMINE THE MOUNTING HEIGHT FOR THIS FIXTURE.

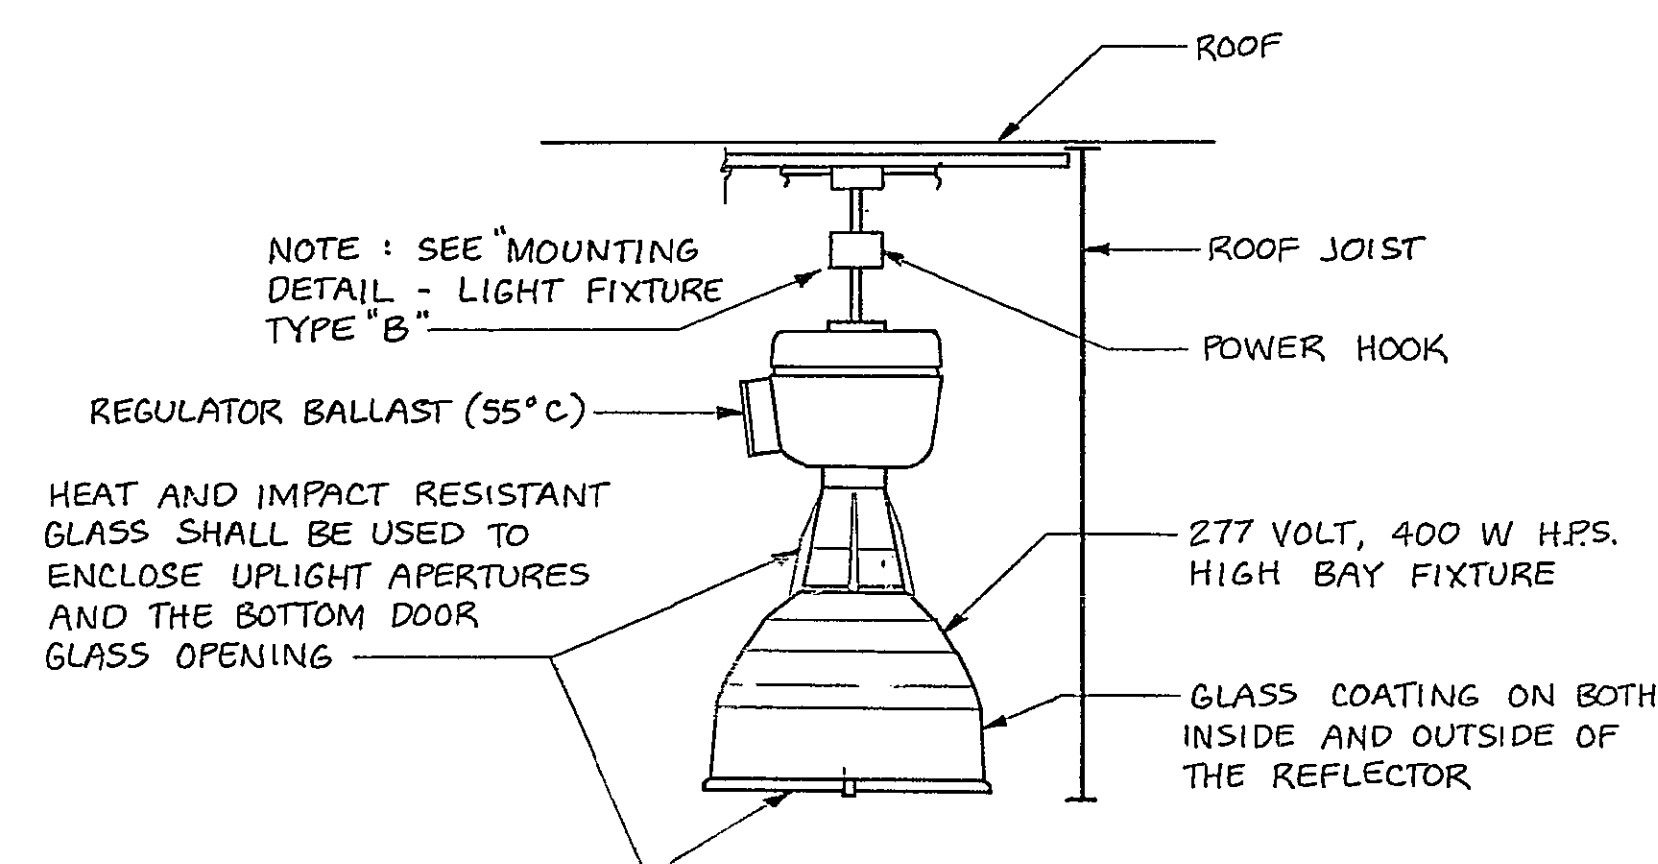


DETAIL LIGHT FIXTURE TYPE "B"
NO SCALE

23
E-2
E-21
E-6
E-10
E-14
E-18

NOTES (UNIQUE FOR "DETAIL LIGHT FIXTURE TYPE "D" "):

1. LIGHT FIXTURE SHALL BE SECURELY MOUNTED TO THE HANGAR WALL AS PER MANUFACTURERS REQUIREMENTS.
2. ALL LIGHTS OF THIS TYPE SHALL HAVE A PHOTO SWITCH.
3. FIXTURE TYPE "D"* DENOTES 120 VOLT FIXTURE.
4. MOUNTING HEIGHTS FOR BUILDINGS 55, 47, 48 AND 49 SHALL BE 25 FEET.

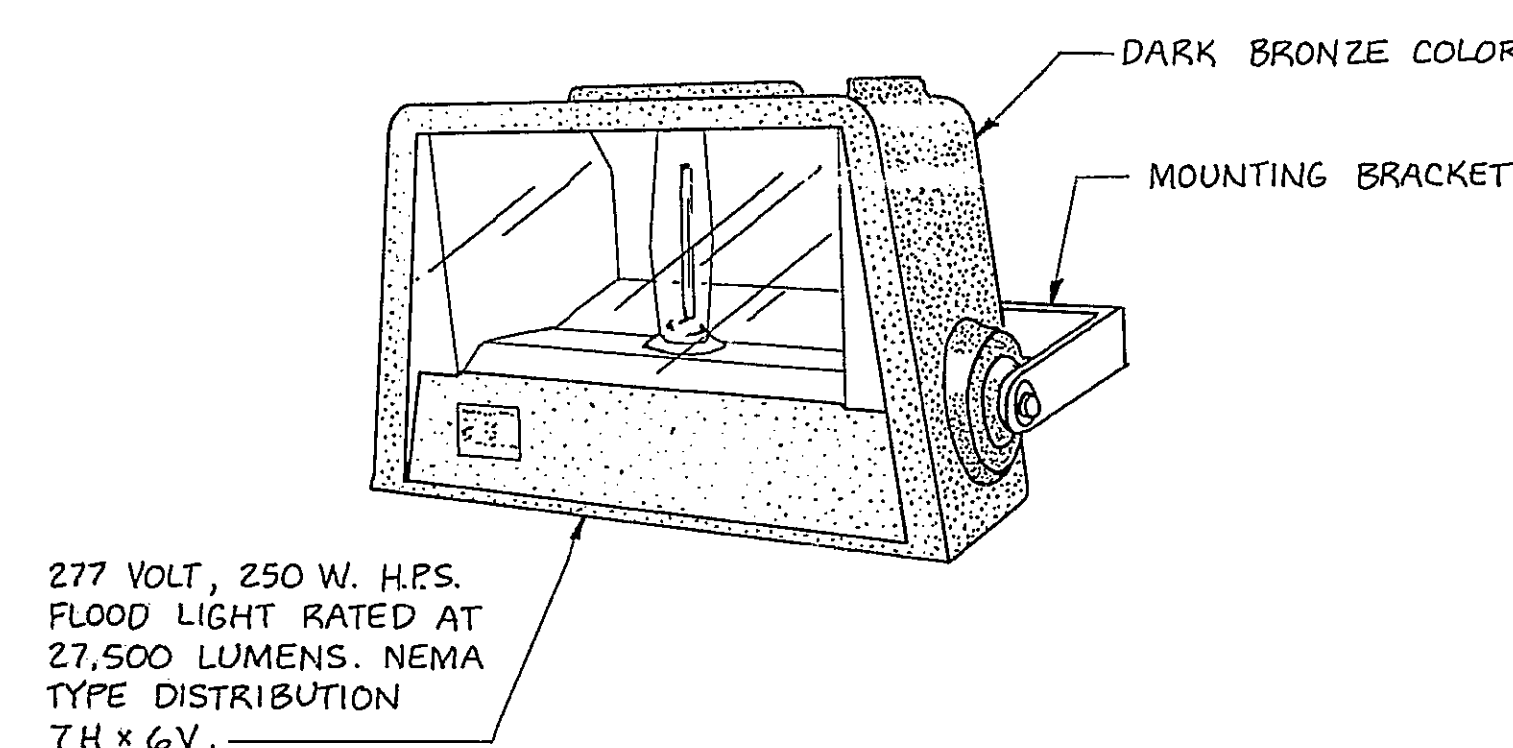


DETAIL LIGHT FIXTURE TYPE "D"
NO SCALE

24
E-5
E-21
E-6
E-10
E-14
E-17

NOTES (UNIQUE FOR "MOUNTING DETAIL LIGHT FIXTURE TYPE "B" "):

1. STEEL CHANNEL SHALL BE INSTALLED BETWEEN BAR JOISTS. BEAM CLAMPS SHALL BE USED TO SUPPORT CHANNEL TO BAR JOIST.
2. THE JUNCTION BOX THAT SUPPORTS LIGHT FIXTURE TYPE "B" SHALL BE SECURELY SUPPORTED TO CHANNEL.

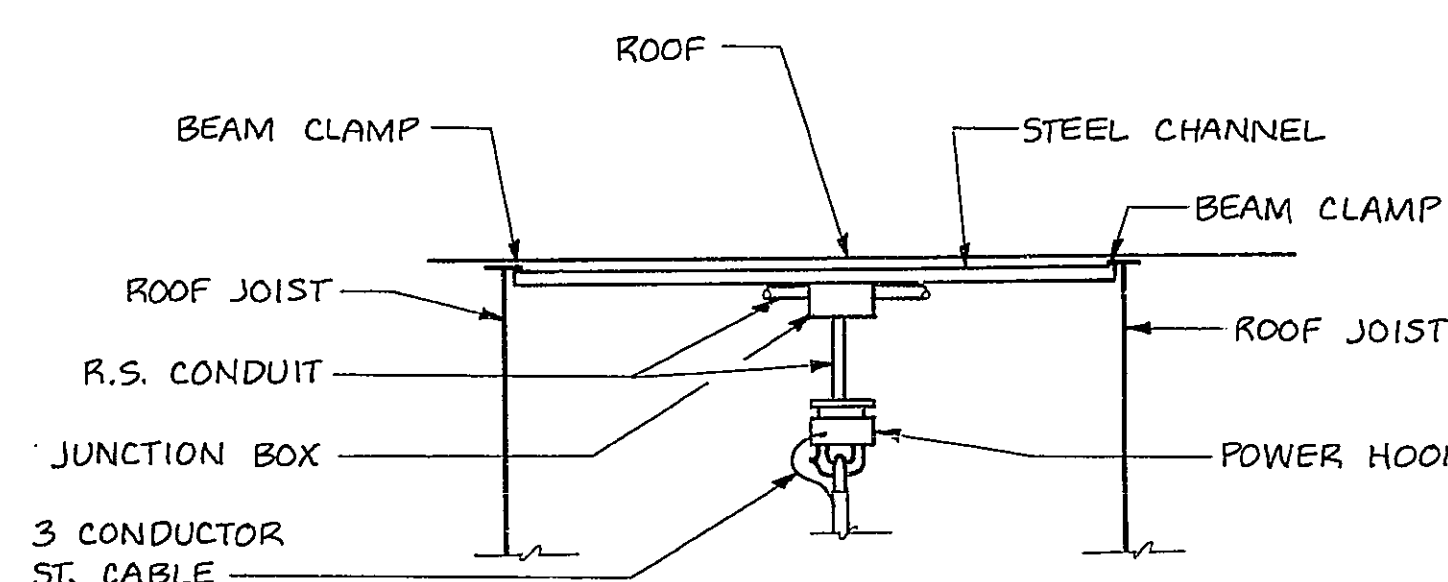


MOUNTING DETAIL LIGHT FIXTURE TYPE "B"
NO SCALE

25
E-2
E-21
E-6
E-10
E-14
E-18

NOTES (UNIQUE FOR "EMERGENCY BATTERY PACK LIGHT FIXTURE DETAIL"):

1. 1 1/2 HOURS OF LIGHT TO AN END VOLTAGE OF 87 1/2 % OF NORMAL.
2. MOUNTING HEIGHT FOR THIS FIXTURE SHALL BE 12 FEET A.F.F.

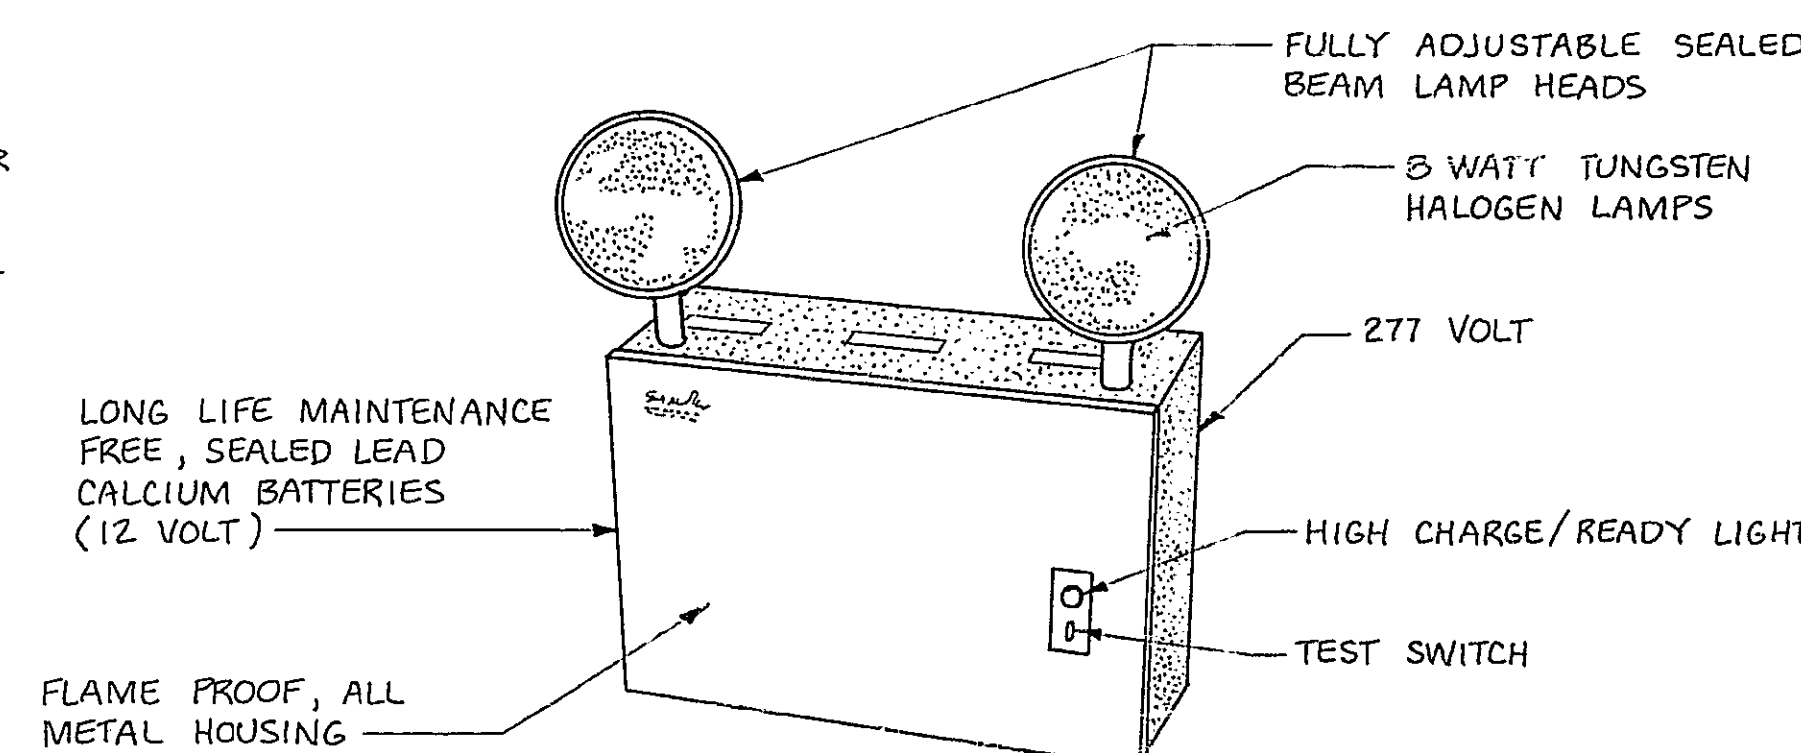

EMERGENCY BATTERY PACK LIGHT FIXTURE DETAIL
NO SCALE


26
E-2
E-21
E-6
E-10
E-14
E-18

ELECTRICAL LEGEND

DEMOLITION	EXISTING	NEW	DESCRIPTION
		○ _A	CEILING LIGHTING OUTLET - SUBSCRIPT DESIGNATES NEW FIXTURE TYPE
		○ _A	WALL LIGHTING OUTLET - SUBSCRIPT DESIGNATES NEW FIXTURE TYPE
		⏏	EMERGENCY BATTERY PACK LIGHT FIXTURE
		ⓐ	JUNCTION BOX
		ⓐ	FLOOR JUNCTION BOX
		ⓧ _x	WALL MOUNTED EXIT LIGHT OUTLET - SUBSCRIPT DESIGNATES FIXTURE TYPE
		ⓐ	SPECIAL RECEPTACLE
		ⓐ	POWER PANEL
		---	UNDERGROUND DUCT LINE
		---	BRANCH CIRCUIT - CONCEALED IN OR BELOW FLOOR
		---	BRANCH CIRCUIT - EXPOSED
		ⓐ _{7 1/2}	MOTOR - SUBSCRIPT DESIGNATES HORSEPOWER
		ⓐ	DISCONNECT SWITCH
		ⓐ ₂	FIRE ALARM BELL
		ⓐ ₁	FIRE ALARM STATION, NUMBER RELATES RISER DIAGRAM TO PLAN
		ⓐ ₁	FIRE ALARM HORN, NUMBER RELATES RISER DIAGRAM TO PLAN
		ⓐ ₁	FIRE ALARM CENTRAL STATION
		---	LIGHTNING PROTECTION CIRCUIT - BURIED
		---	LIGHTNING PROTECTION CIRCUIT - CONCEALED
		ⓐ	AIR TERMINAL - LIGHTNING PROTECTION
		ⓐ	GROUND ROD - LIGHTNING PROTECTION
		ⓐ	GROUNDING RECEPTACLE
		ⓐ	SPRINKLER SYSTEM FLOW SWITCH

WURZ, WISECARVER & PRUETT ARCHITECTS ENGINEERS ATLANTA, GEORGIA		U.S. ARMY ENGINEER DISTRICT, SAVANNAH CORPS OF ENGINEERS SAVANNAH, GEORGIA	
NOSE DOCK EMPENNAGE ENCLOSURE			
LIGHTING FIXTURE DETAILS			
ROBINS AIR FORCE BASE		GEORGIA	
SIZE	INVESTIGATION NO.	DRAWING NO.	PLATE
1/4"	DATA 21 85 5 0090	39-01-08	E-21
SCALE AS SHOWN		SHEET 98	

SYMBOL	ZONE	DESCRIPTION	DATE	BY
		REVISIONS		

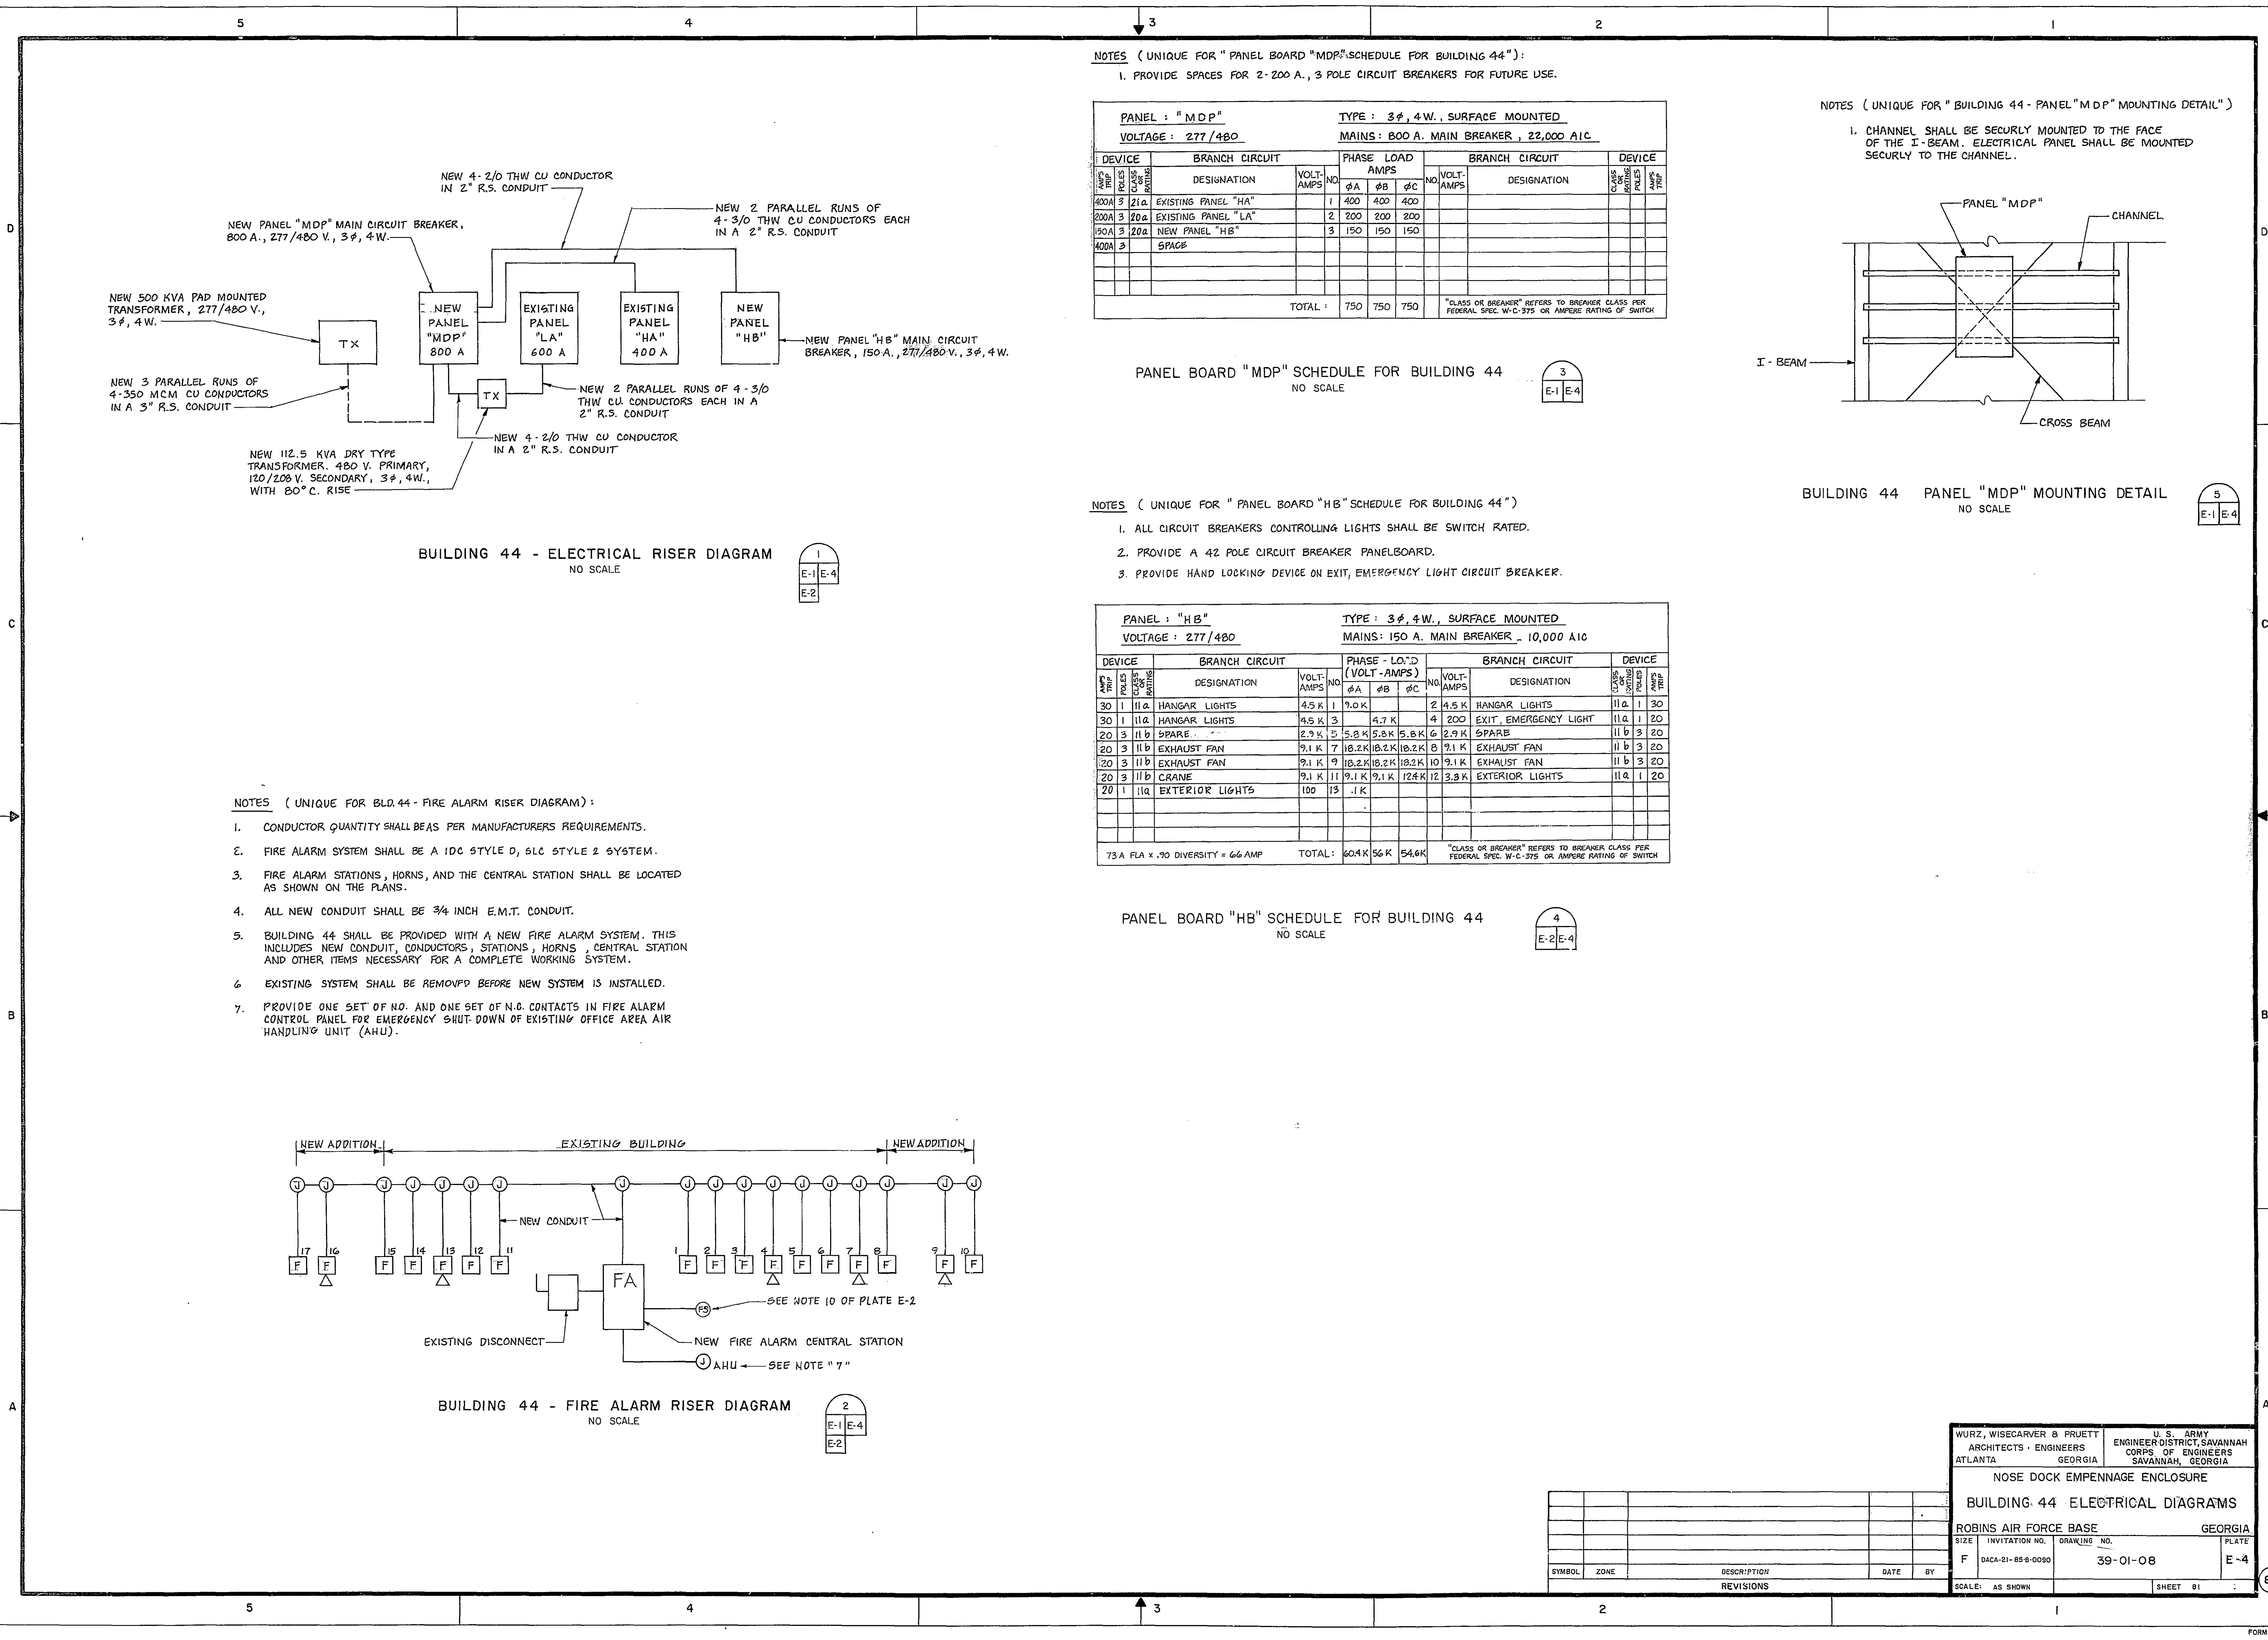


NOTES (UNIQUE FOR " PANEL BOARD "MDP" SCHEDULE FOR BUILDING 44"):

1. PROVIDE SPACES FOR 2-200 A., 3 POLE CIRCUIT BREAKERS FOR FUTURE USE.

PANEL : " MDP "										TYPE : 3 ϕ , 4 W., SURFACE MOUNTED									
VOLTAGE : 277 / 480										MAINS : 800 A. MAIN BREAKER , 22,000 AIC.									
NO.	CIRCUIT	DESIGNATION	VOLT-AMPS	NO.	PHASE LOAD AMPS			NO.	CIRCUIT	DESIGNATION	VOLT-AMPS	NO.	CIRCUIT	DESIGNATION	VOLT-AMPS	NO.	CIRCUIT	DESIGNATION	VOLT-AMPS
					ϕ A	ϕ B	ϕ C												
400A	3	21a	EXISTING PANEL "HA"	1	400	400	400												
200A	3	20a	EXISTING PANEL "LA"	2	200	200	200												
150A	3	20a	NEW PANEL "HB"	3	150	150	150												
400A	3		SPACE																
TOTAL :					750	750	750	"CLASS OR BREAKER" REFERS TO BREAKER CLASS PER FEDERAL SPEC. W-C-375 OR AMPERE RATING OF SWITCH											


PANEL BOARD "MDP" SCHEDULE FOR BUILDING 44

NO SCALE

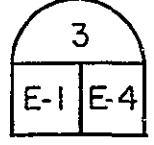


NOTES (UNIQUE FOR " BUILDING 44 - PANEL "MDP" MOUNTING DETAIL")

1. CHANNEL SHALL BE SECURLY MOUNTED TO THE FACE OF THE I-BEAM. ELECTRICAL PANEL SHALL BE MOUNTED SECURLY TO THE CHANNEL.

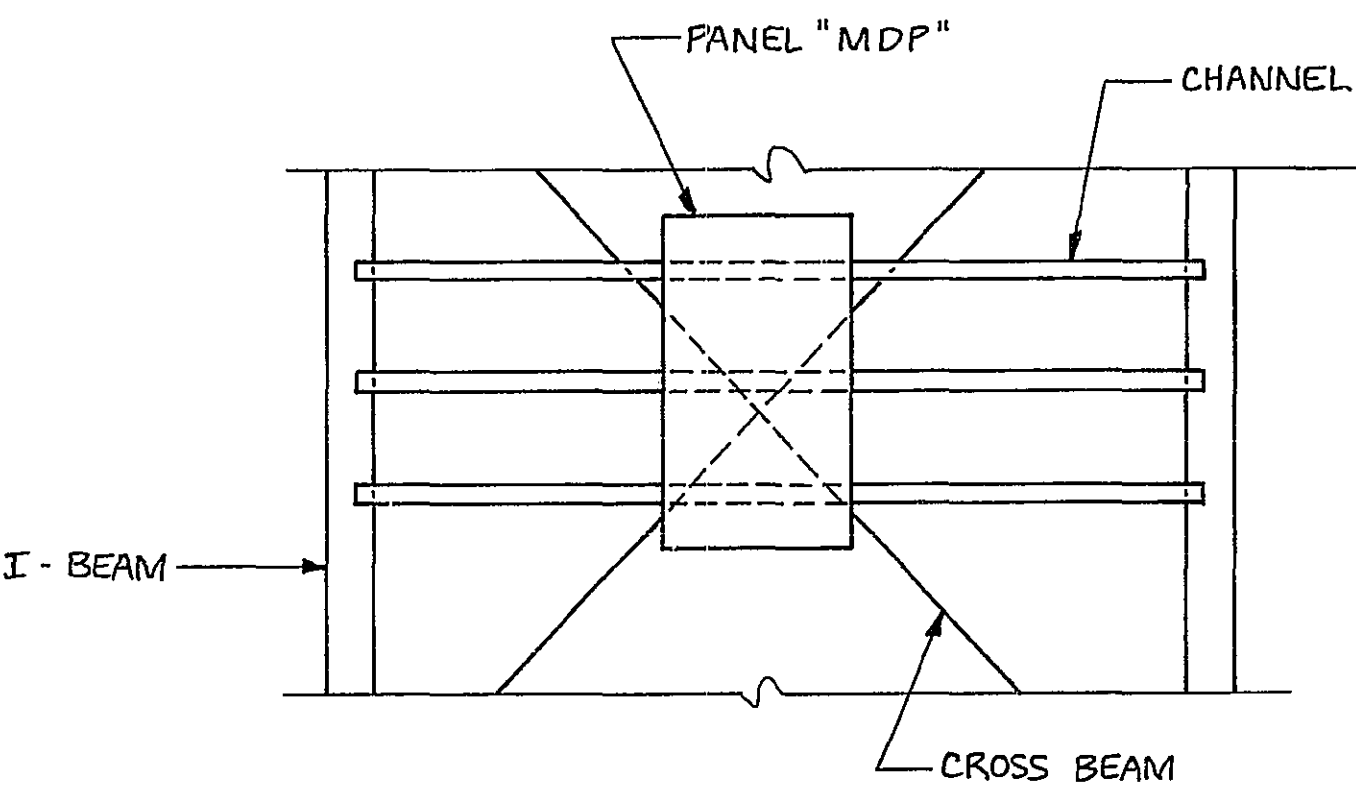

BUILDING 44 PANEL "MDP" MOUNTING DETAIL

NO SCALE

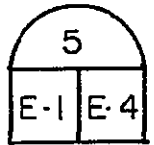

NOTES (UNIQUE FOR " PANEL BOARD "HB" SCHEDULE FOR BUILDING 44")

1. ALL CIRCUIT BREAKERS CONTROLLING LIGHTS SHALL BE SWITCH RATED.


2. PROVIDE A 42 POLE CIRCUIT BREAKER PANELBOARD.

3. PROVIDE HAND LOCKING DEVICE ON EXIT, EMERGENCY LIGHT CIRCUIT BREAKER.


PANEL : " HB "										TYPE : 3 ϕ , 4 W., SURFACE MOUNTED									
VOLTAGE : 277 / 480										MAINS : 150 A. MAIN BREAKER , 10,000 AIC									
NO.	CIRCUIT	DESIGNATION	VOLT-AMPS	NO.	PHASE LOAD (VOLT-AMPS)			NO.	CIRCUIT	DESIGNATION	VOLT-AMPS	NO.	CIRCUIT	DESIGNATION	VOLT-AMPS	NO.	CIRCUIT	DESIGNATION	VOLT-AMPS
					ϕ A	ϕ B	ϕ C												
30	1	11a	HANGAR LIGHTS	4.5 K	1	9.0 K		2	4.5 K	HANGAR LIGHTS	11a	1	30						
30	1	11a	HANGAR LIGHTS	4.5 K	3	4.7 K		4	200	EXIT, EMERGENCY LIGHT	11a	1	20						
20	3	11b	SPARE	2.9 K	5	5.8 K	5.8 K	6	2.9 K	SPARE	11b	3	20						
20	3	11b	EXHAUST FAN	9.1 K	7	18.2 K	18.2 K	8	9.1 K	EXHAUST FAN	11b	3	20						
20	3	11b	EXHAUST FAN	9.1 K	9	18.2 K	18.2 K	10	9.1 K	EXHAUST FAN	11b	3	20						
20	3	11b	CRANE	9.1 K	11	9.1 K	9.1 K	12	3.3 K	EXTERIOR LIGHTS	11a	1	20						
20	1	11a	EXTERIOR LIGHTS	100	13	.1 K													
73 A FLA x .70 DIVERSITY = 66 AMP					TOTAL : 604 K 56 K 54.6 K			"CLASS OR BREAKER" REFERS TO BREAKER CLASS PER FEDERAL SPEC. W-C-375 OR AMPERE RATING OF SWITCH											

PANEL BOARD "HB" SCHEDULE FOR BUILDING 44

NO SCALE

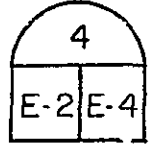


- NOTES (UNIQUE FOR BLD.44 - FIRE ALARM RISER DIAGRAM):
1. CONDUCTOR QUANTITY SHALL BEAS PER MANUFACTURERS REQUIREMENTS.
2. FIRE ALARM SYSTEM SHALL BE A IDC STYLE D, SLC STYLE 2 SYSTEM.
3. FIRE ALARM STATIONS, HORNS, AND THE CENTRAL STATION SHALL BE LOCATED AS SHOWN ON THE PLANS.
4. ALL NEW CONDUIT SHALL BE 3/4 INCH E.M.T. CONDUIT.
5. BUILDING 44 SHALL BE PROVIDED WITH A NEW FIRE ALARM SYSTEM. THIS INCLUDES NEW CONDUIT, CONDUCTORS, STATIONS, HORNS , CENTRAL STATION AND OTHER ITEMS NECESSARY FOR A COMPLETE WORKING SYSTEM.
6. EXISTING SYSTEM SHALL BE REMOVFD BEFORE NEW SYSTEM IS INSTALLED.
7. PROVIDE ONE SET OF NO. AND ONE SET OF N.O. CONTACTS IN FIRE ALARM CONTROL PANEL FOR EMERGENCY SHUT-DOWN OF EXISTING OFFICE AREA AIR HANDLING UNIT (AHU).

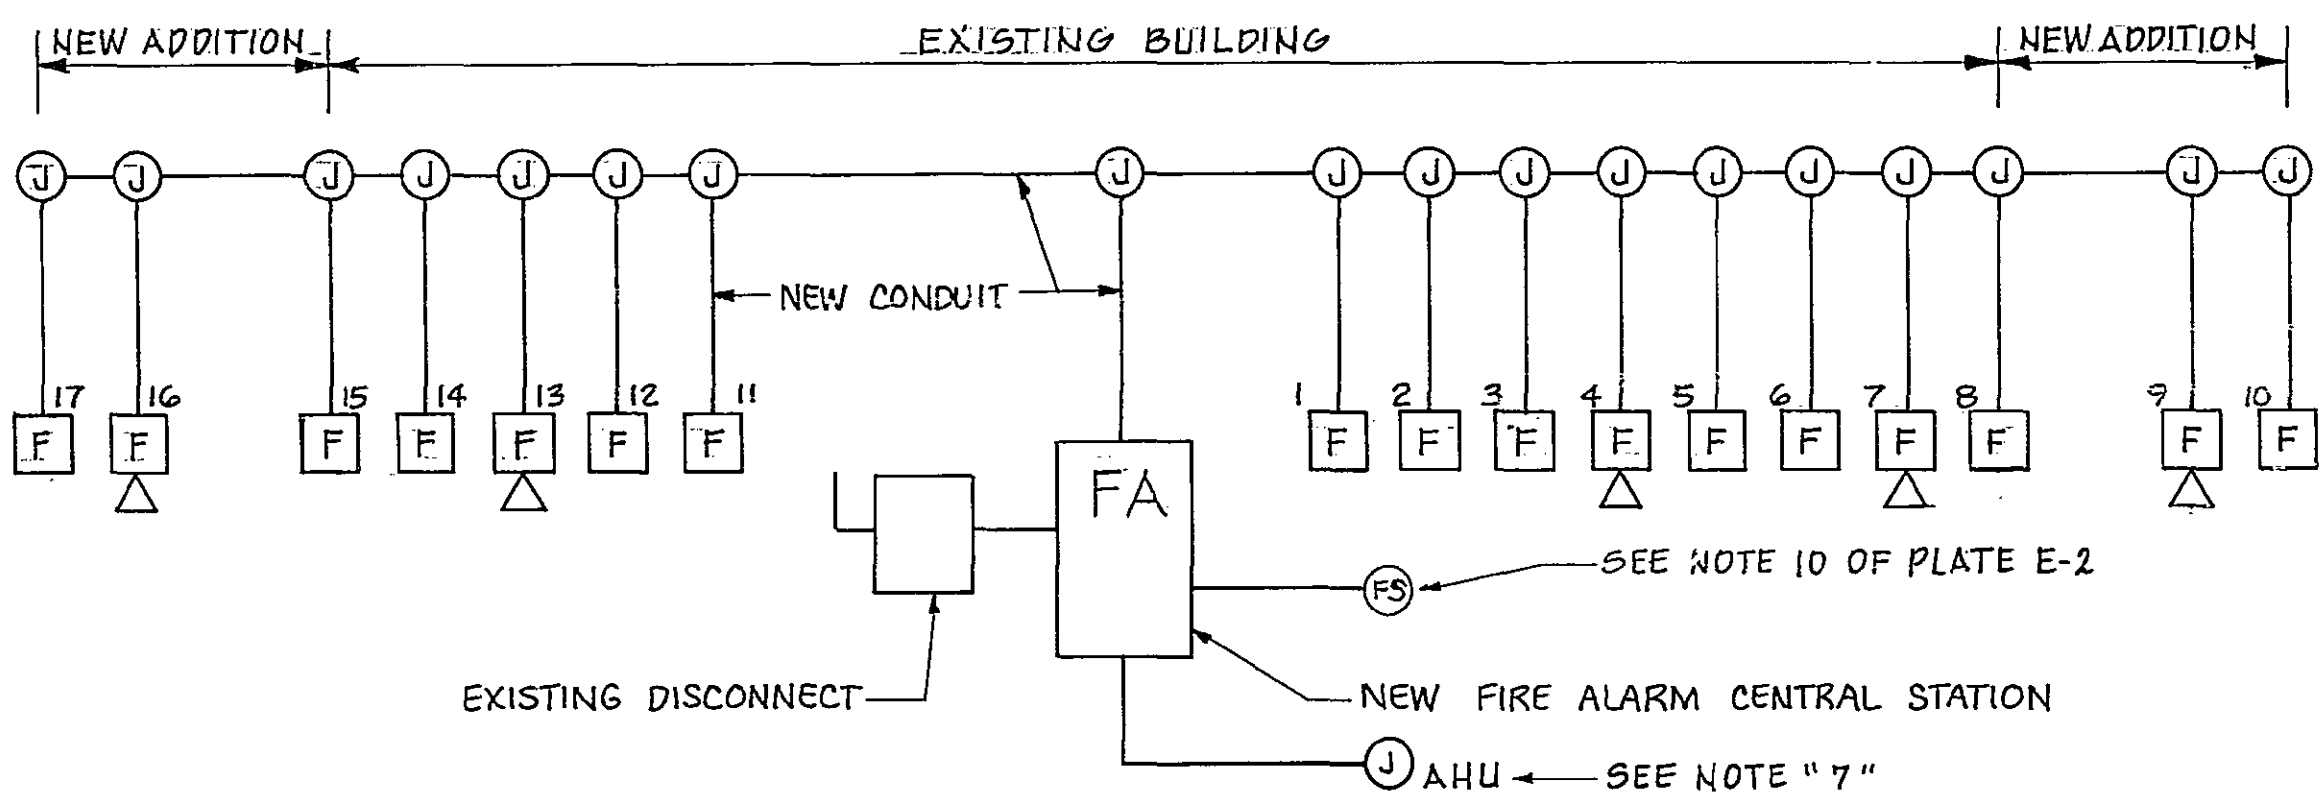


BUILDING 44 - FIRE ALARM RISER DIAGRAM

NO SCALE

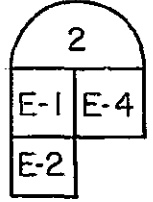


WURZ, WISECARVER & PRUETT ARCHITECTS - ENGINEERS ATLANTA, GEORGIA		U. S. ARMY ENGINEER DISTRICT SAVANNAH CORPS OF ENGINEERS SAVANNAH, GEORGIA			
NOSE DOCK EMPENNAGE ENCLOSURE					
BUILDING 44 ELECTRICAL DIAGRAMS					
ROBINS AIR FORCE BASE		GEORGIA			
SIZE	INVIATION NO.	DRAWING NO.	PLATE		
F	DACA-21-859-0090	39-01-08	E-4		
SYMBOL	ZONE	DESCRIPTION	DATE BY		
SCALE: AS SHOWN		SHEET 81			

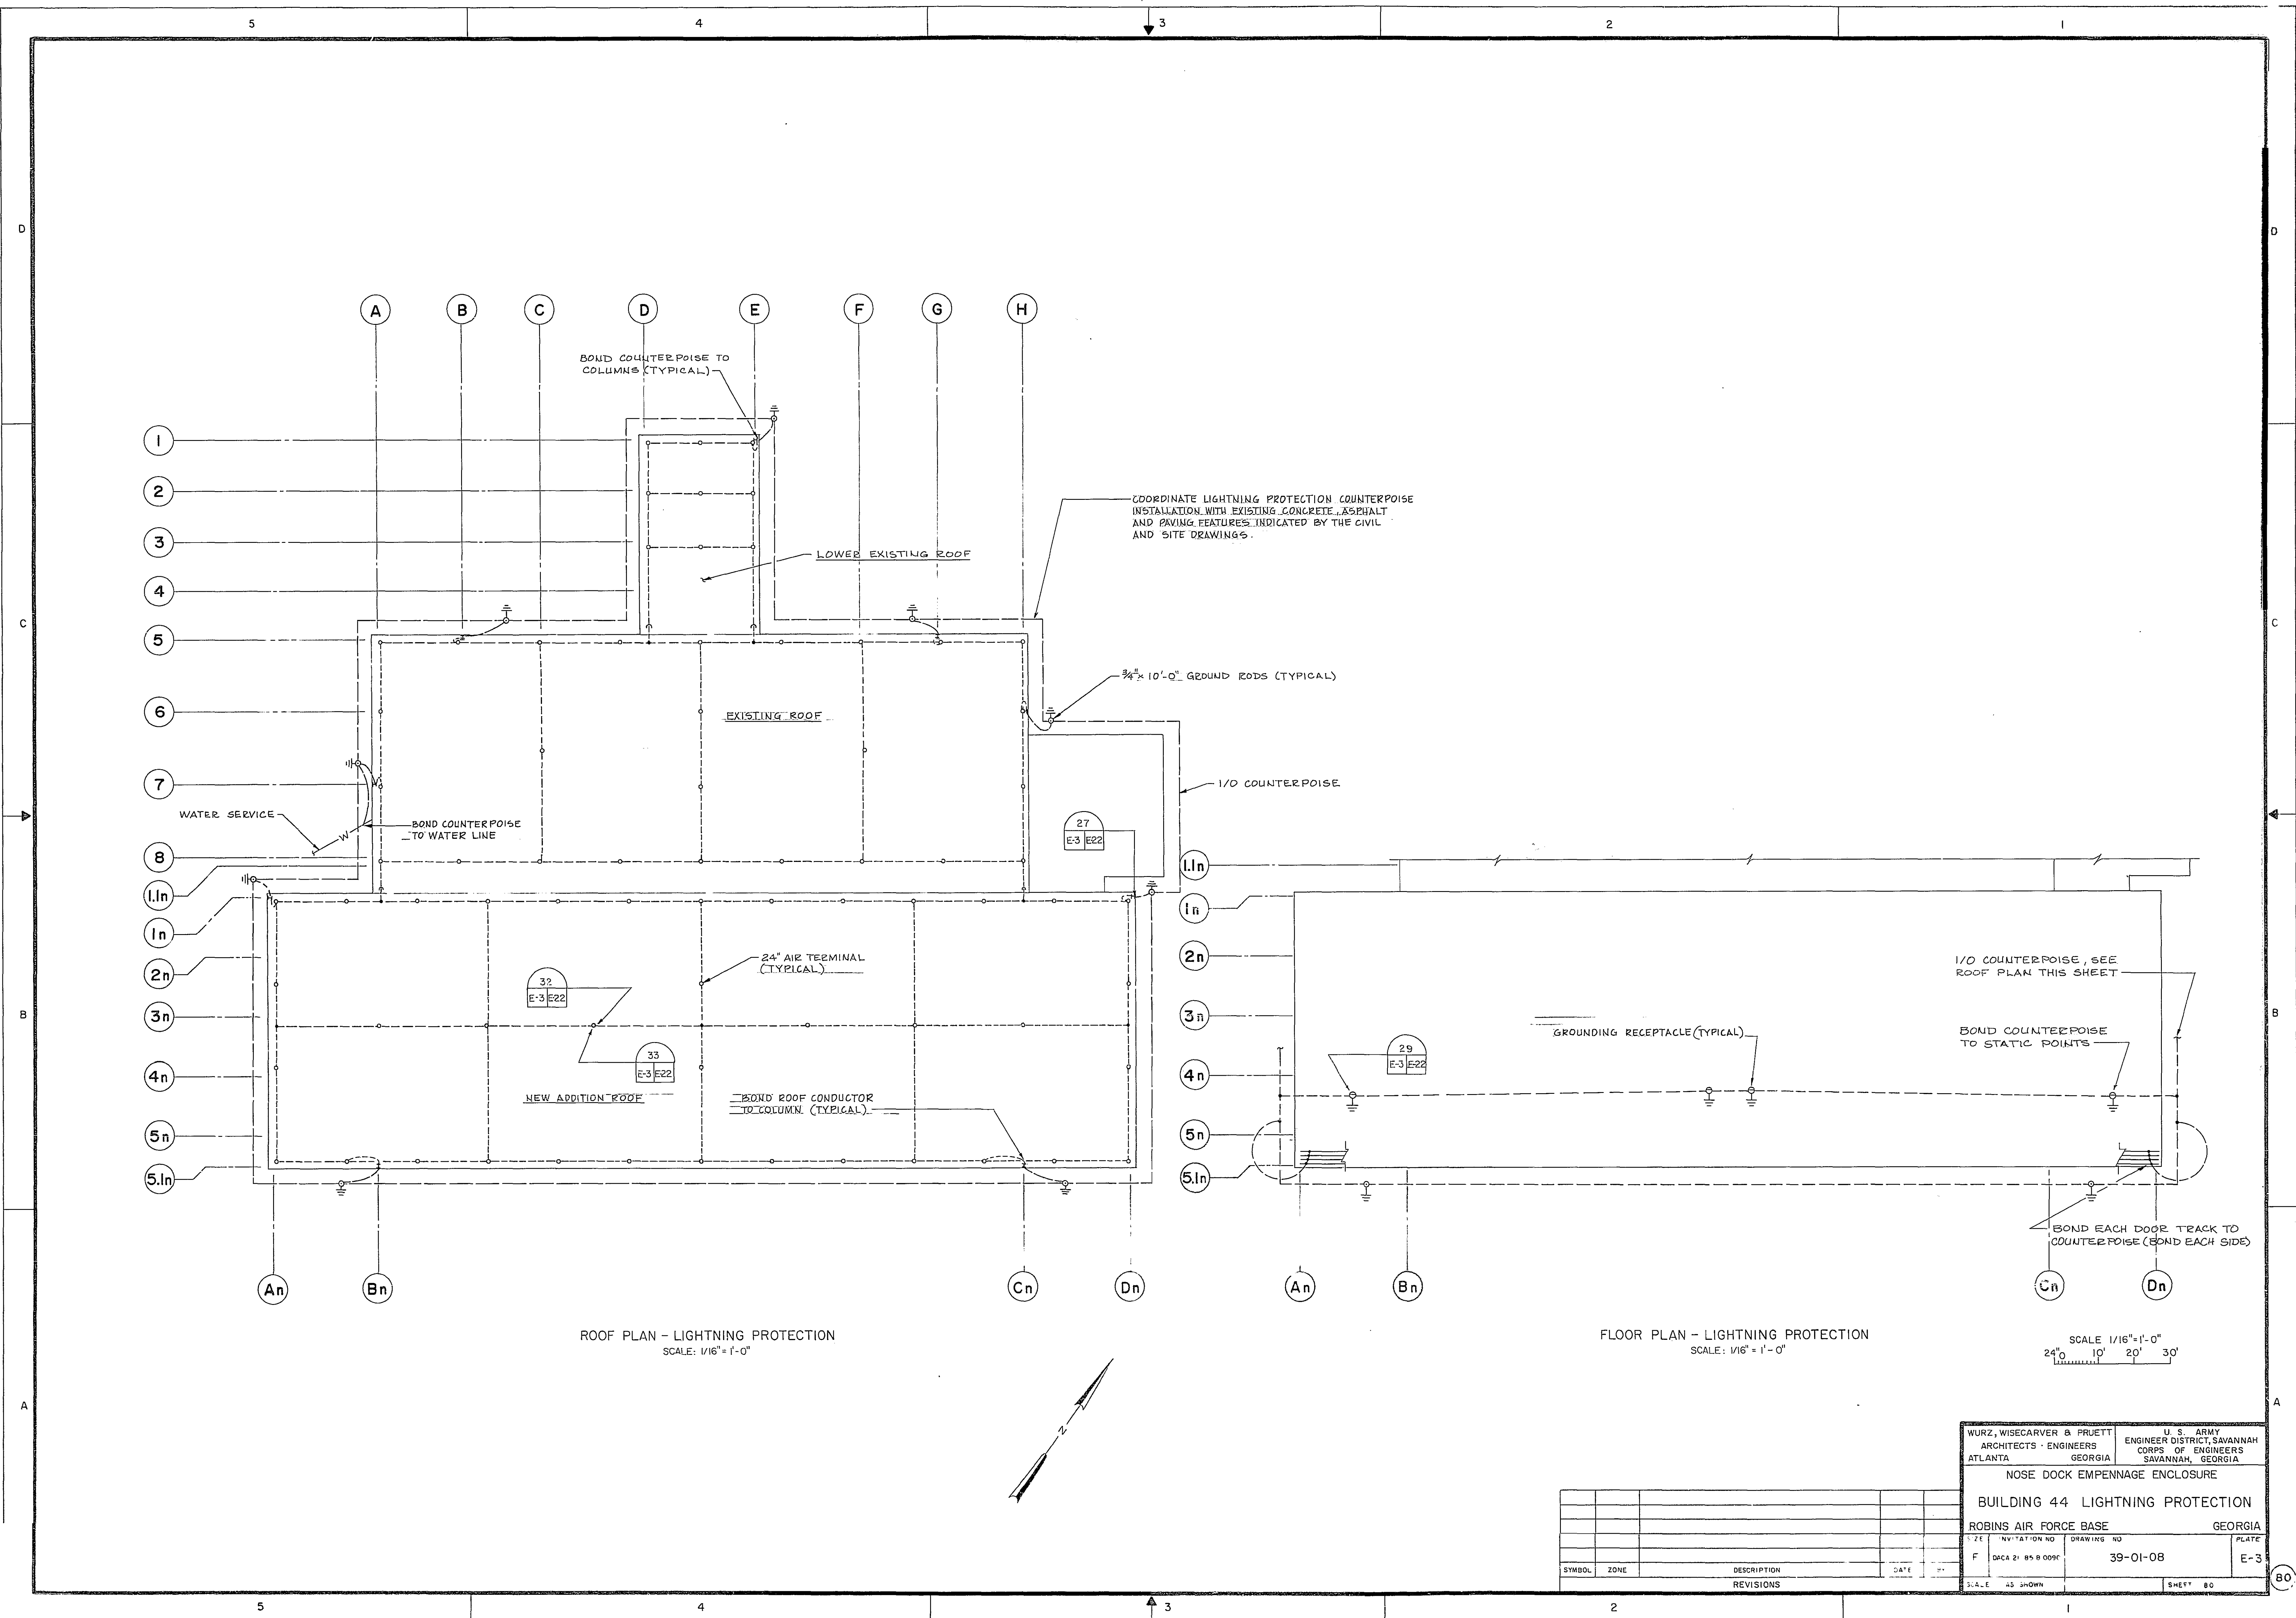


ROOF PLAN - LIGHTNING PROTECTION
SCALE: 1/16" = 1'-0"

FLOOR PLAN - LIGHTNING PROTECTION
SCALE: 1/16" = 1'-0"

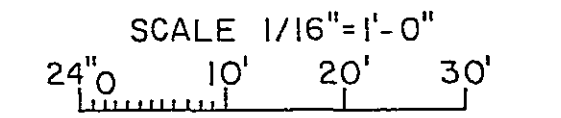

SYMBOL	ZONE	DESCRIPTION	DATE	BY
		REVISIONS		

WURZ, WISECARVER & PRUETT ARCHITECTS - ENGINEERS ATLANTA, GEORGIA		U. S. ARMY ENGINEER DISTRICT, SAVANNAH CORPS OF ENGINEERS SAVANNAH, GEORGIA	
NOSE DOCK EMPENNAGE ENCLOSURE			
BUILDING 44 LIGHTNING PROTECTION			
ROBINS AIR FORCE BASE, GEORGIA			
DATE	INVESTIGATION NO.	DRAWING NO.	PLATE
F	DAKA 21 85 8 008T	39-01-08	E-3
SHEET 80			80

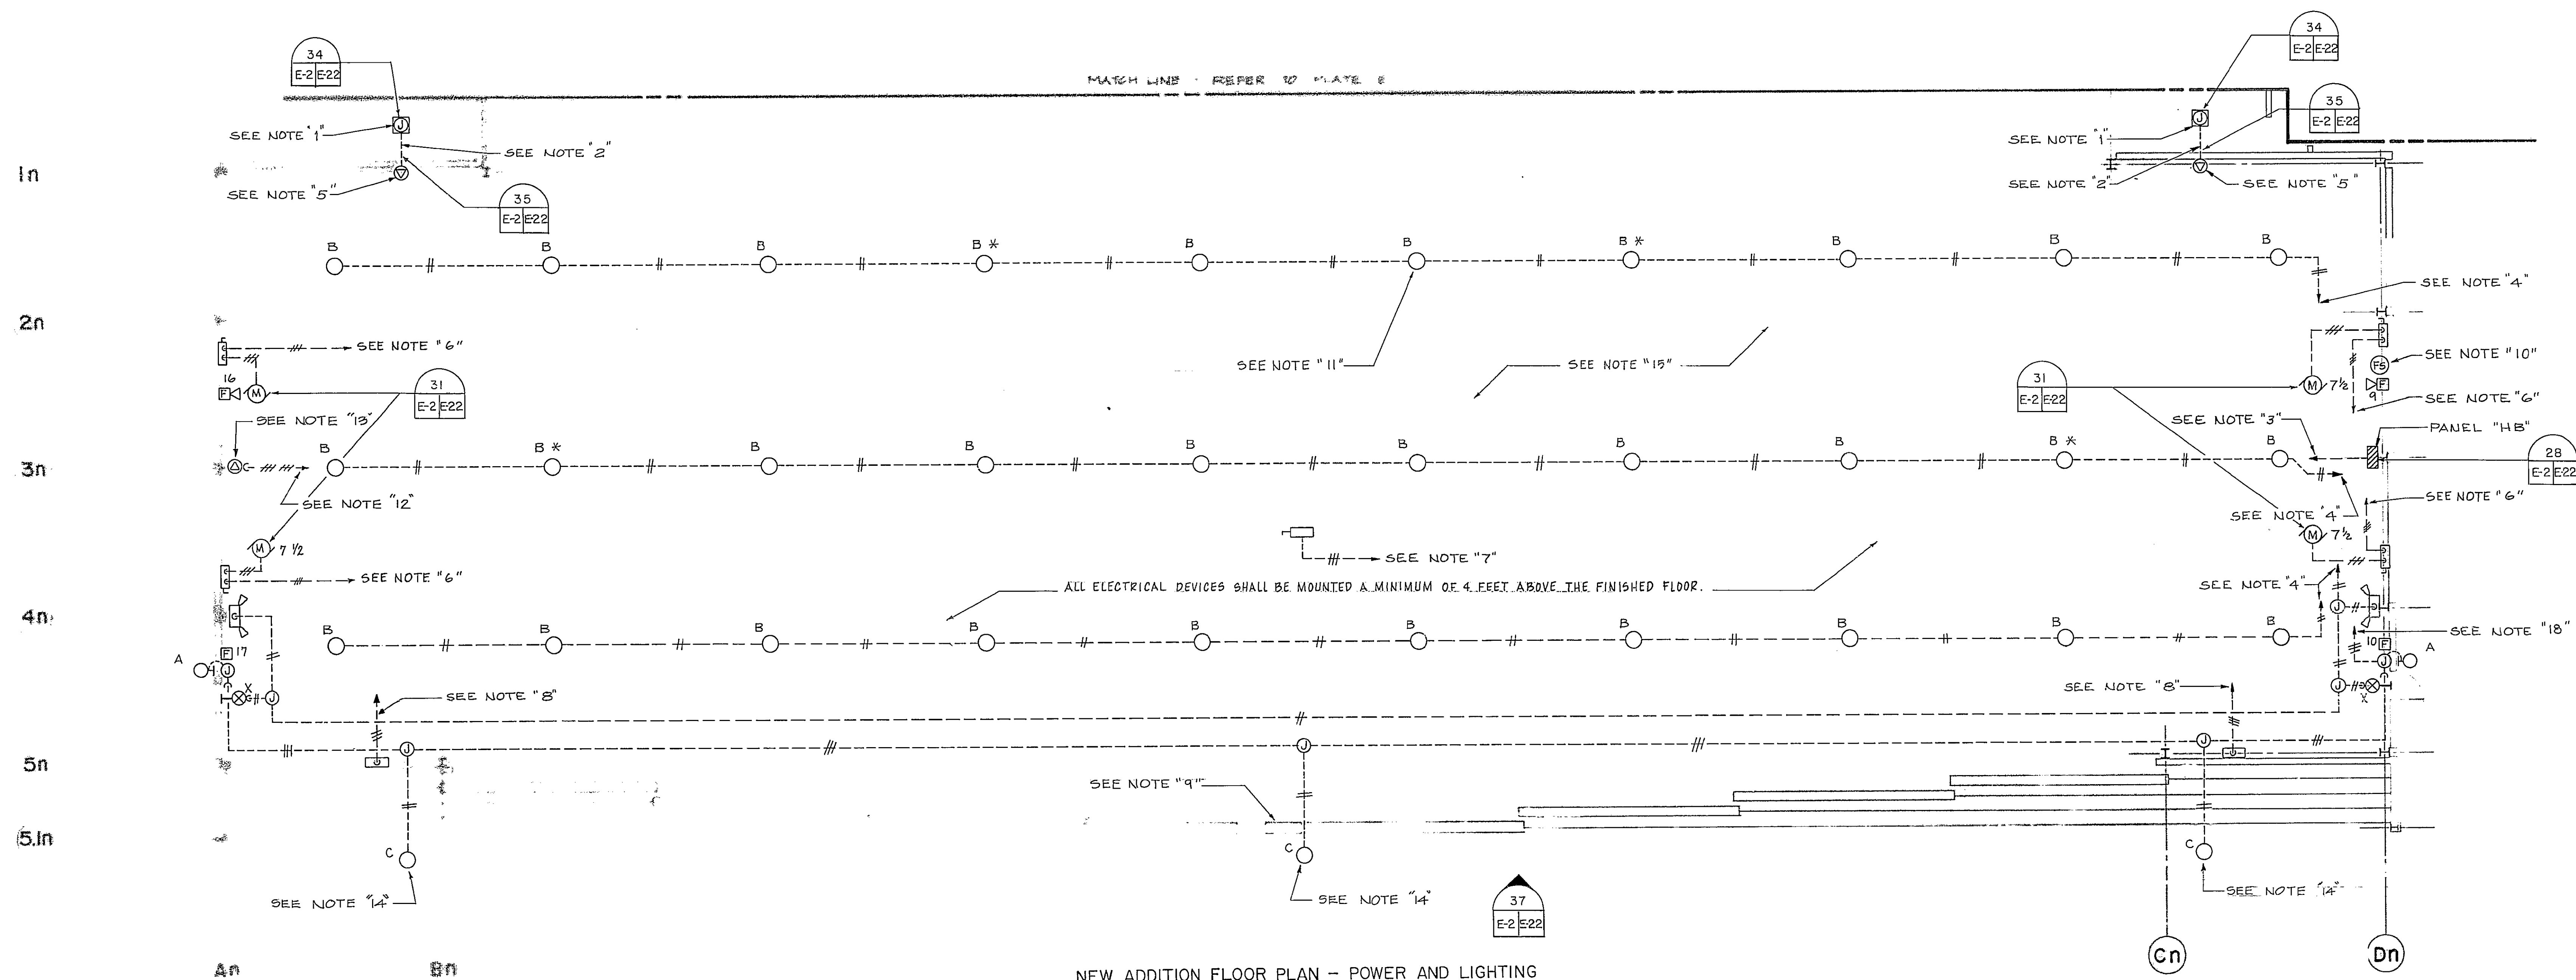

NEW ADDITION FLOOR PLAN - POWER AND LIGHTING
SCALE: 1/8" = 1'-0"

NOTES (THIS SHEET ONLY):


1. PROVIDE HEAVY DUTY 6"x6"x4" FLOOR JUNCTION BOX. ALL EXISTING CONDUCTORS AND CONDUITS MOUNTED ON EXISTING TO BE REMOVED WALL SHALL BE TERMINATED IN FLOOR JUNCTION BOX.
2. PROVIDE 5-#12 THW CU CONDUCTORS IN 3/4" E.S. CONDUIT INSTALLED IN CONCRETE SLAB. CLASS 1, DIVISION 1, GROUP D CONSTRUCTION.
3. PROVIDE 4-#10 THW CU CONDUCTORS IN 2" R.S. CONDUIT TO PANEL "MDP".
4. PROVIDE 2-#10 THW CU CONDUCTORS IN 1/2" E.S. CONDUIT AND CONNECT TO PANEL "HB".
5. RELOCATED OUTLET SHALL BE WALL MOUNTED 4 FEET ABOVE FINISHED FLOOR.
6. PROVIDE 3-#10 THW CU CONDUCTORS IN 1/2" R.S. CONDUIT AND CONNECT TO PANEL "HB". THIS CIRCUIT SHALL SERVE THE 7 1/2" H.P. EXHAUST FAN.
7. PROVIDE 3-#10 THW CU CONDUCTORS IN 1/2" R.S. CONDUIT AND CONNECT TO PANEL "HB". THIS CIRCUIT SHALL SERVE THE 7 1/2" H.P. BRIDGE CRANE MOTOR. DISCONNECT SHALL BE MOUNTED ON THE ROOF. COORDINATE ELECTRICAL CONNECTIONS WITH MANUFACTURER'S REQUIREMENTS.
8. PROVIDE 3-#10 THW CU CONDUCTORS IN 1/2" R.S. CONDUIT AND CONNECT TO NEW DISCONNECT LOCATED ADJACENT TO PANEL "MDP". THIS CIRCUIT SHALL SERVE THE 2 H.P. ELECTRIC DOOR MOTORS. COORDINATE ELECTRICAL CONNECTIONS WITH MANUFACTURER'S REQUIREMENTS.

9. HANGAR DOOR CONTROL SWITCHES SHALL BE PROVIDED ON CENTER-MOST HANGAR DOORS TO ENSURE CLEAR PATH OF VISION WHEN OPERATING DOORS.
10. PROVIDE NECESSARY CONNECTIONS FROM THE SPRINKLER SYSTEM FLOW SWITCH TO THE FIRE ALARM CENTRAL STATION. CONTROLS SHALL BE AS FOLLOWS: WHEN THE FLOW SWITCH SENSES WATER MOVEMENT IN THE SPRINKLER WATER LINES, THE FIRE ALARM SYSTEM SHALL BE ACTIVATED AND ALARM WILL SOUND. THE SPRINKLER SYSTEM FLOW SWITCH IS LOCATED IN THE SPRINKLER WATER LINE, APPROXIMATELY 5 FEET ABOVE THE FINISHED FLOOR, AT THE LOCATION SHOWN HERE.
11. CONTRACTOR SHALL COORDINATE ALL LIGHT FIXTURES TYPE "B" WITH STRUCTURAL STEEL.
12. PROVIDE 4-#10 AND 1-#6 CU. RHW CONDUCTOR IN 2 1/2" R.S. CONDUIT AND CONNECT TO EXISTING CIRCUIT BREAKER LOCATED IN EXISTING MAIN LOW VOLTAGE PANEL. THIS EXISTING CIRCUIT BREAKER PREVIOUSLY SERVED THE TO BE REMOVED 100 AMP SLAB MOUNTED RECEPTACLE LOCATED IN THE EXISTING APRON SLAB.
13. PROVIDE A WALL MOUNTED, 100 AMPERE, 208 VOLT, 3 PHASE, 3 WIRE, 60 CYCLE RECEPTACLE MOUNTED 4 FEET ABOVE THE FINISHED FLOOR. RECEPTACLE CONFIGURATION SHALL MATCH EXISTING 100 AMPS SLAB MOUNTED RECEPTACLE TO BE REMOVED.

14. PROVIDE A CENTRAL PHOTO SWITCH AND A 277 VOLT CONTACTOR EQUIPPED WITH A LOCKABLE MANUAL CONTROL DEVICE TO CONTROL ALL THREE 1000 W APRON LIGHTS. LOCATE CONTACTOR ADJACENT TO PANEL "HB".
15. PROVIDE INTERIOR ELECTRICAL INSTALLATION IN NEW ADDITION IN ACCORDANCE WITH N.E.C. CHAPTER 5, ARTICLE 513 FOR AIRCRAFT HANGAR (CLASS 1, DIVISION 2, GROUP D).
16. SEE LIGHTING FIXTURE DETAIL SHEET, PLATE E-21 FOR LIGHT FIXTURE DETAILS.
17. CONTRACTOR SHALL INSTALL ELECTRICAL EQUIPMENT ACCORDING TO CHAPTER 5, ARTICLE 513 - "AIRCRAFT HANGARS".
18. PROVIDE 3-#10 THW CU CONDUCTORS IN 1/2" R.S. CONDUIT AND CONNECT TO PANEL "HB".

SYMBOL	ZONE	DESCRIPTION	DATE	BY

WURZ, WISECARVER & PRUETT ARCHITECTS - ENGINEERS ATLANTA, GEORGIA		U. S. ARMY ENGINEER DISTRICT, SAVANNAH CORPS OF ENGINEERS SAVANNAH, GEORGIA	
NOSE DOCK EMPENNAGE ENCLOSURE			
BUILDING 44 POWER AND LIGHTING			
ROBINS AIR FORCE BASE		GEORGIA	
DATE	DRAWING NO.	PLATE	
F	39-01-08	E-2	
SCALE AS SHOWN		SHEET 79	

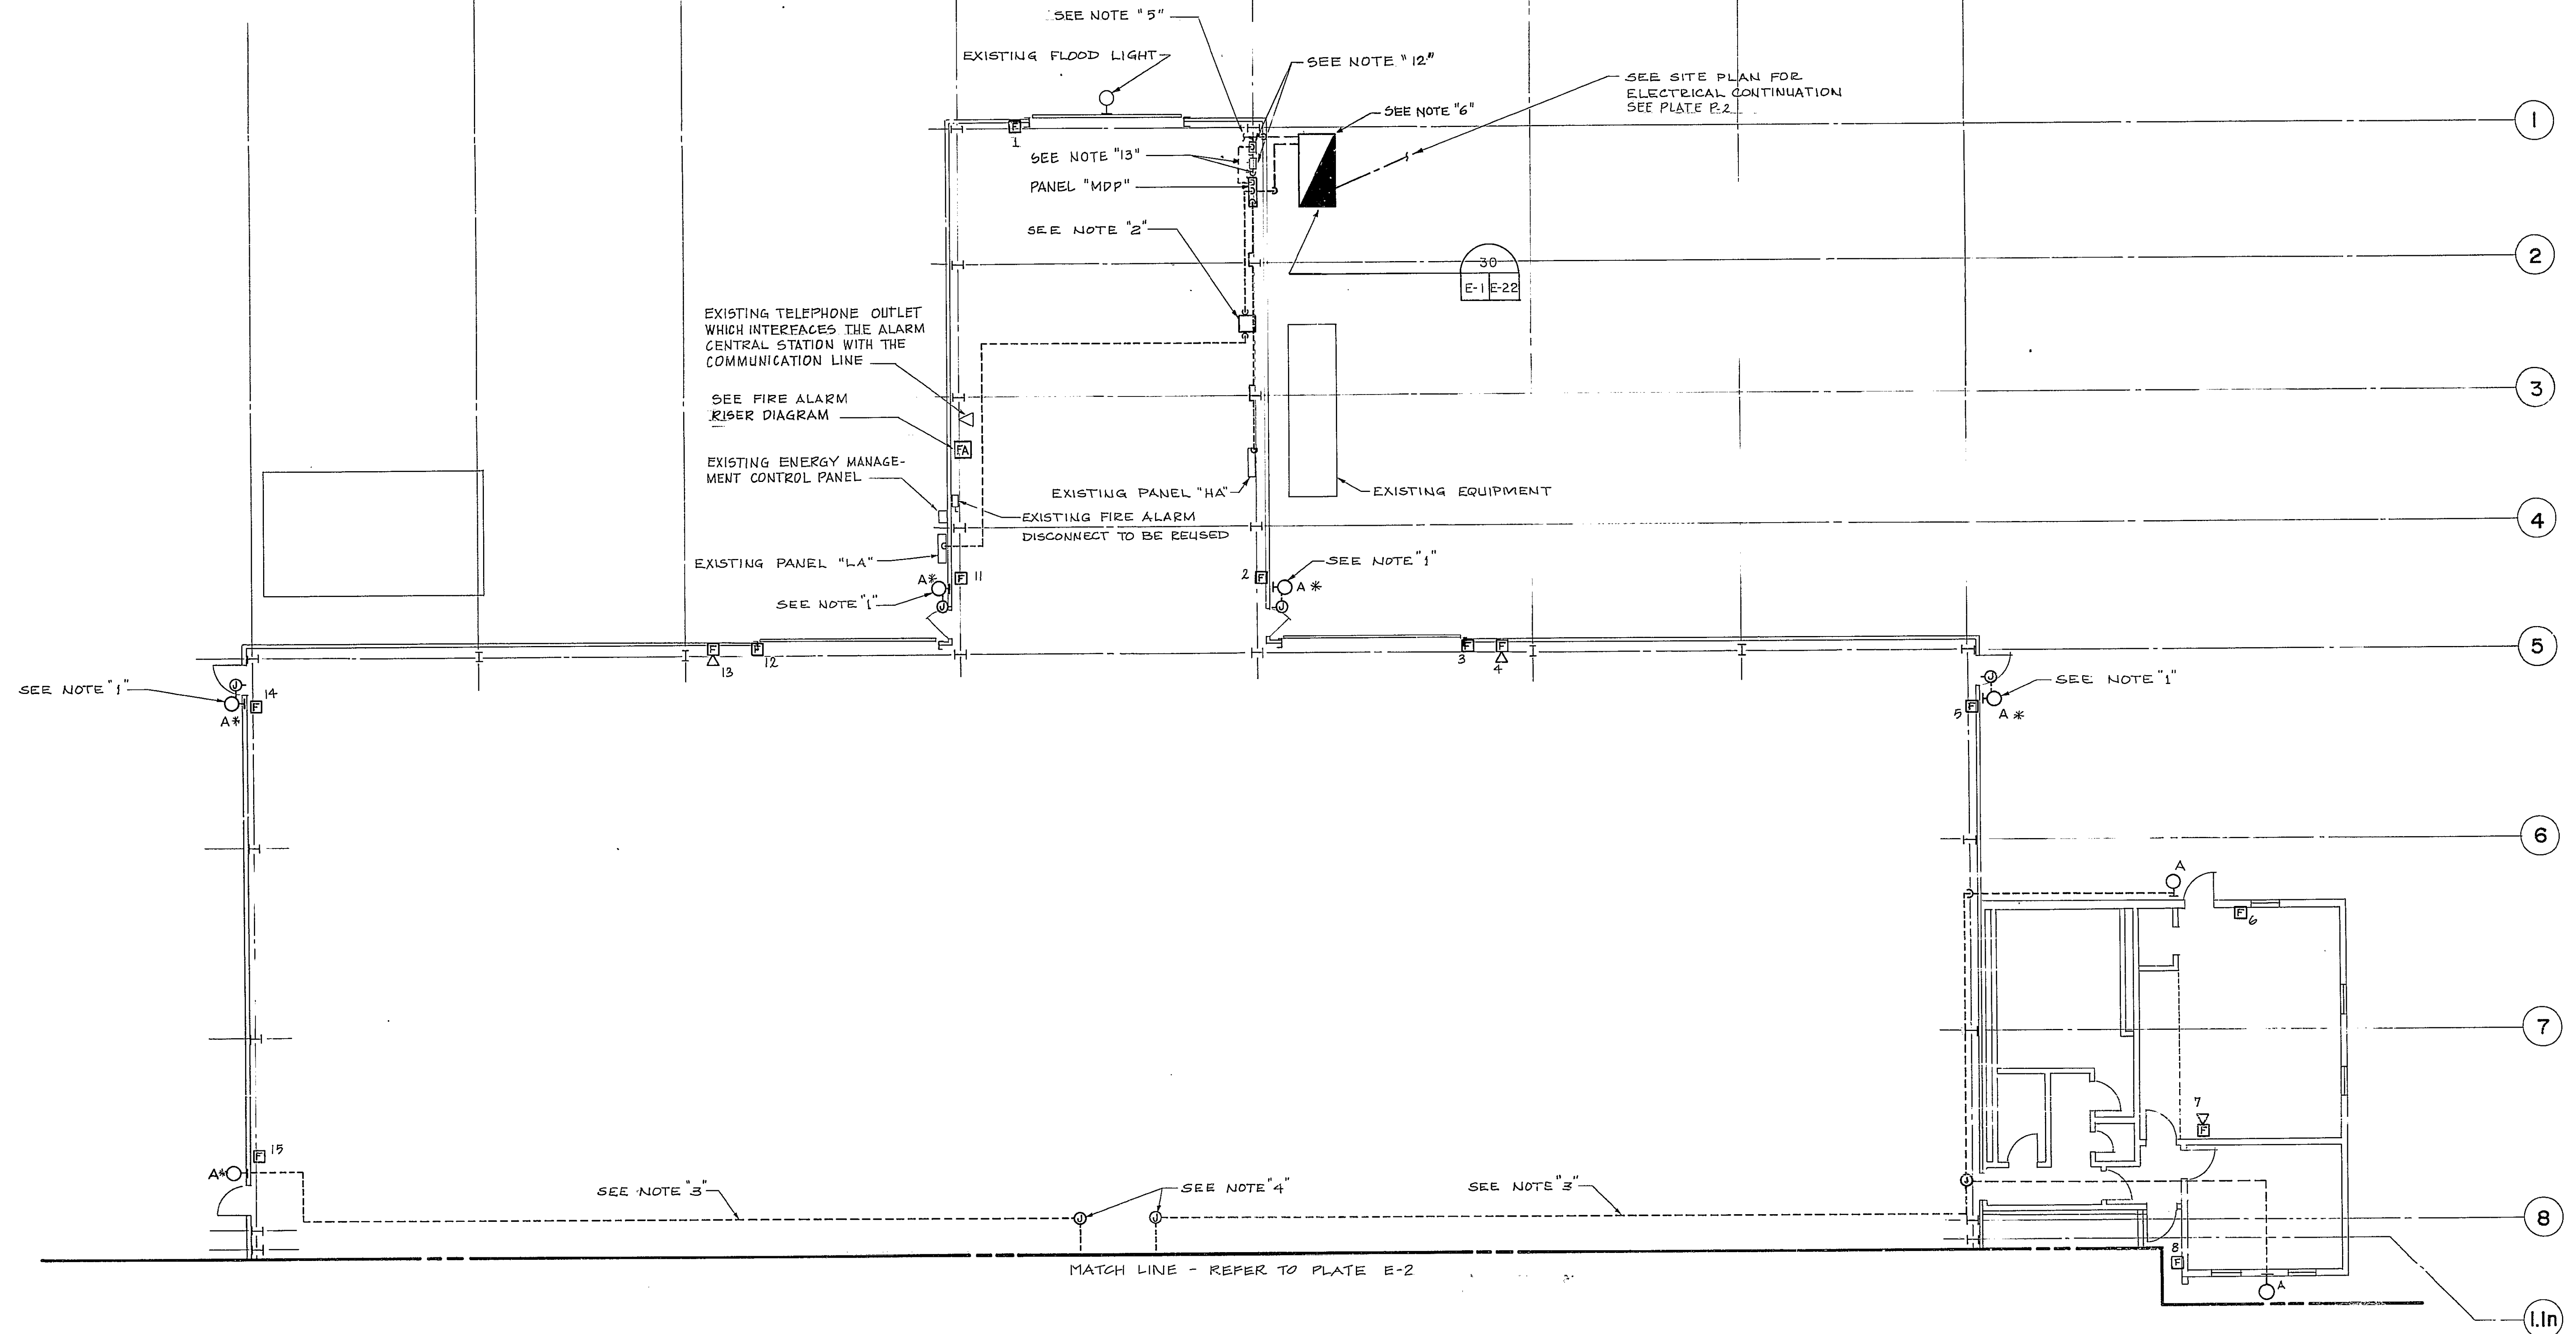


EXISTING BUILDING FLOOR PLAN - POWER AND LIGHTING
SCALE: 1/8" = 1'-0"

NOTES (THIS SHEET ONLY):

1. PROVIDE A JUNCTION BOX AT THE EXISTING FIXTURE LOCATION. PROVIDE A 1/2" R.S. CONDUIT WITH 2-#12 THW CU CONDUCTORS FROM THE NEW JUNCTION BOX TO THE NEW FIXTURE LOCATION SHOWN ON THE PLANS. REUSE EXISTING CIRCUIT.
2. NEW 112.5 KVA DRY TYPE TRANSFORMER, 480 V PRIMARY/120/208 SECONDARY, 3Ø, 4W WITH 115°C RISE.
3. 2-#12 THW CU CONDUCTORS IN 1/2" CONDUIT SHALL BE CONNECTED TO EXISTING CIRCUIT TERMINATED IN JUNCTION BOX WHICH PREVIOUSLY SERVED THE DOOR LIGHT.
4. TERMINATE OLD EXISTING CONDUCTORS WHICH PREVIOUSLY SERVED THE APRON LIGHTS IN THE JUNCTION BOX.
5. PROVIDE A 1" R.S. CONDUIT FROM THE SECONDARY PORTION OF THE TRANSFORMER TO THE EXISTING ENERGY MANAGEMENT CONTROL PANEL. COORDINATE WITH BASE ENGINEERS.
6. 500 KVA PAD MOUNTED, LIQUID FILLED, 480Y/277V/3Ø/4W SECONDARY, 12.47 DELTA PRIMARY TRANSFORMER. TRANSFORMER SHALL BE PROVIDED WITH PRIMARY LIGHTNING ARRESTORS, TAP CHANGERS, CABLE TERMINATORS, SECONDARY PT'S AND CT'S AS REQUIRED BY WATT/HOUR METER. CONTRACTOR SHALL PROVIDE 15 MINUTE DEMAND AND PULSE INITIATING WATT/HOUR METER MOUNTED ON TRANSFORMER ENCLOSURE.
7. ADDITIONAL ELECTRICAL DEMOLITION AND RELOCATION WORK IS SHOWN ON PLATE P-1 THRU P-3.
8. REFER TO PLATE E-21 FOR ELECTRICAL LEGEND.
9. CONNECT EXISTING CIRCUITS IN EXISTING FIRE ALARM. DISCONNECT TO NEW FIRE ALARM PANEL. SEE SPECIFICATIONS, SECTION 16.1 FOR FIRE ALARM SYSTEM POWER REQUIREMENTS.
10. SEE LIGHTING FIXTURE DETAIL SHEET, PLATE E-21 FOR LIGHT FIXTURE DETAILS.
11. CONTRACTOR SHALL INSTALL ELECTRICAL EQUIPMENT ACCORDING TO CHAPTER 5, ARTICLE 513 - "AIRCRAFT HANGARS".
12. PROVIDE A 30 AMP, 3 POLE, NEMA1 FUSIBLE DISCONNECT SWITCH TO SERVE HANGAR DOORS. FUSE AT 30 AMPS, 22,000 A.I.C.
13. PROVIDE 3-#10 THW CU CONDUCTORS IN 1/2" R.S. CONDUIT AND CONNECT AHEAD OF THE MAIN BREAKER IN PANEL "MDP". PROVIDE APPROPRIATE TERMINATIONS TO PANEL "MDP" MAIN LUGS.


SYMBOL	ZONE	DESCRIPTION	DATE	BY
REVISIONS				

DESIGN RUB	CHECK PMD	WURZ, WISECARVER & PRUETT ARCHITECTS - ENGINEERS ATLANTA, GEORGIA		U. S. ARMY ENGINEER DISTRICT, SAVANNAH CORPS OF ENGINEERS SAVANNAH, GEORGIA
PROJECT MANAGER RECOMMENDED Wayne H. ...		NOSE DOCK EMPENNAGE ENCLOSURE BUILDING 44 POWER AND LIGHTING		
DATE 01 SEPT 83		ROBINS AIR FORCE BASE INVESTIGATION NO. 39-01-08 DRAWING NO. 39-01-08		GEORGIA PLATE E-1
SCALE AS SHOWN		SHEET 78		

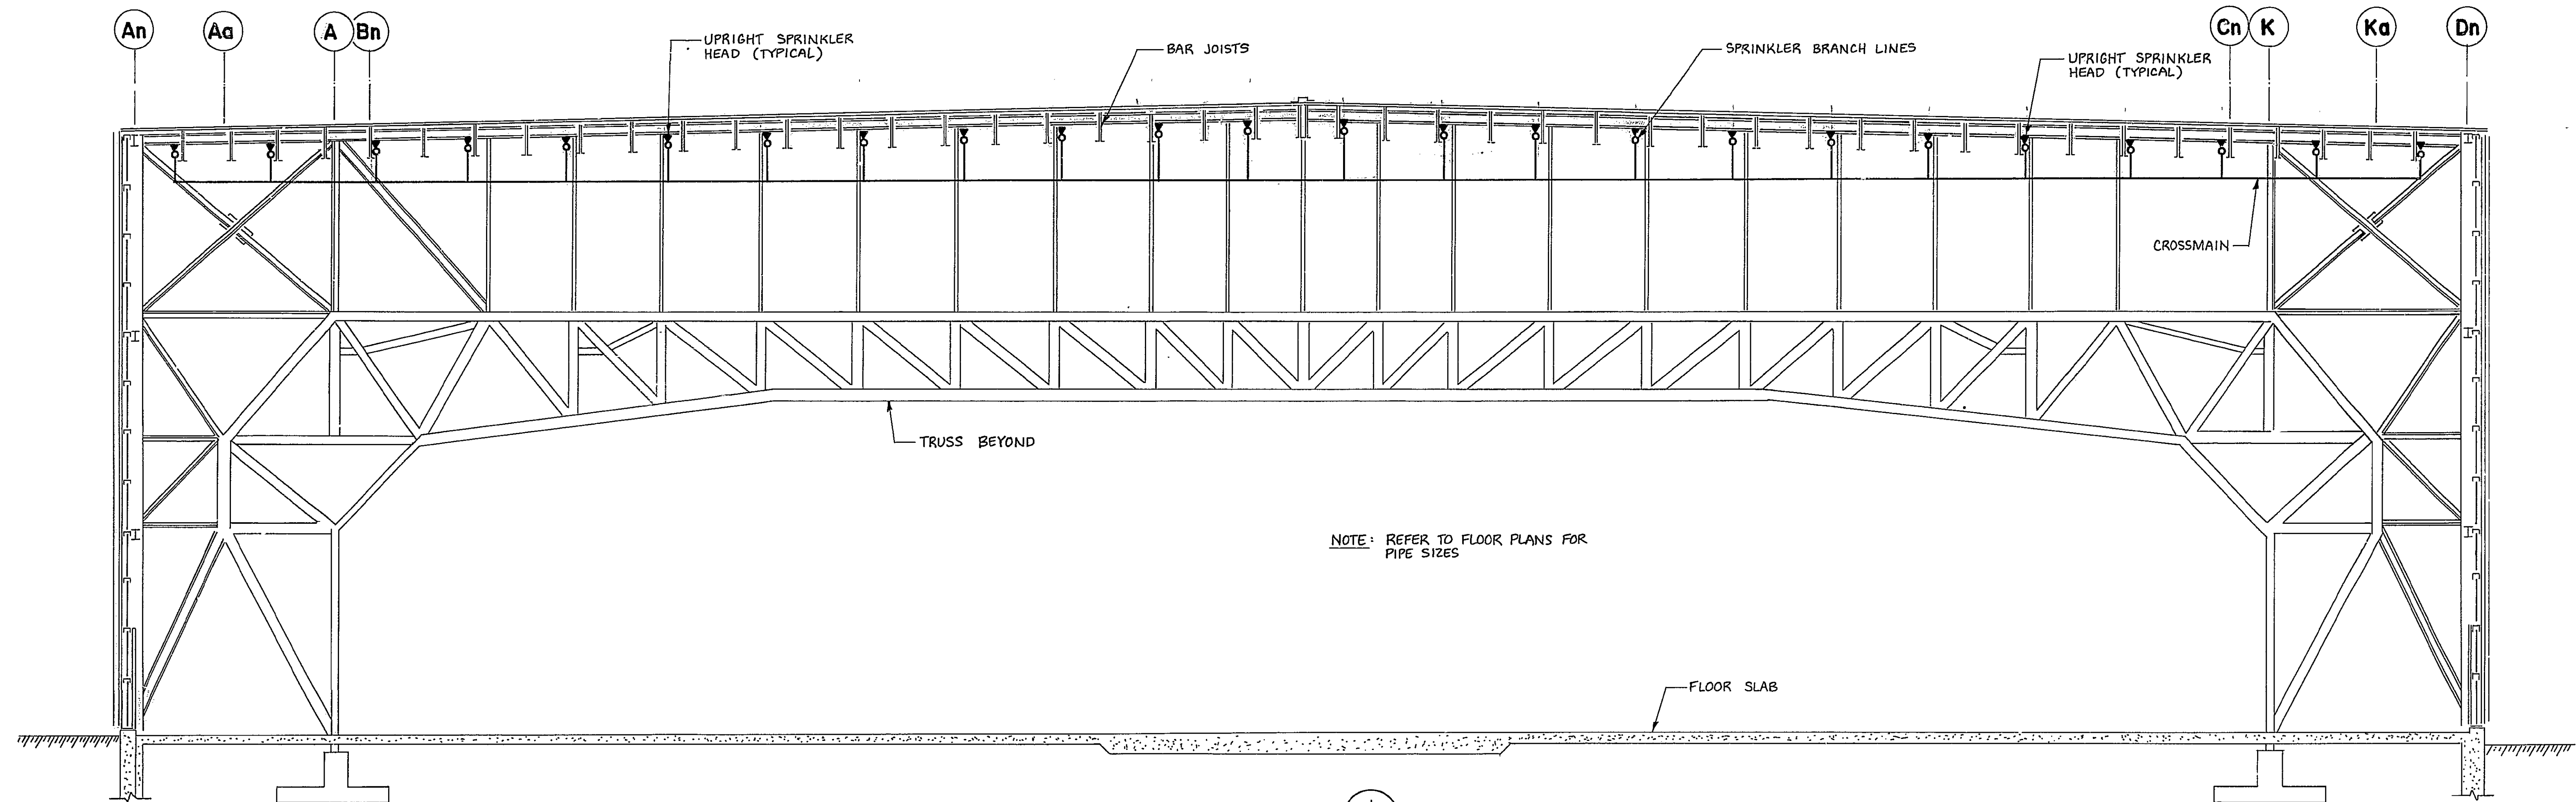

NOTE: REFER TO FLOOR PLANS FOR PIPE SIZES


SECTION
SCALE: 1/8" = 1'-0"
BLDG'S. 47, 48, & 49

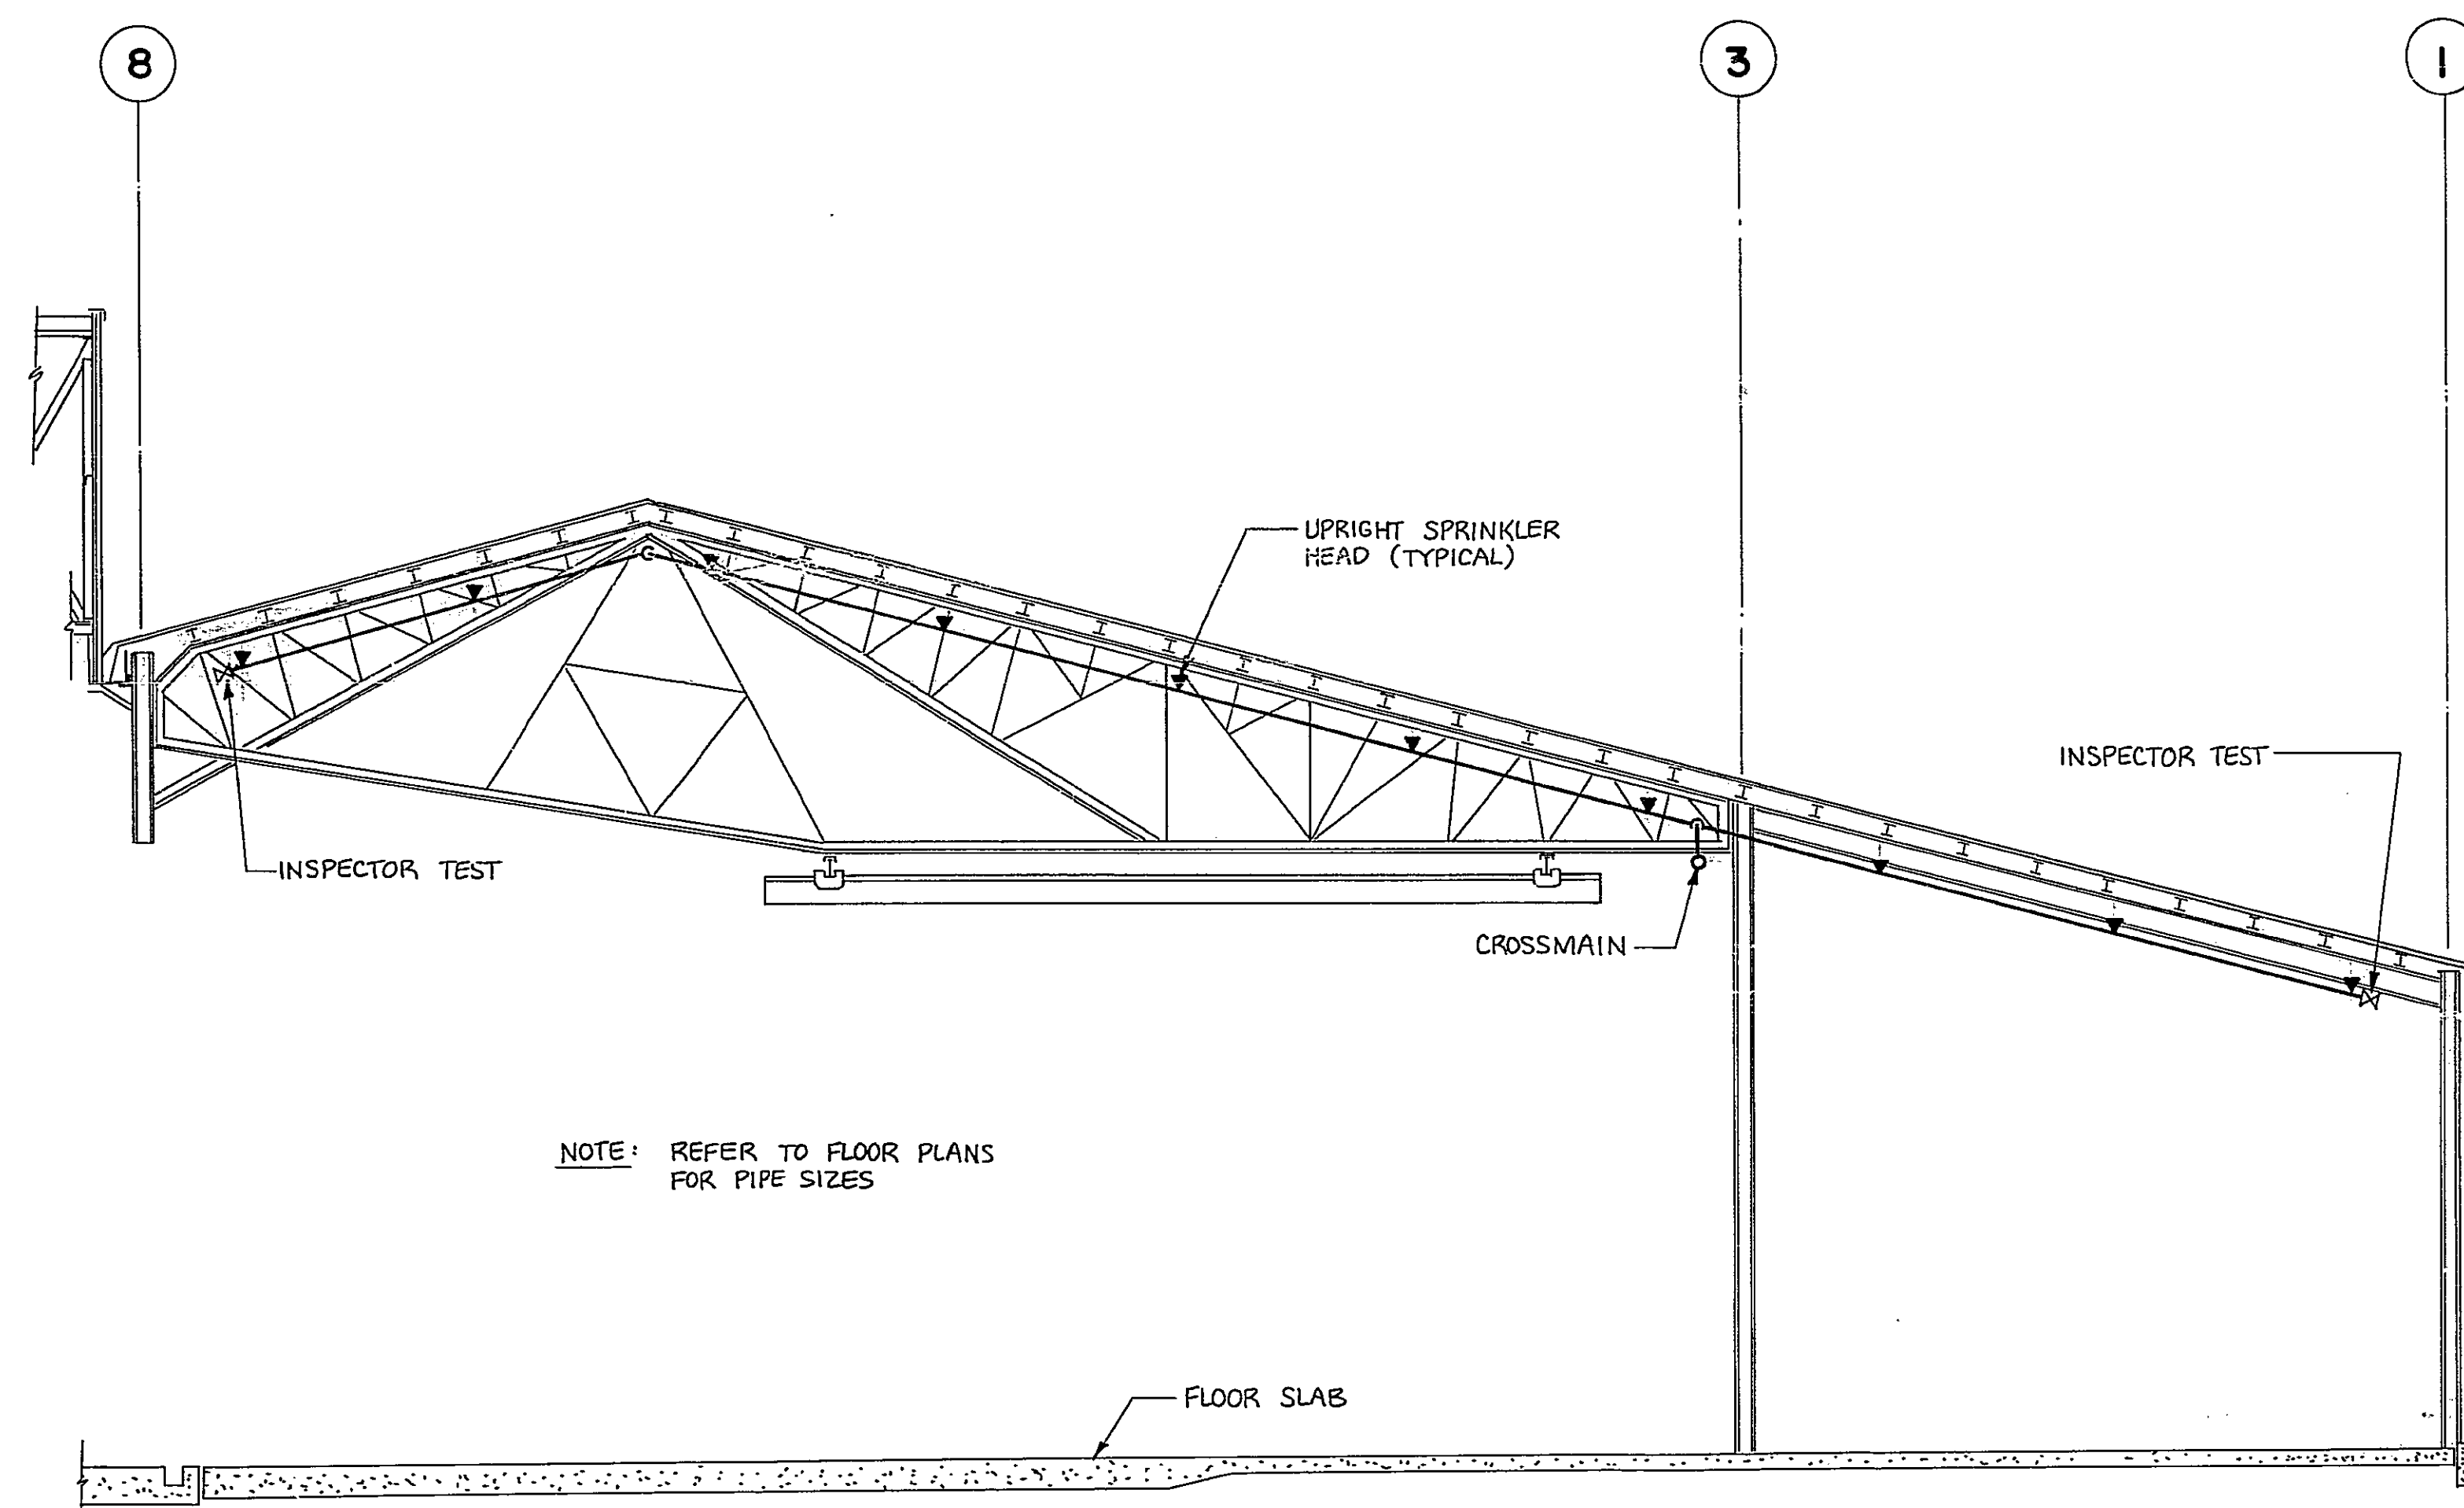

NOTE: REFER TO FLOOR PLANS FOR PIPE SIZES

SECTION
SCALE: 1/8" = 1'-0"
BLDG'S. 47, 48, & 49

2
M-9 M-24
M-10
M-11
M-17
M-19
M-21

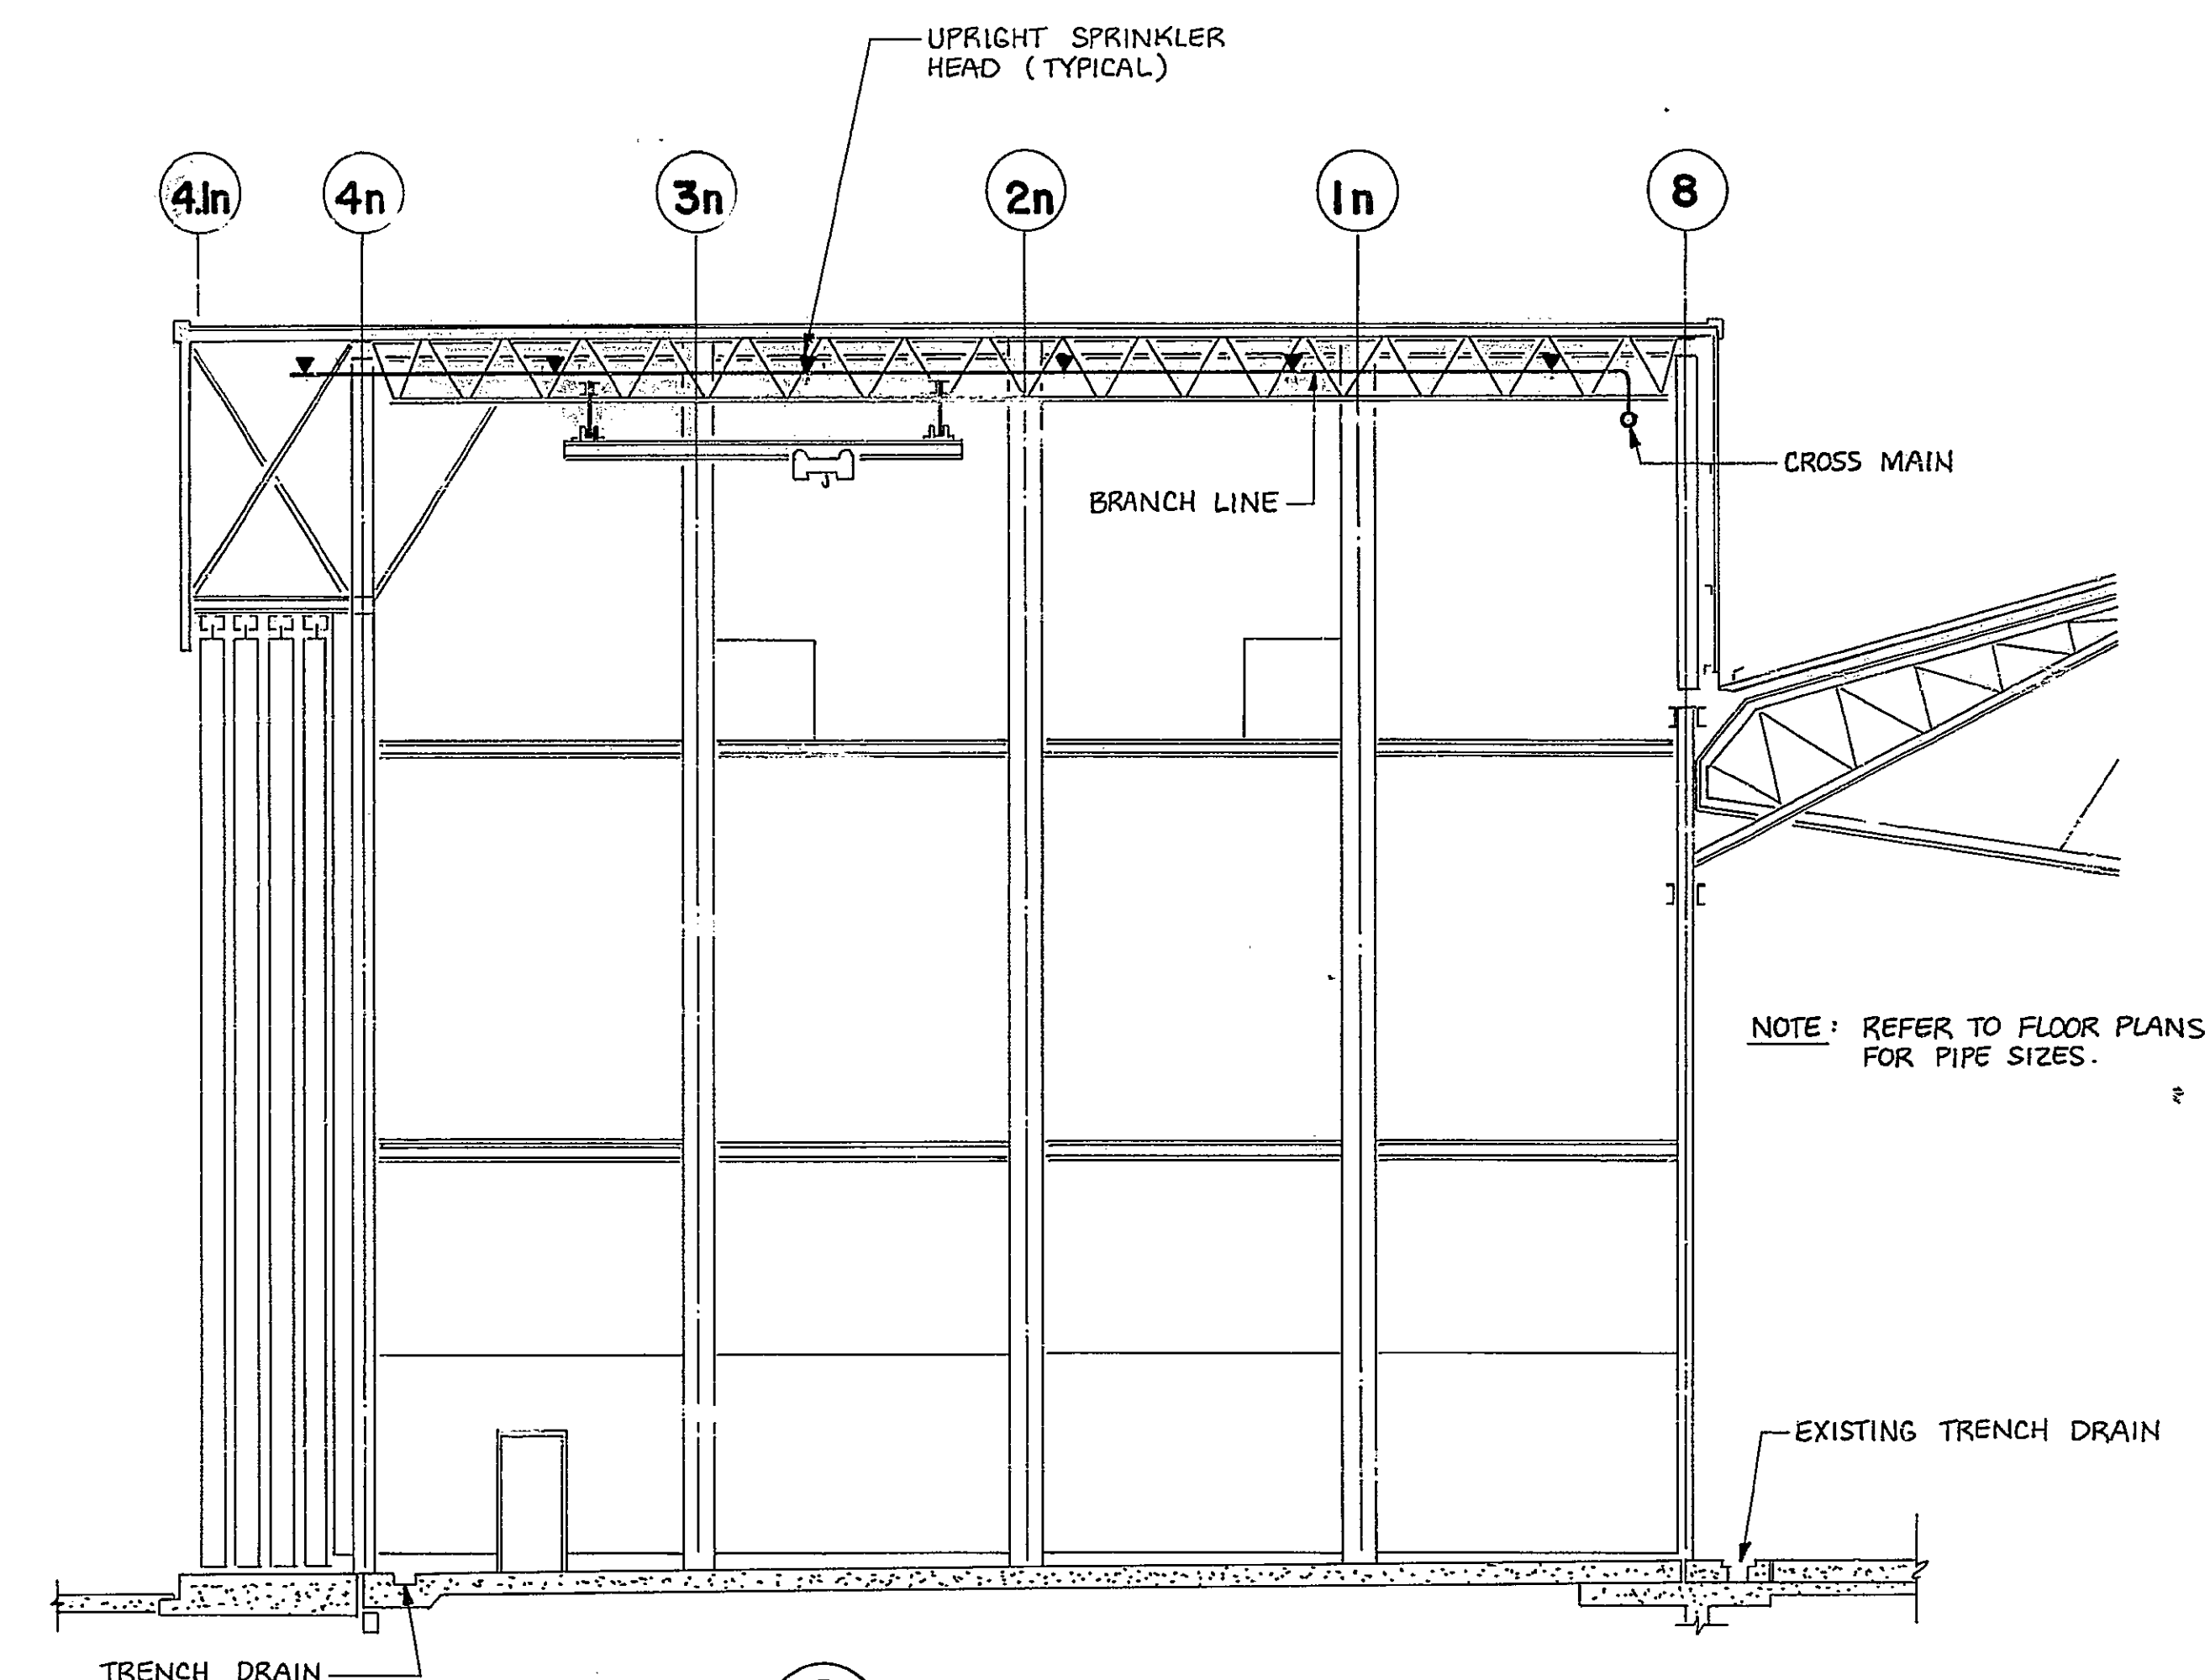

NOTE: REFER TO FLOOR PLANS FOR PIPE SIZES





SECTION
SCALE: 1/8" = 1'-0"
BLDG'S. 47, 48, & 49

3
M-9 M-24
M-10
M-11
M-17
M-19
M-21

SCALE: 1/8" = 1'-0"
12' 0" 5' 0" 10' 0" 15'


SYMBOL	ZONE	DESCRIPTION	DATE	BY
		REVISIONS		

WURZ WISECARVER & PRUETT ARCHITECT - ENGINEERS ATLANTA, GEORGIA		U.S. ARMY ENGINEER DISTRICT, SAVANNAH CORPS OF ENGINEERS SAVANNAH, GEORGIA	
ROBINS AIR FORCE BASE, GEORGIA			
SIZE F	INVESTIGATION NO. DACA26-65-9-0090	DRAWING NO. 39-01-08	PLATE M-24
SCALE: AS SHOWN		SHEET 77	

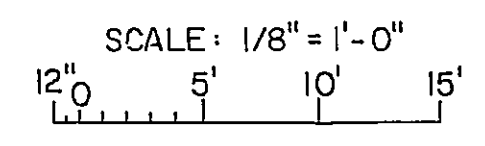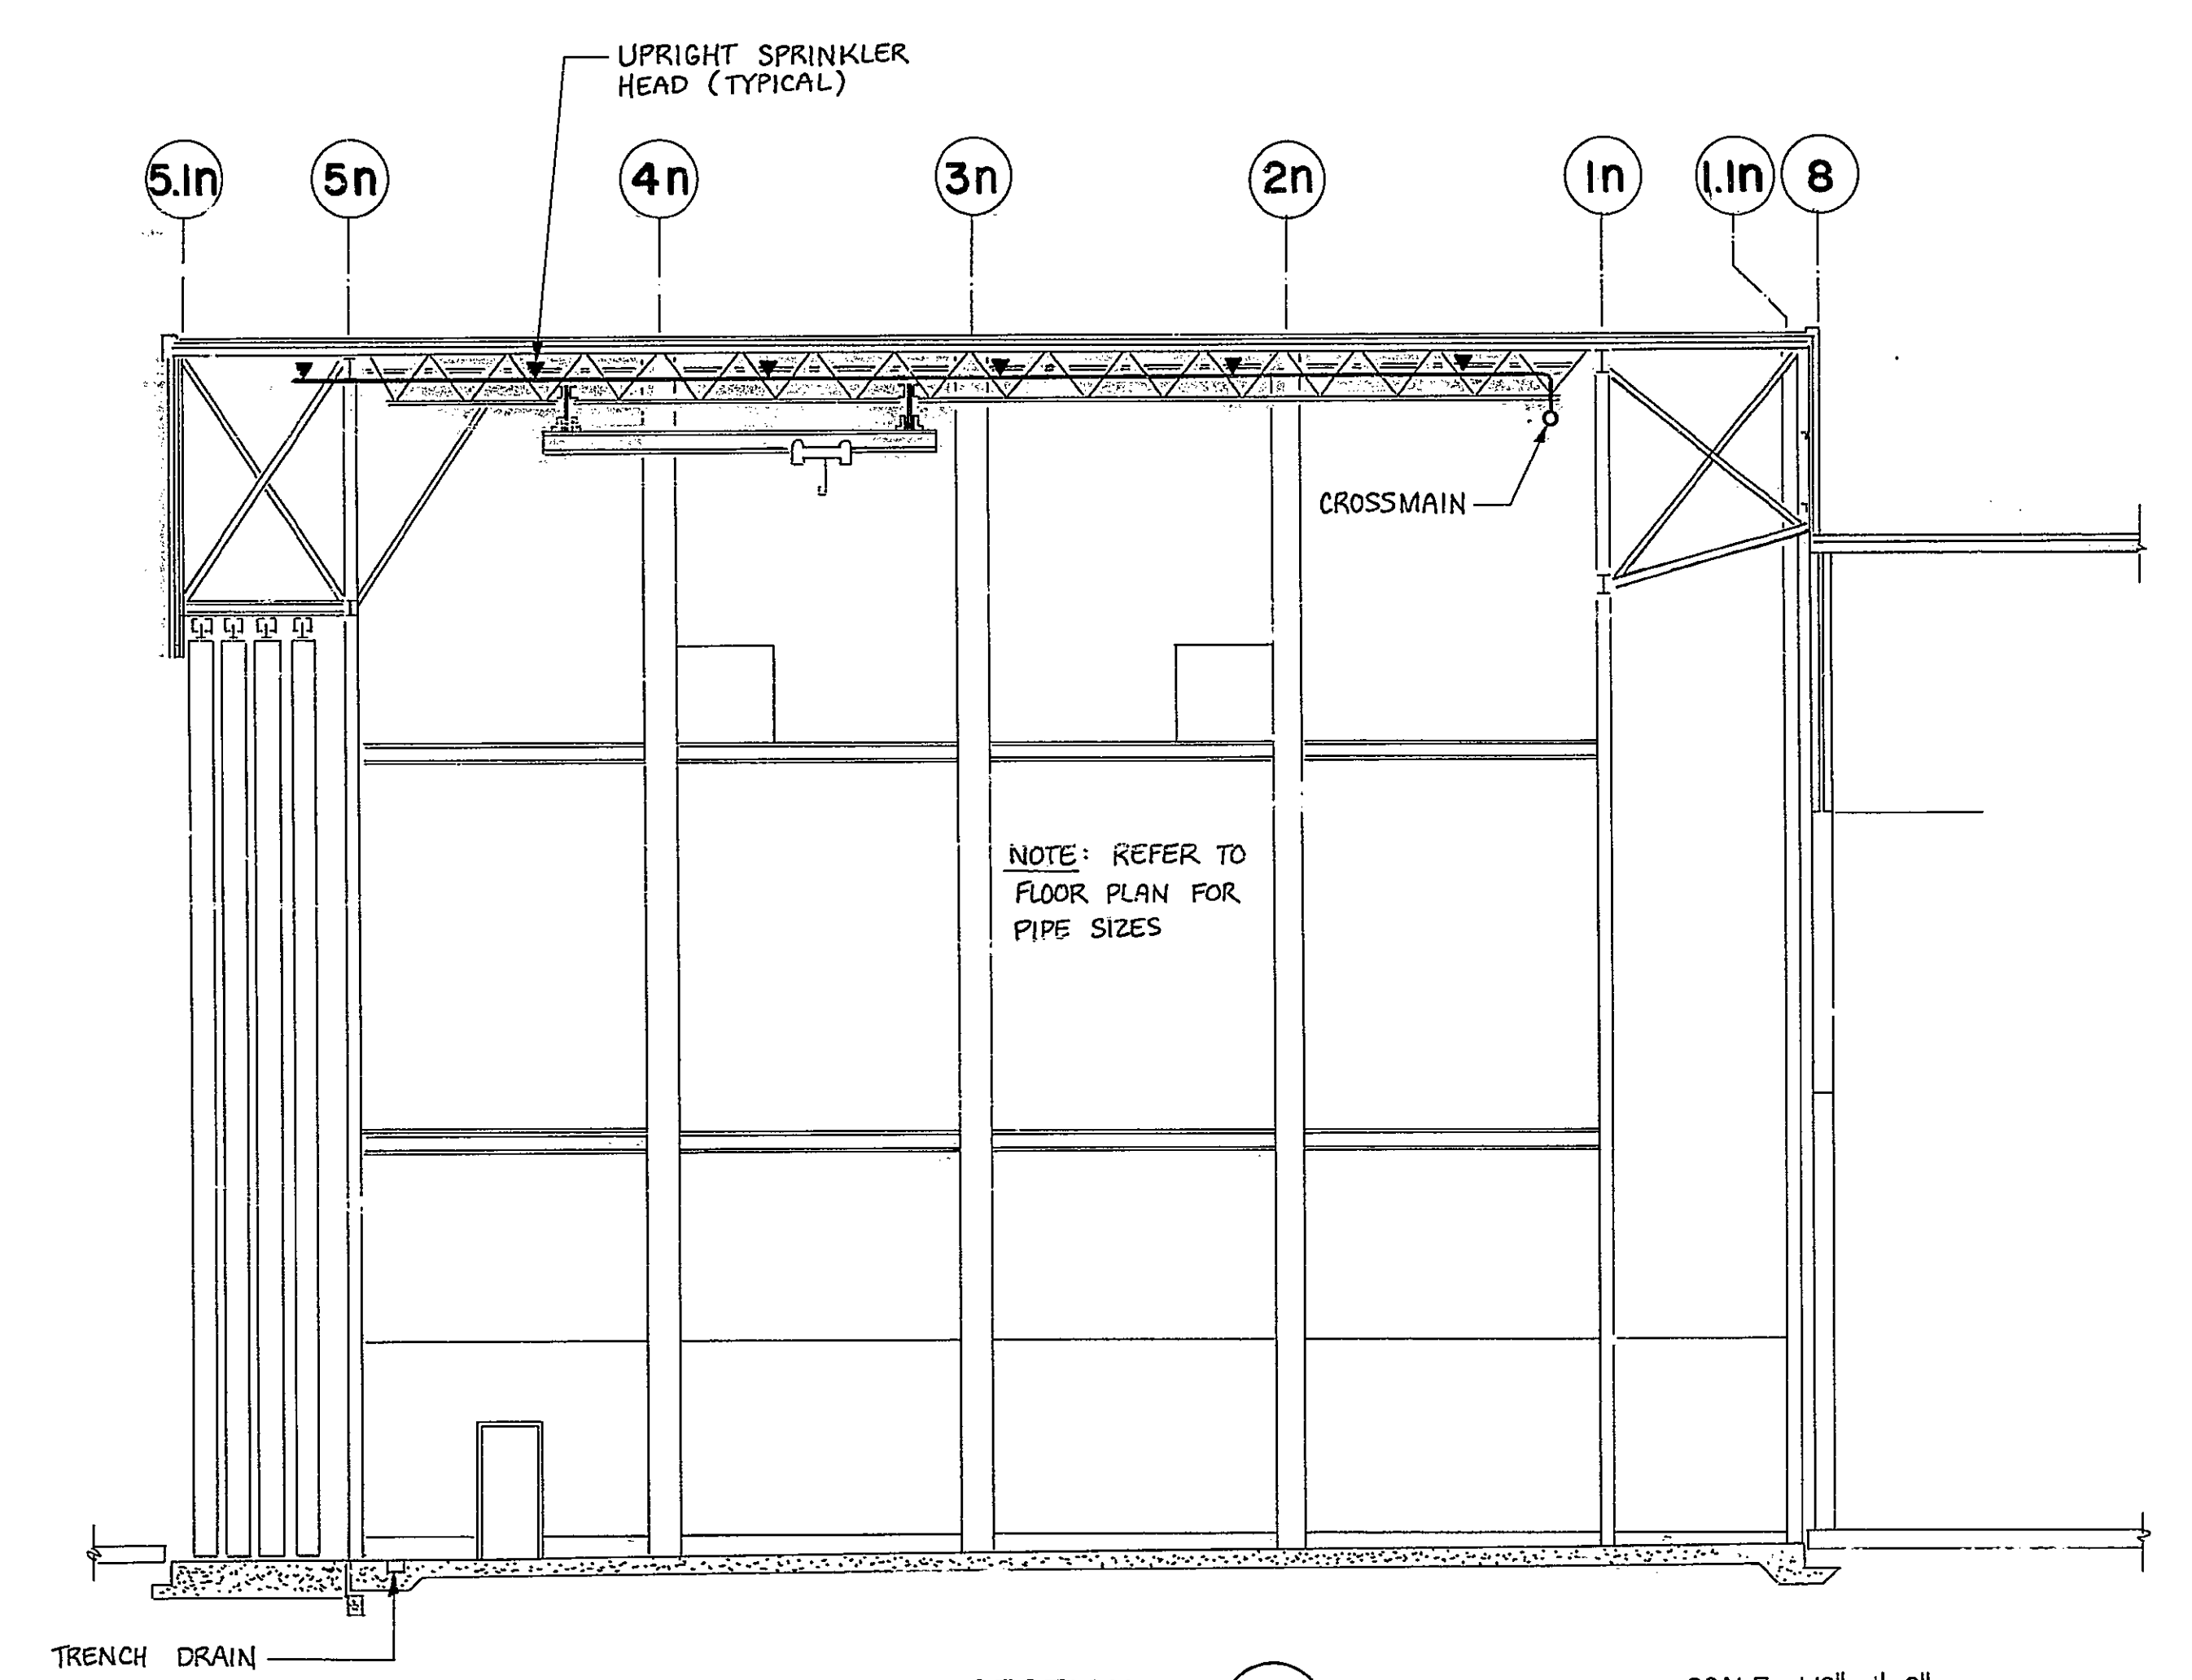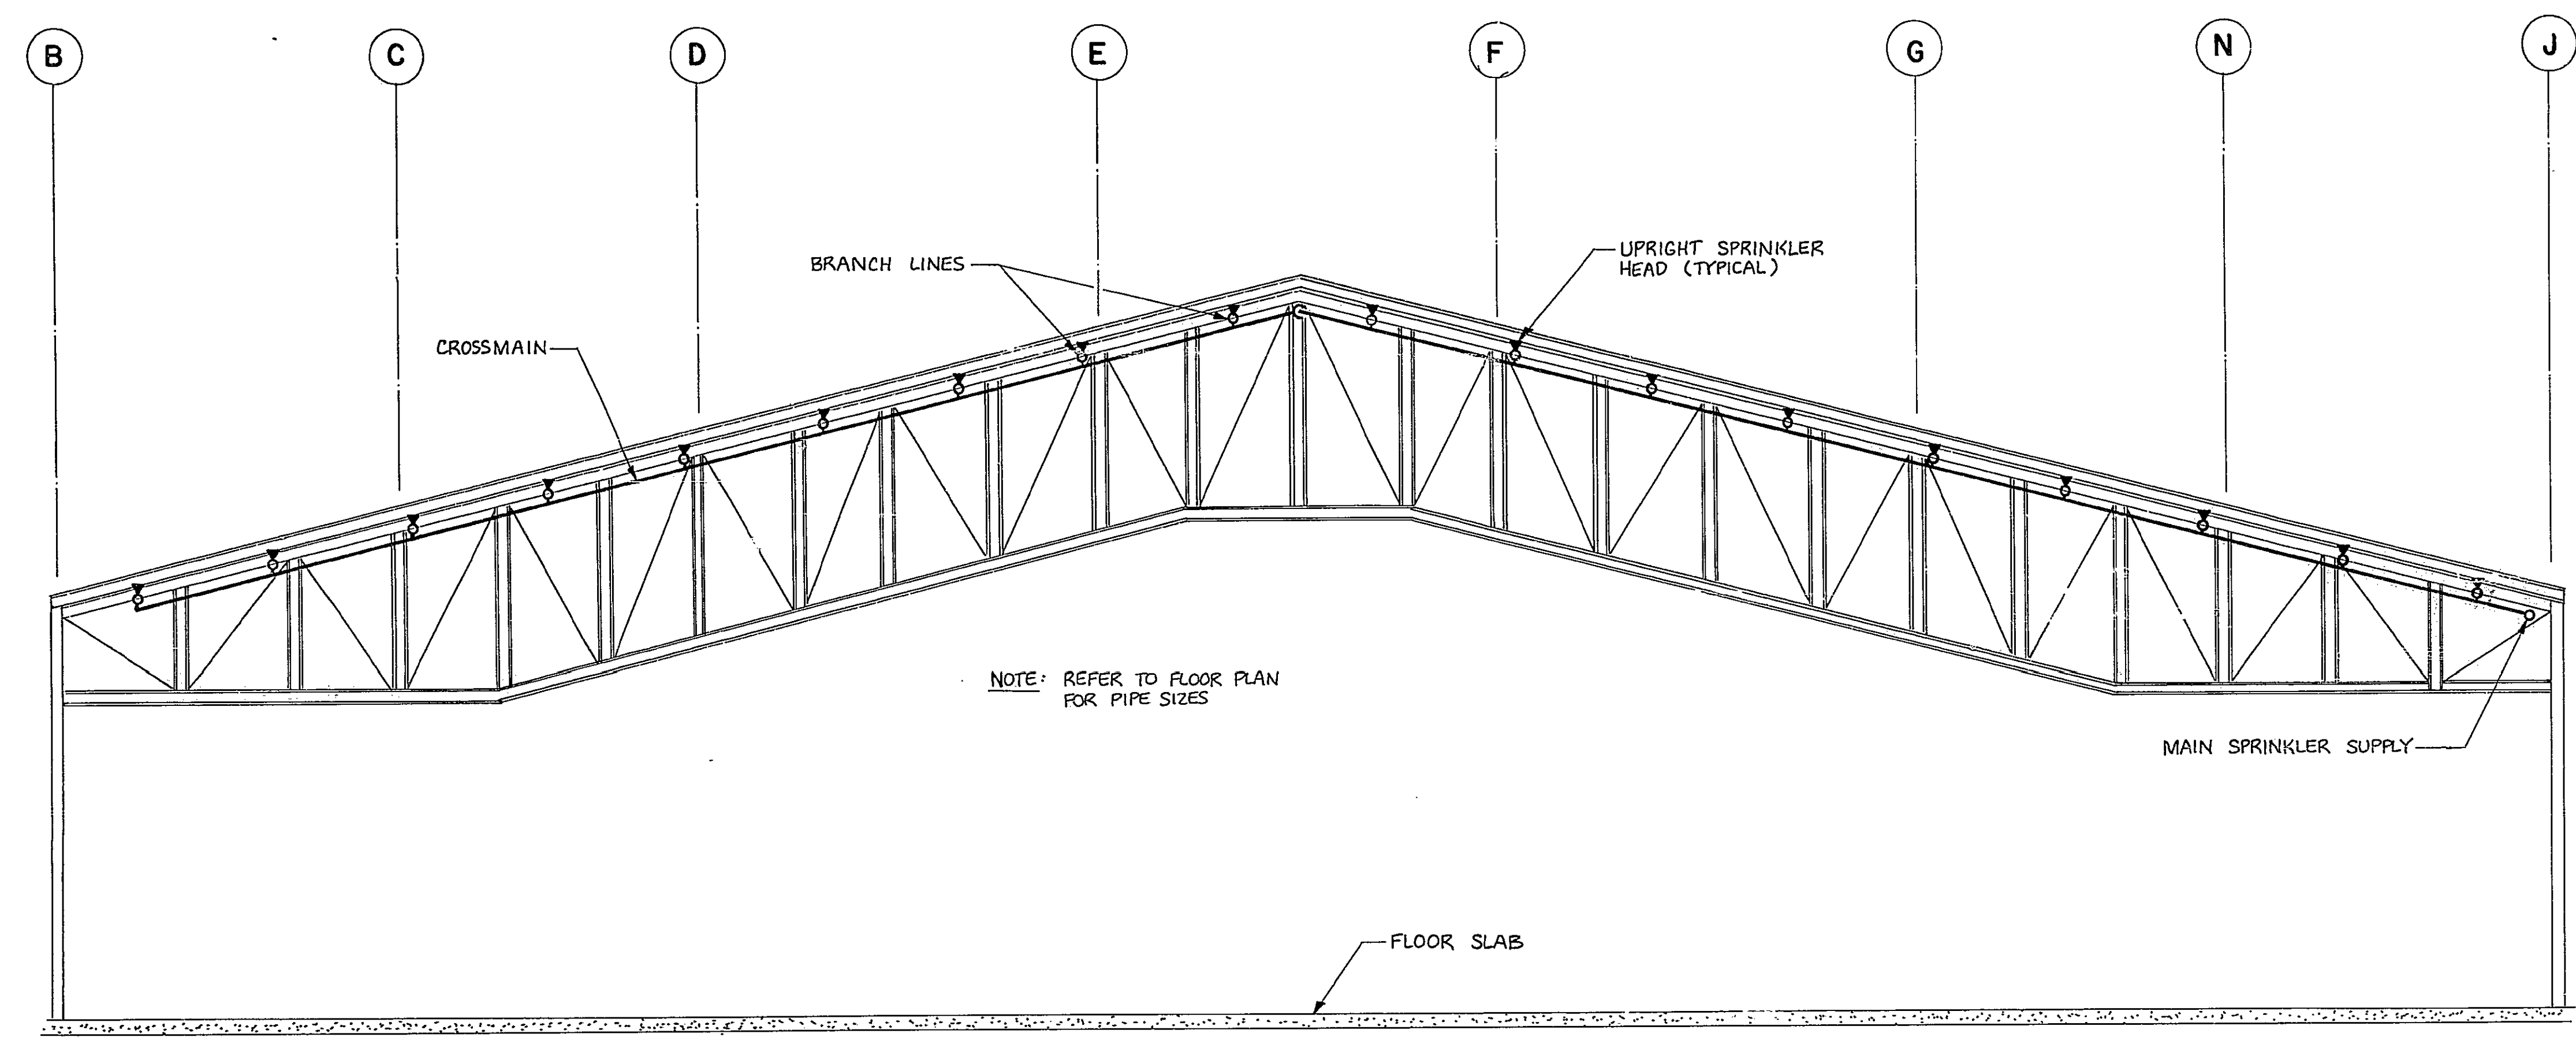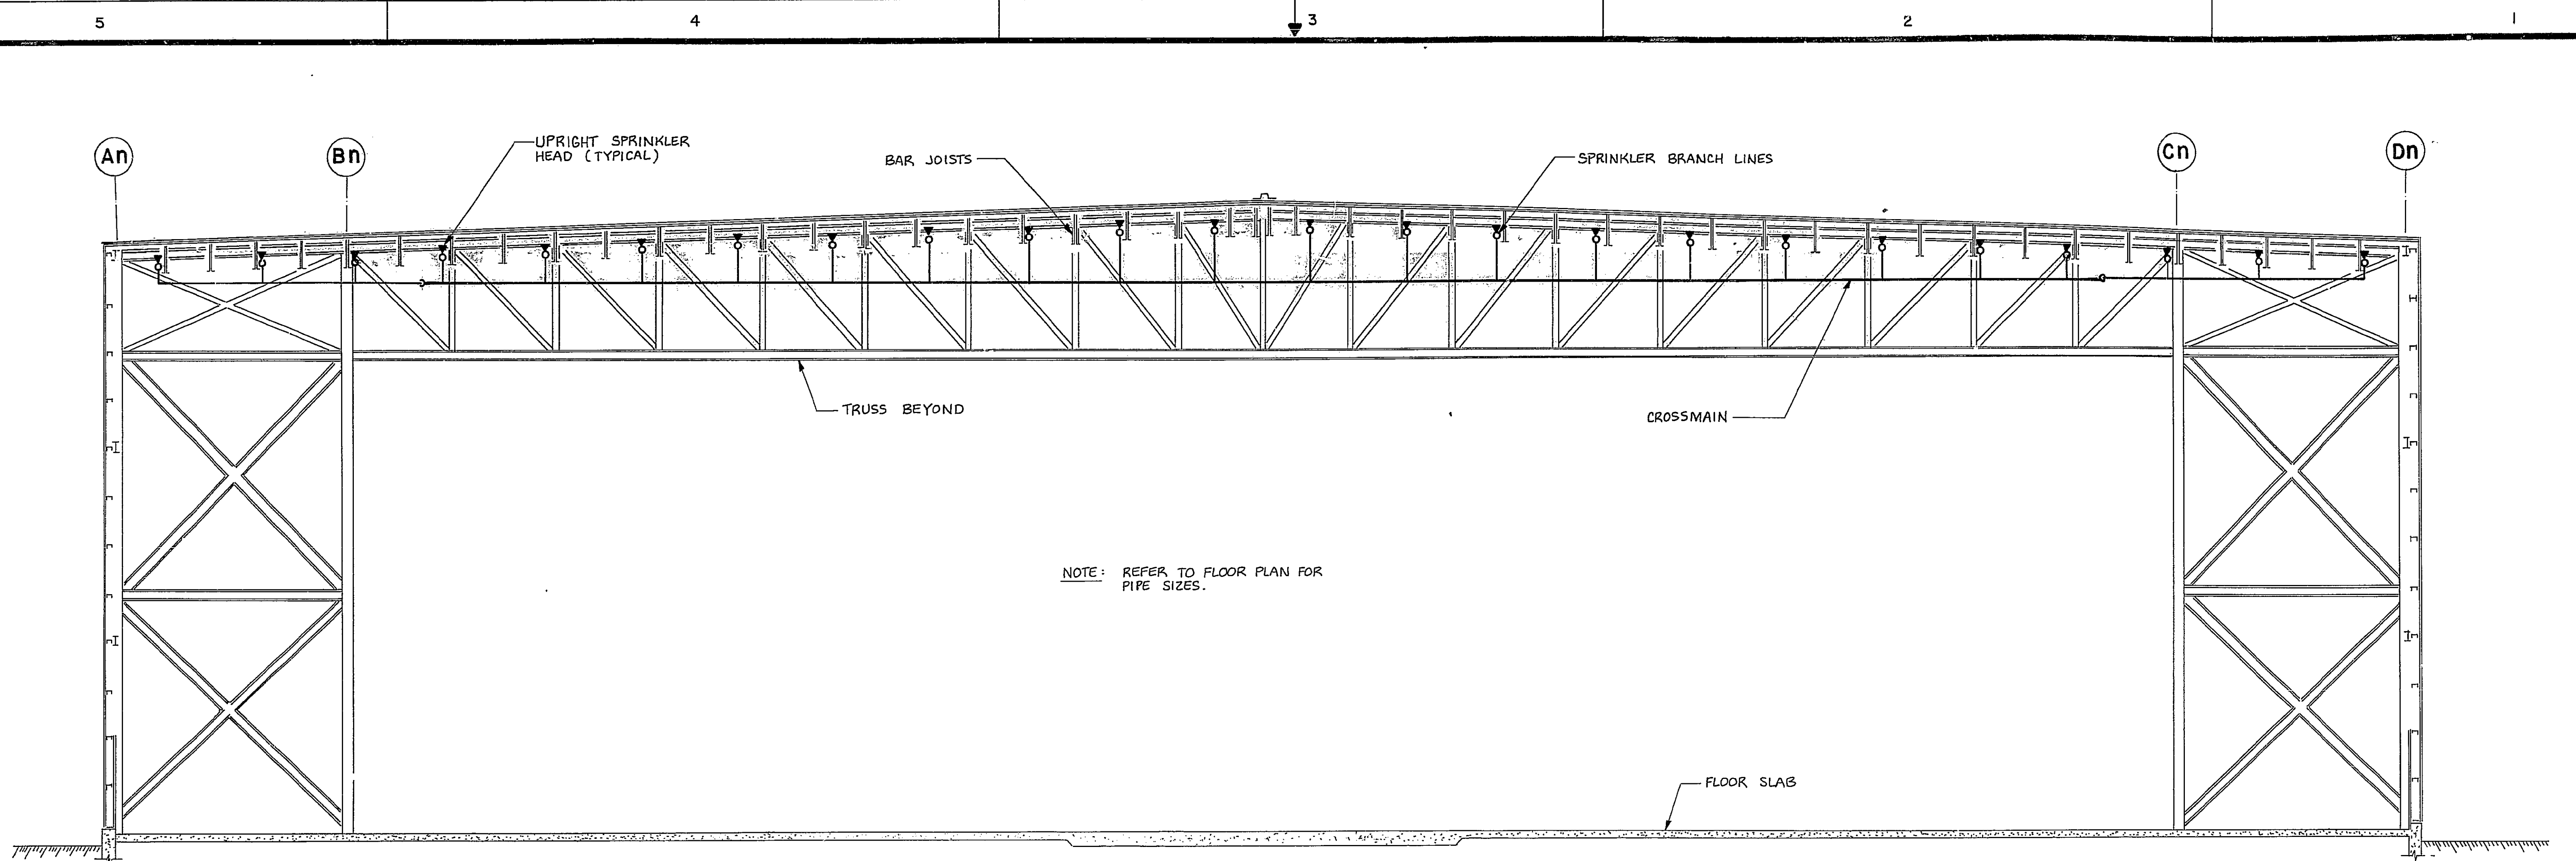


SYMBOL	ZONE	DESCRIPTION	DATE	BY

WURZ WISECARVER & PRUETT ARCHITECT - ENGINEERS ATLANTA, GEORGIA		U.S. ARMY ENGINEER DISTRICT, SAVANNAH CORPS OF ENGINEERS SAVANNAH, GEORGIA	
NOSE DOCK EMPENNAGE ENCLOSURE			
FIRE PROTECTION DETAILS			
ROBINS AIR FORCE BASE		GEORGIA	
SIZE	INVESTIGATION NO.	DRAWING NO.	PLATE
F	DACA2789-B-0090	39-01-08	M-23
SCALE: AS SHOWN			SHEET 76

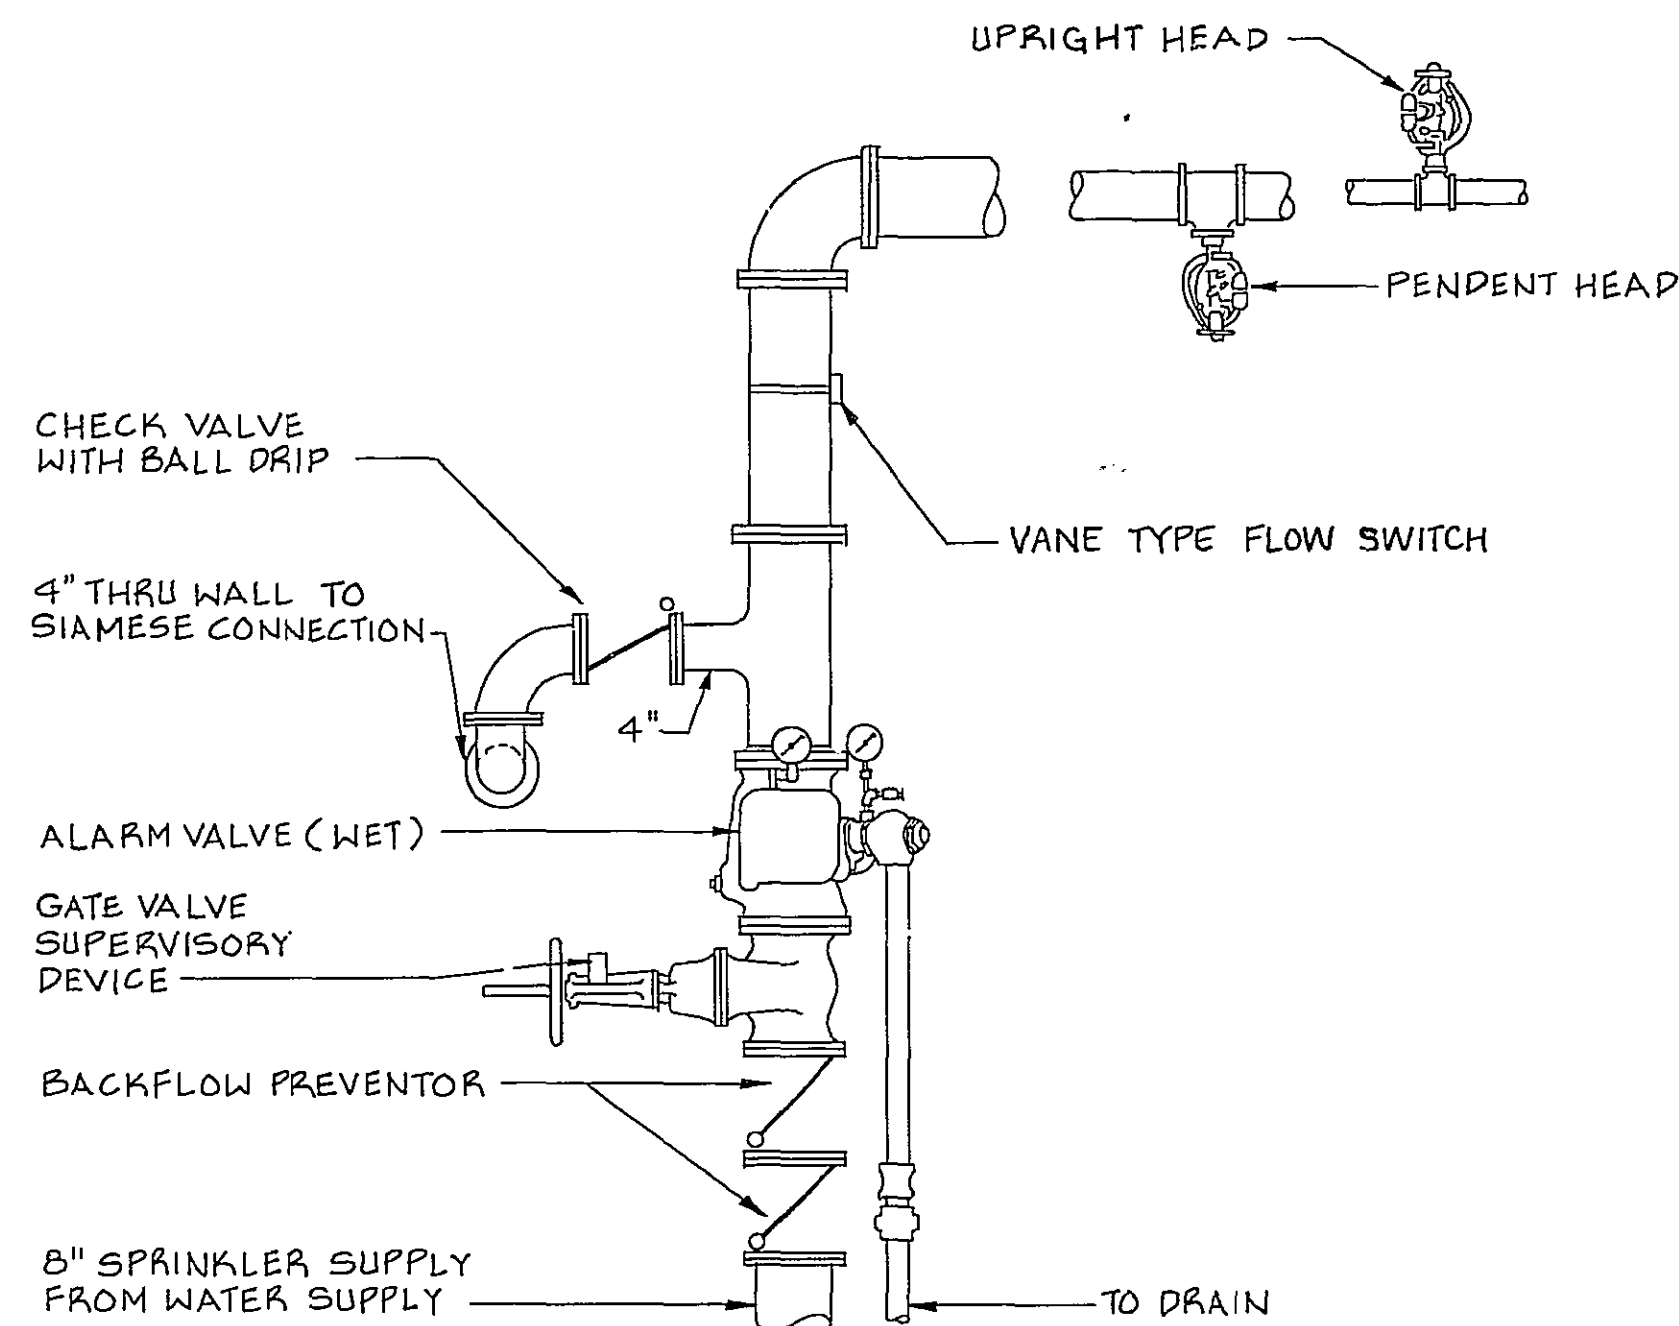


SPRINKLER SUPPLY DETAIL
NOT TO SCALE

1
M-13 M-22
M-15
M-16
M-18
M-20

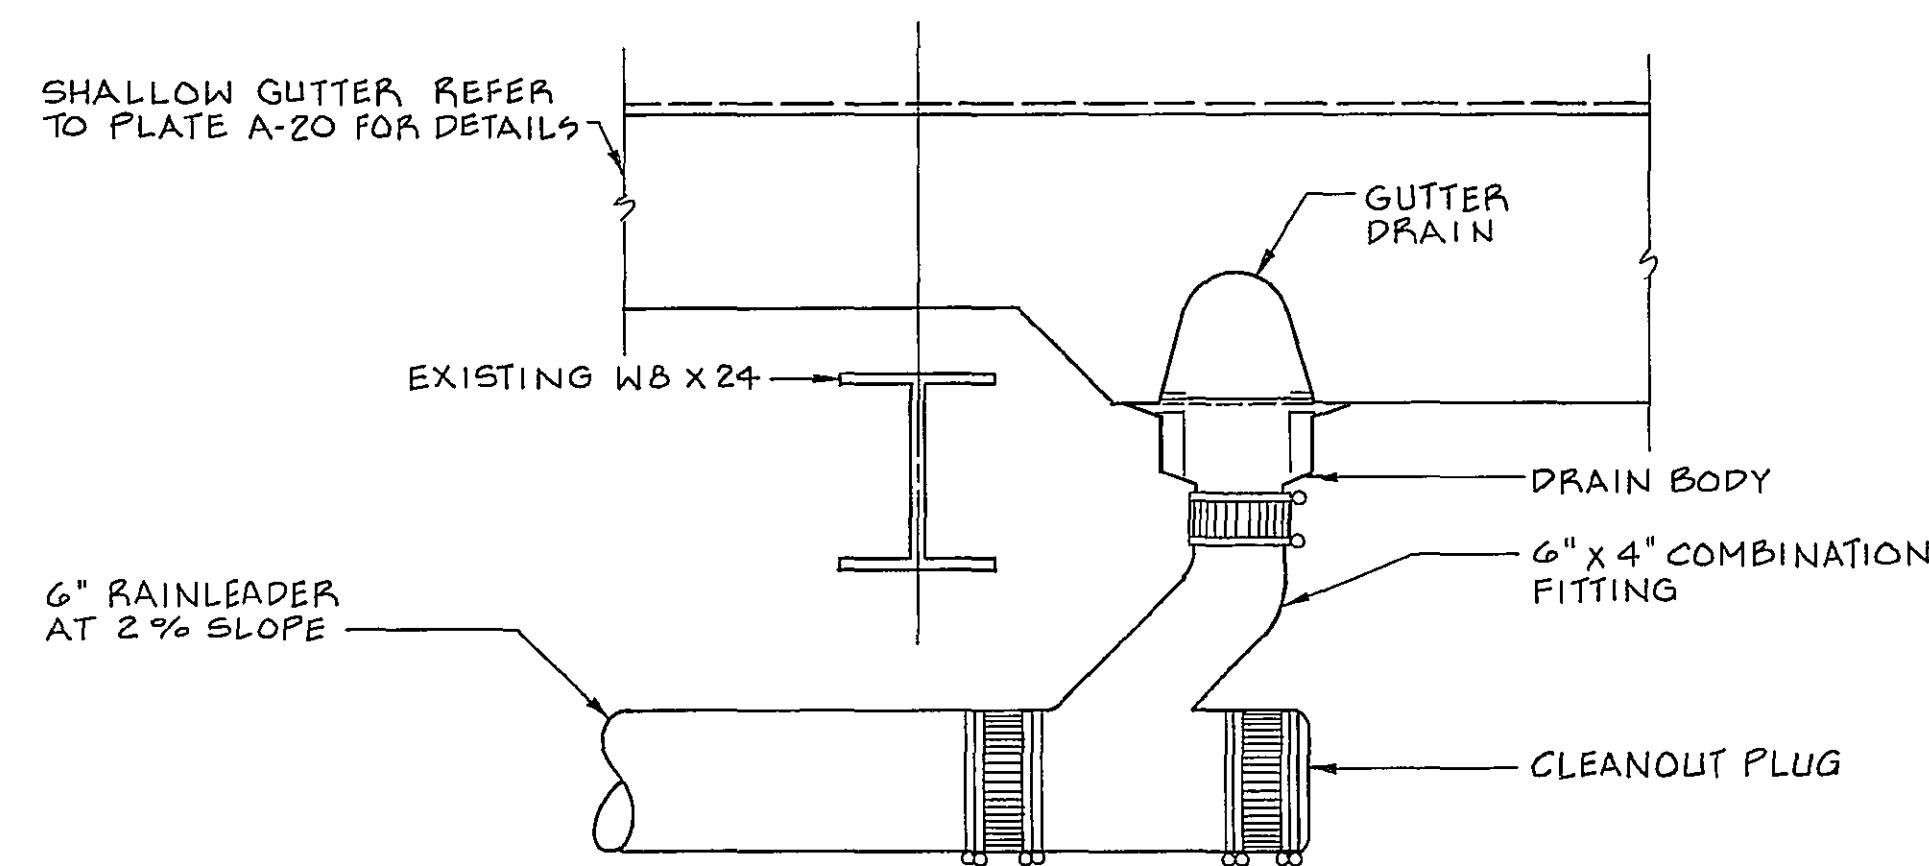


GUTTER DRAIN DETAIL
NOT TO SCALE
BUILDINGS 47, 48 & 49

4
M-9 M-22
M-10
M-11

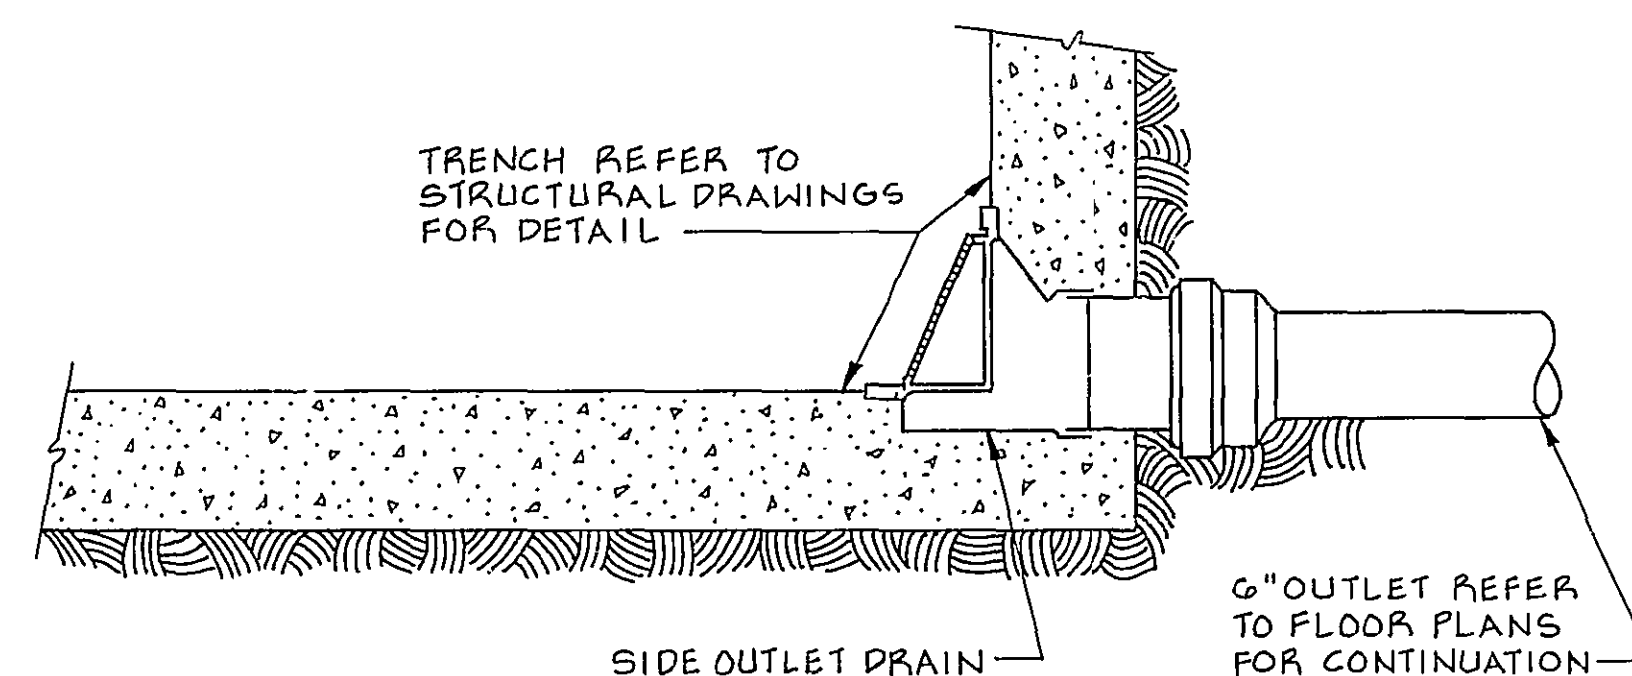


TRENCH DRAIN DETAIL
NOT TO SCALE

2
M-7 M-22
M-8
M-9
M-10
M-11

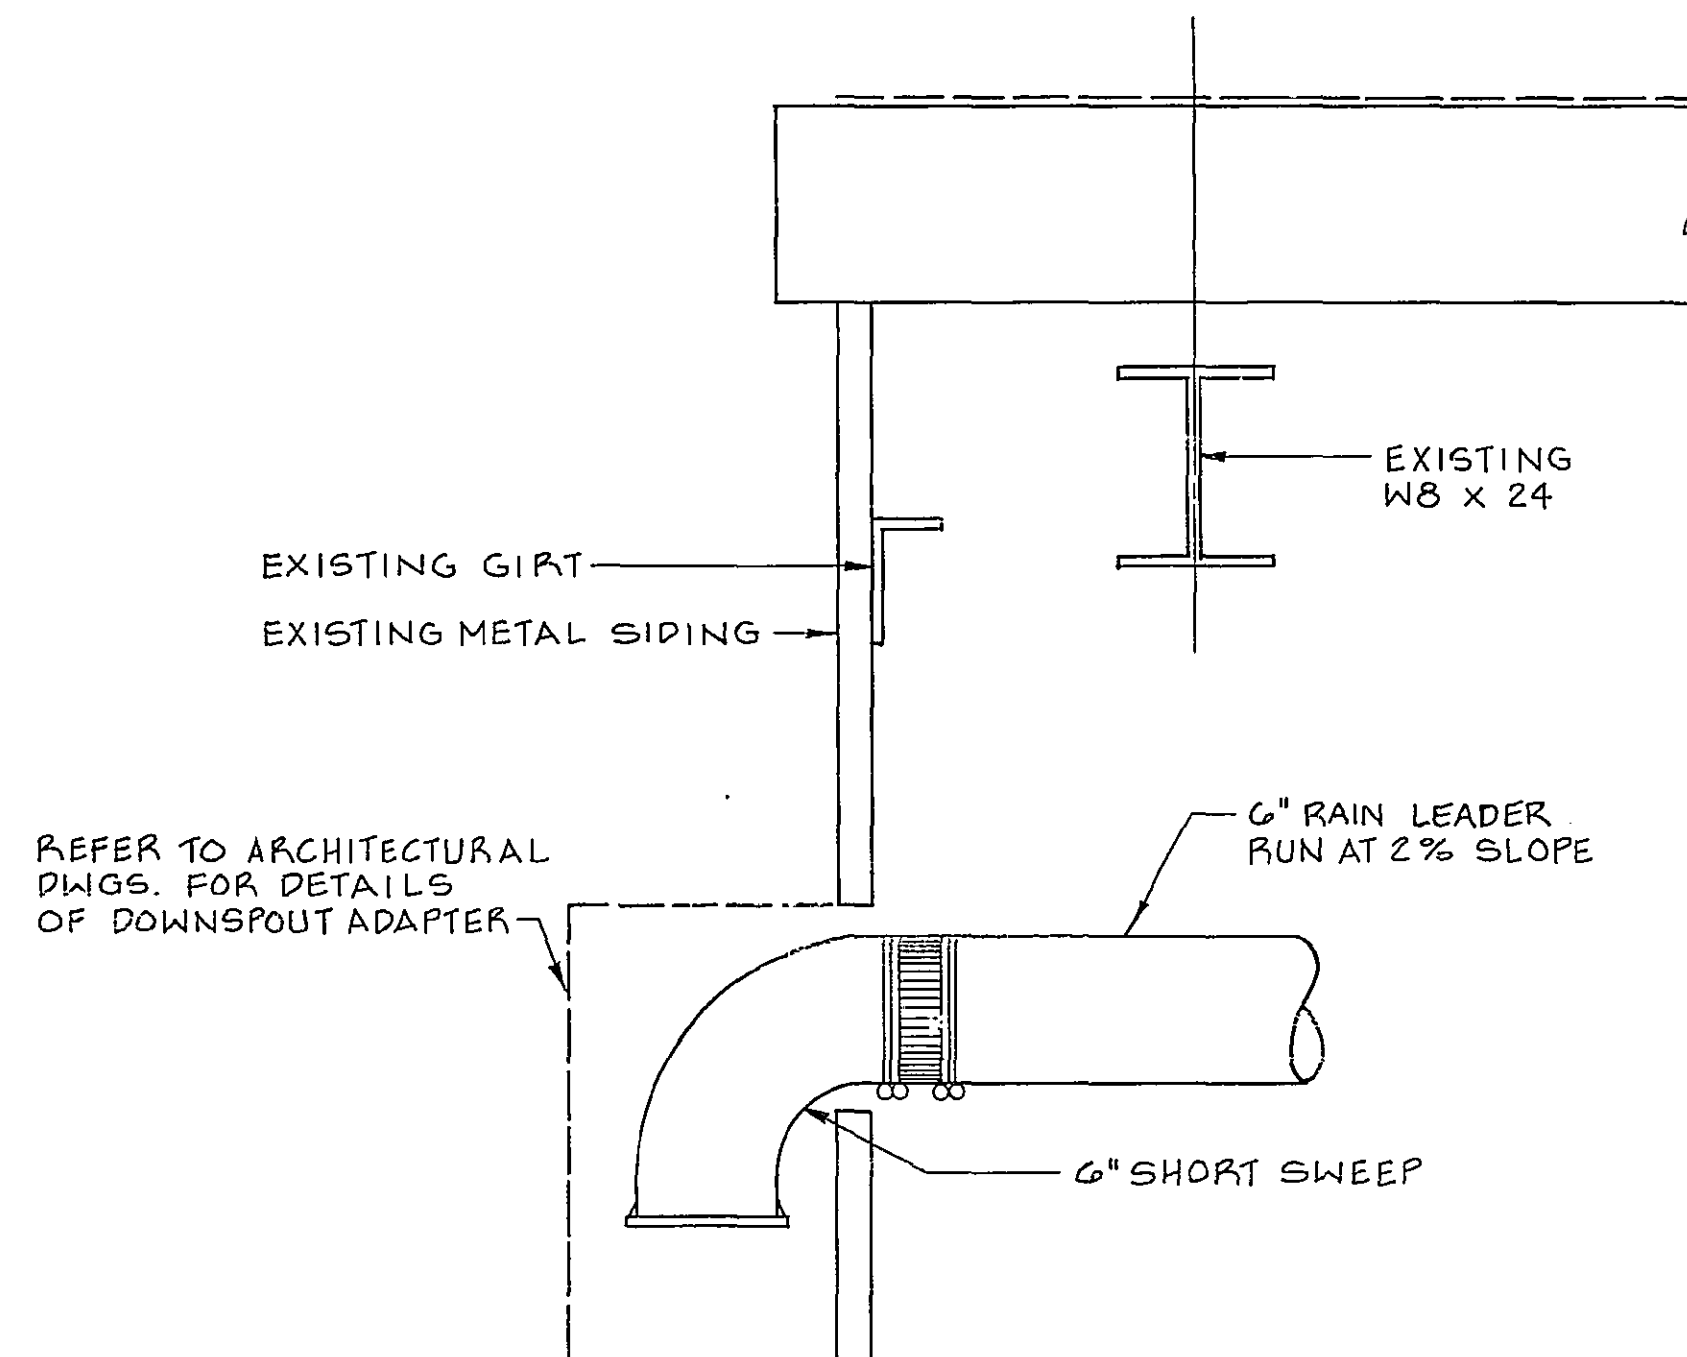

STORM LEADER DETAIL
NOT TO SCALE
BUILDINGS 47, 48 & 49

5
M-9 M-22
M-10
M-11

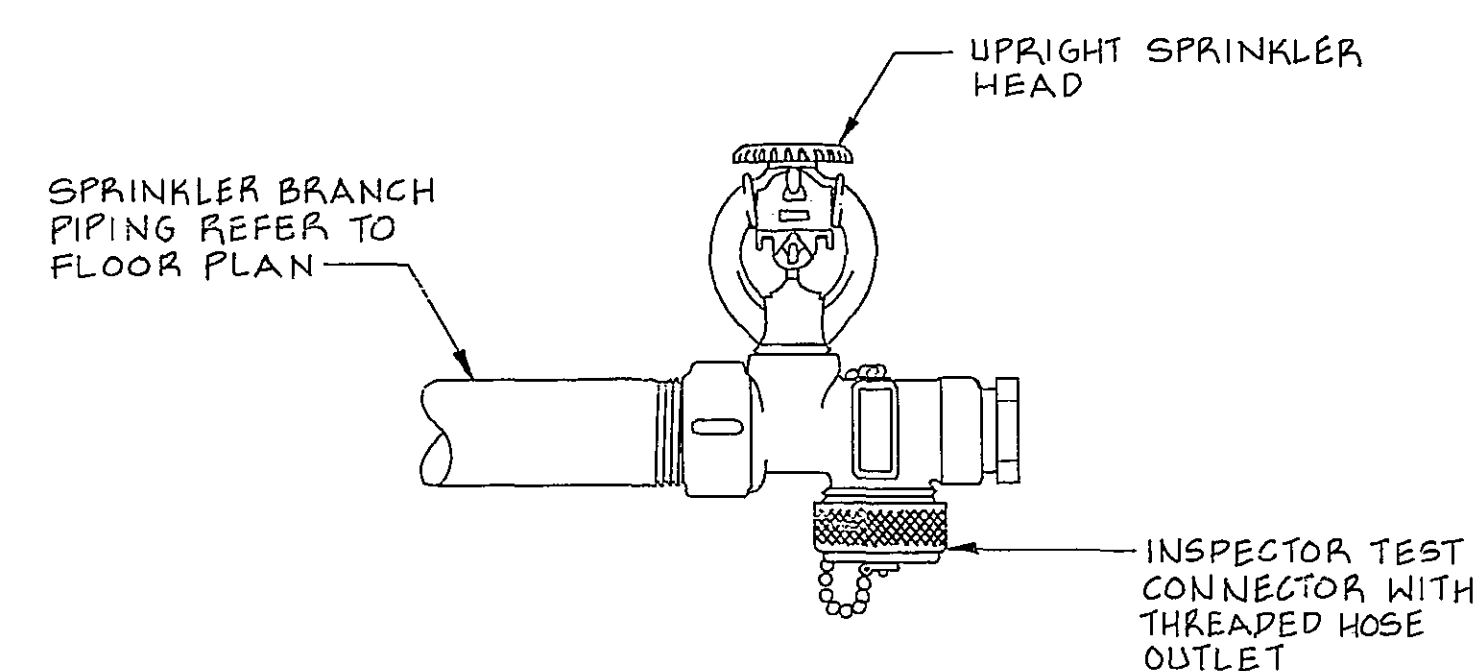

INSPECTOR TEST DETAIL
NOT TO SCALE

6
M-12 M-22
M-14
M-15
M-16
M-20


LEGEND

WASTE LINE	---
VENT	---
SPRINKLER MAIN	— S —
BRANCH AND HEADS	— O — O —
ELBOW - TURNED DOWN	— G —
ELBOW-TURNED UP	— O —
FLOOR DRAIN	— □ —
SPRINKLER HEAD	— ▲ —
SPRINKLER RISER AND SIZE	— ⊗ —
SWING CHECK	— Z —
PRESSURE GAGE	— ⊕ —
VENT THRU ROOF	— VTR —
ROOF DRAINAGE	— RD —
INDUSTRIAL WASTE	— IW —
CARBON DIOXIDE HAND HOSE STATION	— CO ₂ —

SYMBOL	ZONE	DESCRIPTION	DATE	BY

WURZ WISECARVER PRUETT ARCHITECT - ENGINEERS ATLANTA, GEORGIA		U. S. ARMY ENGINEER DISTRICT, SAVANNAH CORPS OF ENGINEERS SAVANNAH, GEORGIA	
NOSE DOCK EMPENNAGE ENCLOSURE			
PLUMBING AND FIRE PROTECTION DETAILS			
ROBIN AIR FORCE BASE		GEORGIA	
SIZE	INVITATION NO.	DRAWING NO.	PLATE
F	DAC21-85-B-0090	39-01-08	M-22
SCALE AS SHOWN		SHEET 75	

REFER TO PLATE M-22 FOR LEGEND

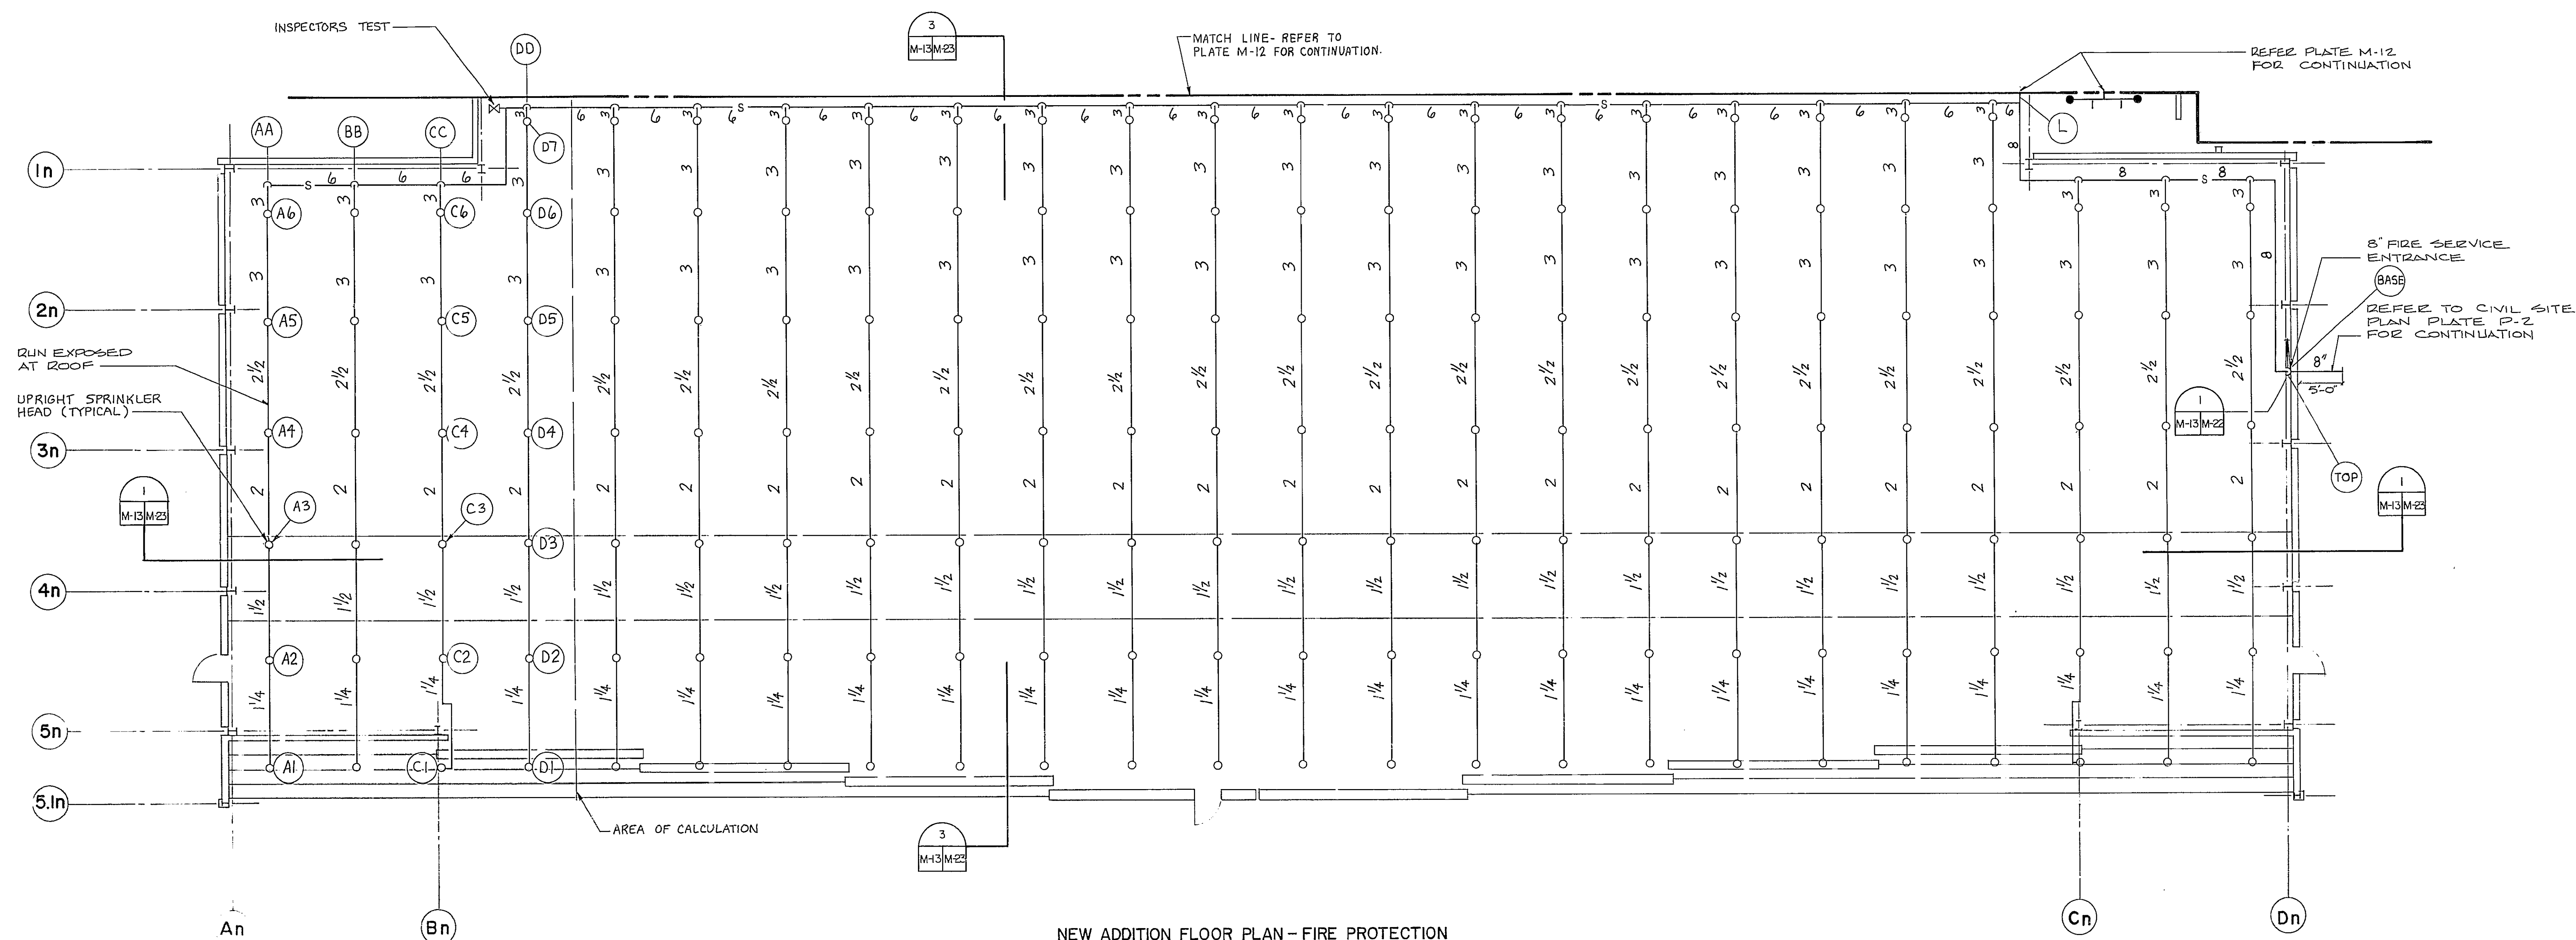

NEW ADDITION FLOOR PLAN - FIRE PROTECTION
SCALE: 1/8" = 1'-0"


SPRINKLER SYSTEM IS BASED ON
ORDINARY HAZARD OCCUPANCY.
DESIGN DENSITY SHALL BE
GPM PER SQ. FT. FOR AN AREA
OF DEMAND OF 3000 SQUARE
FEET. IN ADDITION SUPPLY SHALL
BE CAPABLE OF 350 GPM HOSE
STREAM ALLOWANCE.

SCALE: 1/8" = 1'-0"
12' 6' 3' 0' 15'

SYMBOL	ZONE	DESCRIPTION	DATE	BY
REVISIONS				


WURZ, WISECARVER & PRUETT ARCHITECTS - ENGINEERS ATLANTA, GEORGIA		U. S. ARMY ENGINEER DISTRICT, SAVANNAH CORPS OF ENGINEERS SAVANNAH, GEORGIA	
NOSE DOCK EMPENNAGE ENCLOSURE			
BUILDING 44 FIRE PROTECTION			
ROBINS AIR FORCE BASE		GEORGIA	
SIZE	INVESTIGATION NO.	DRAWING NO.	PLATE
F	DACA 2 85 8 0090	39-01-08	M-13
SCALE AS SHOWN		SHEET 66	

REFER TO PLATE M-22 FOR LEGEND

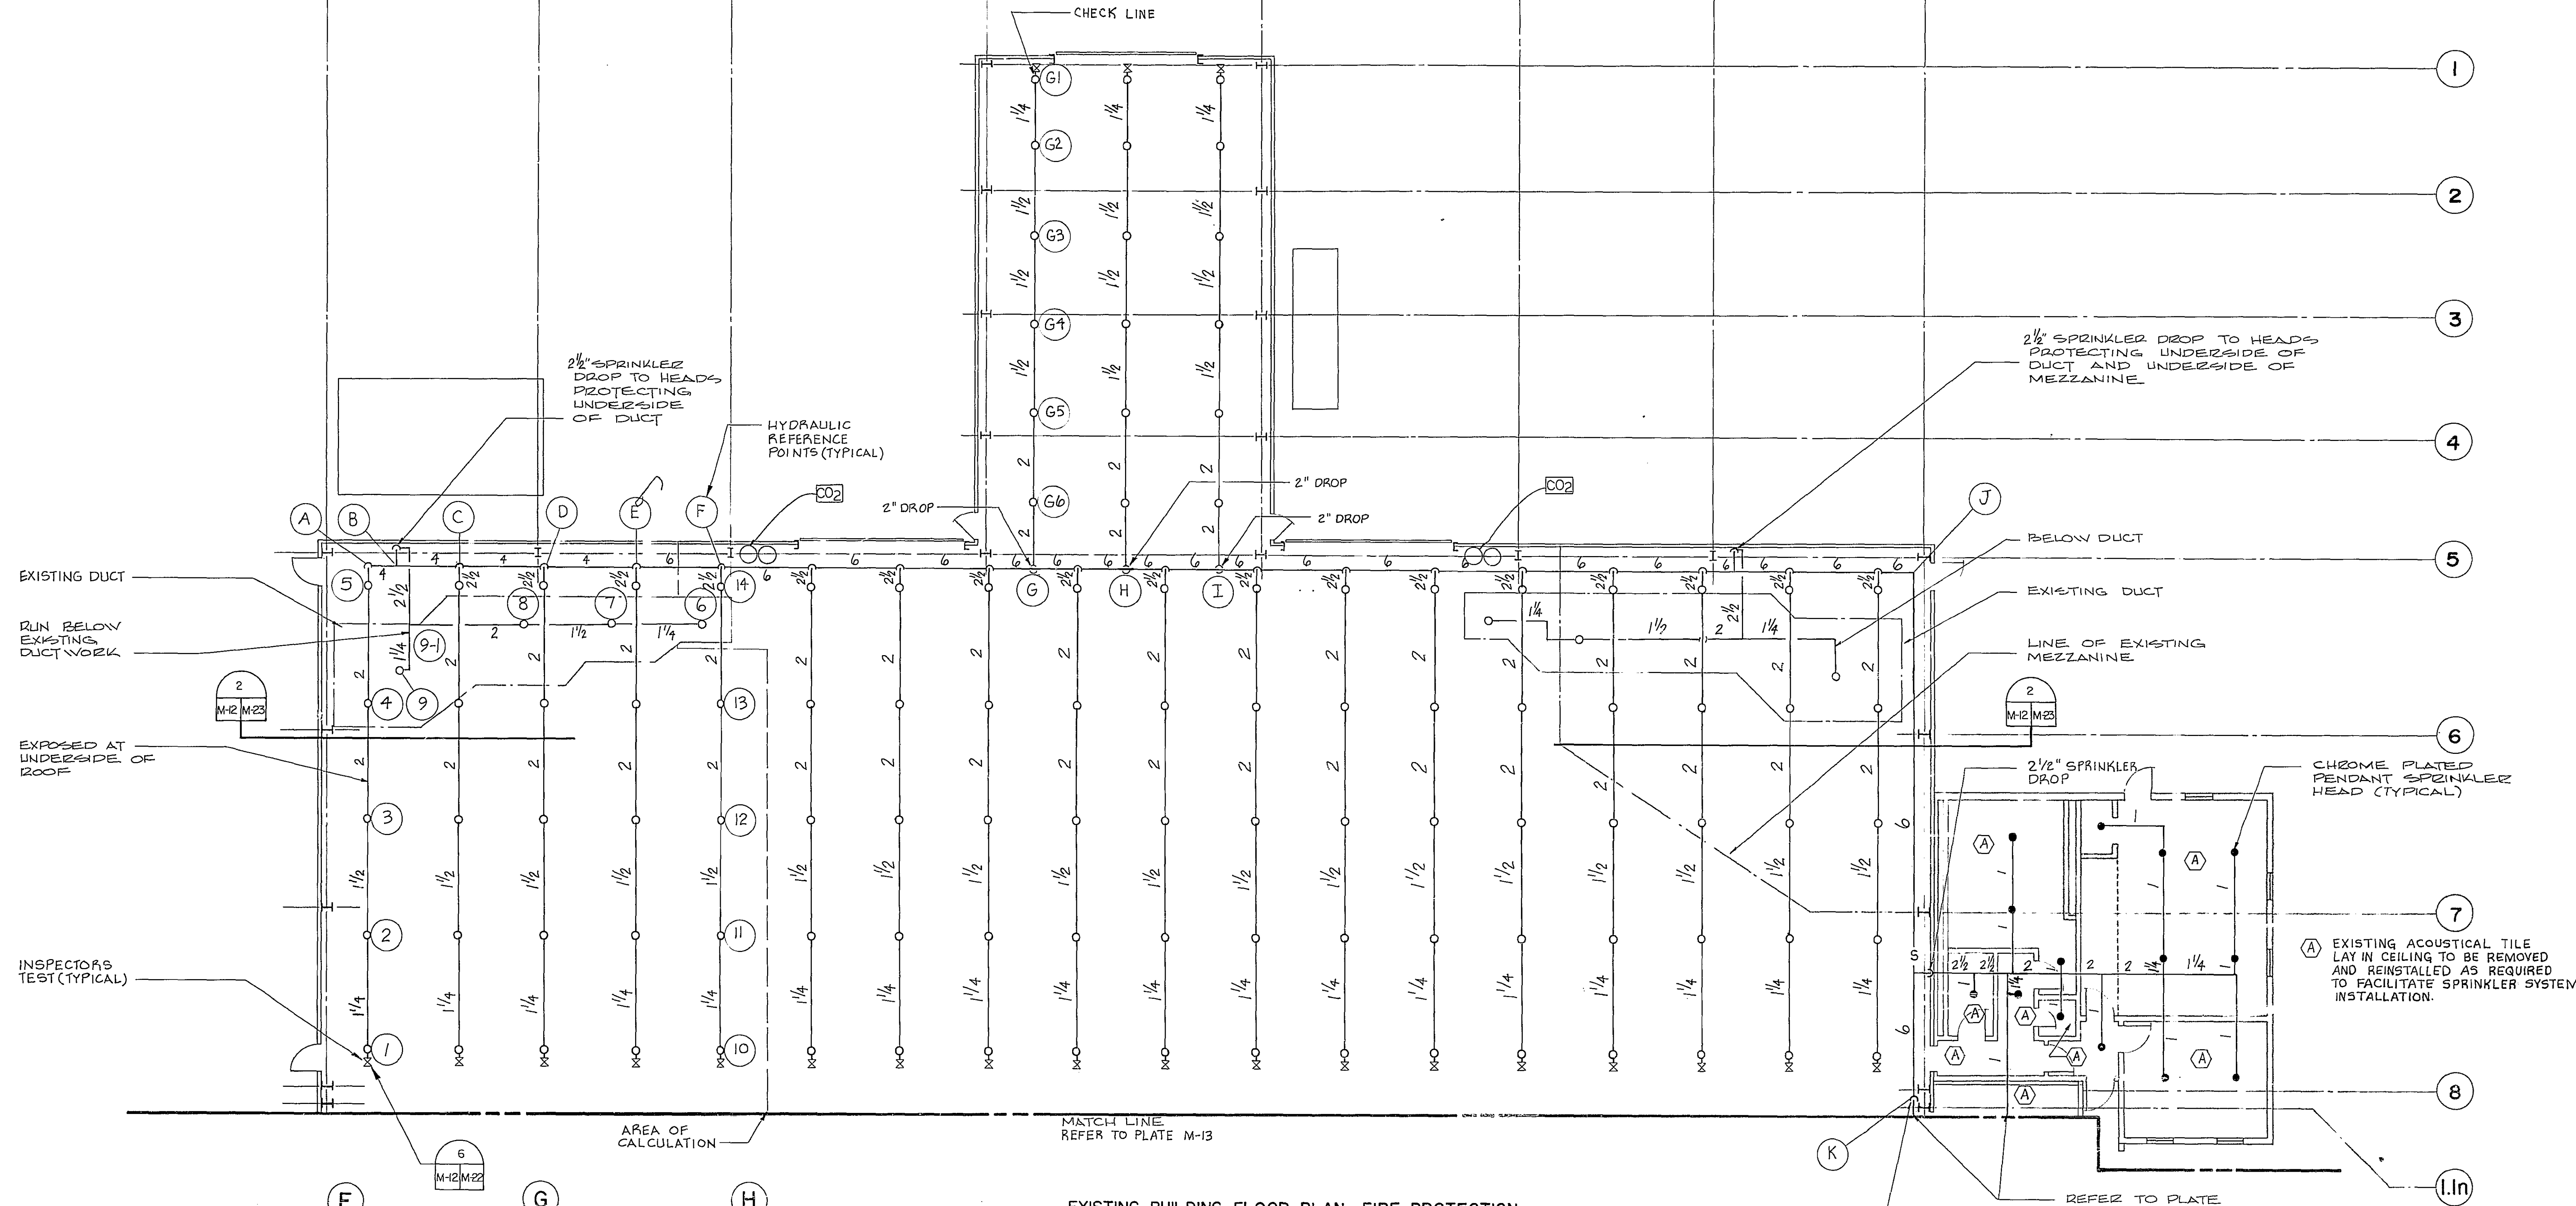

EXISTING BUILDING FLOOR PLAN - FIRE PROTECTION


SCALE: 1/8" = 1'-0"

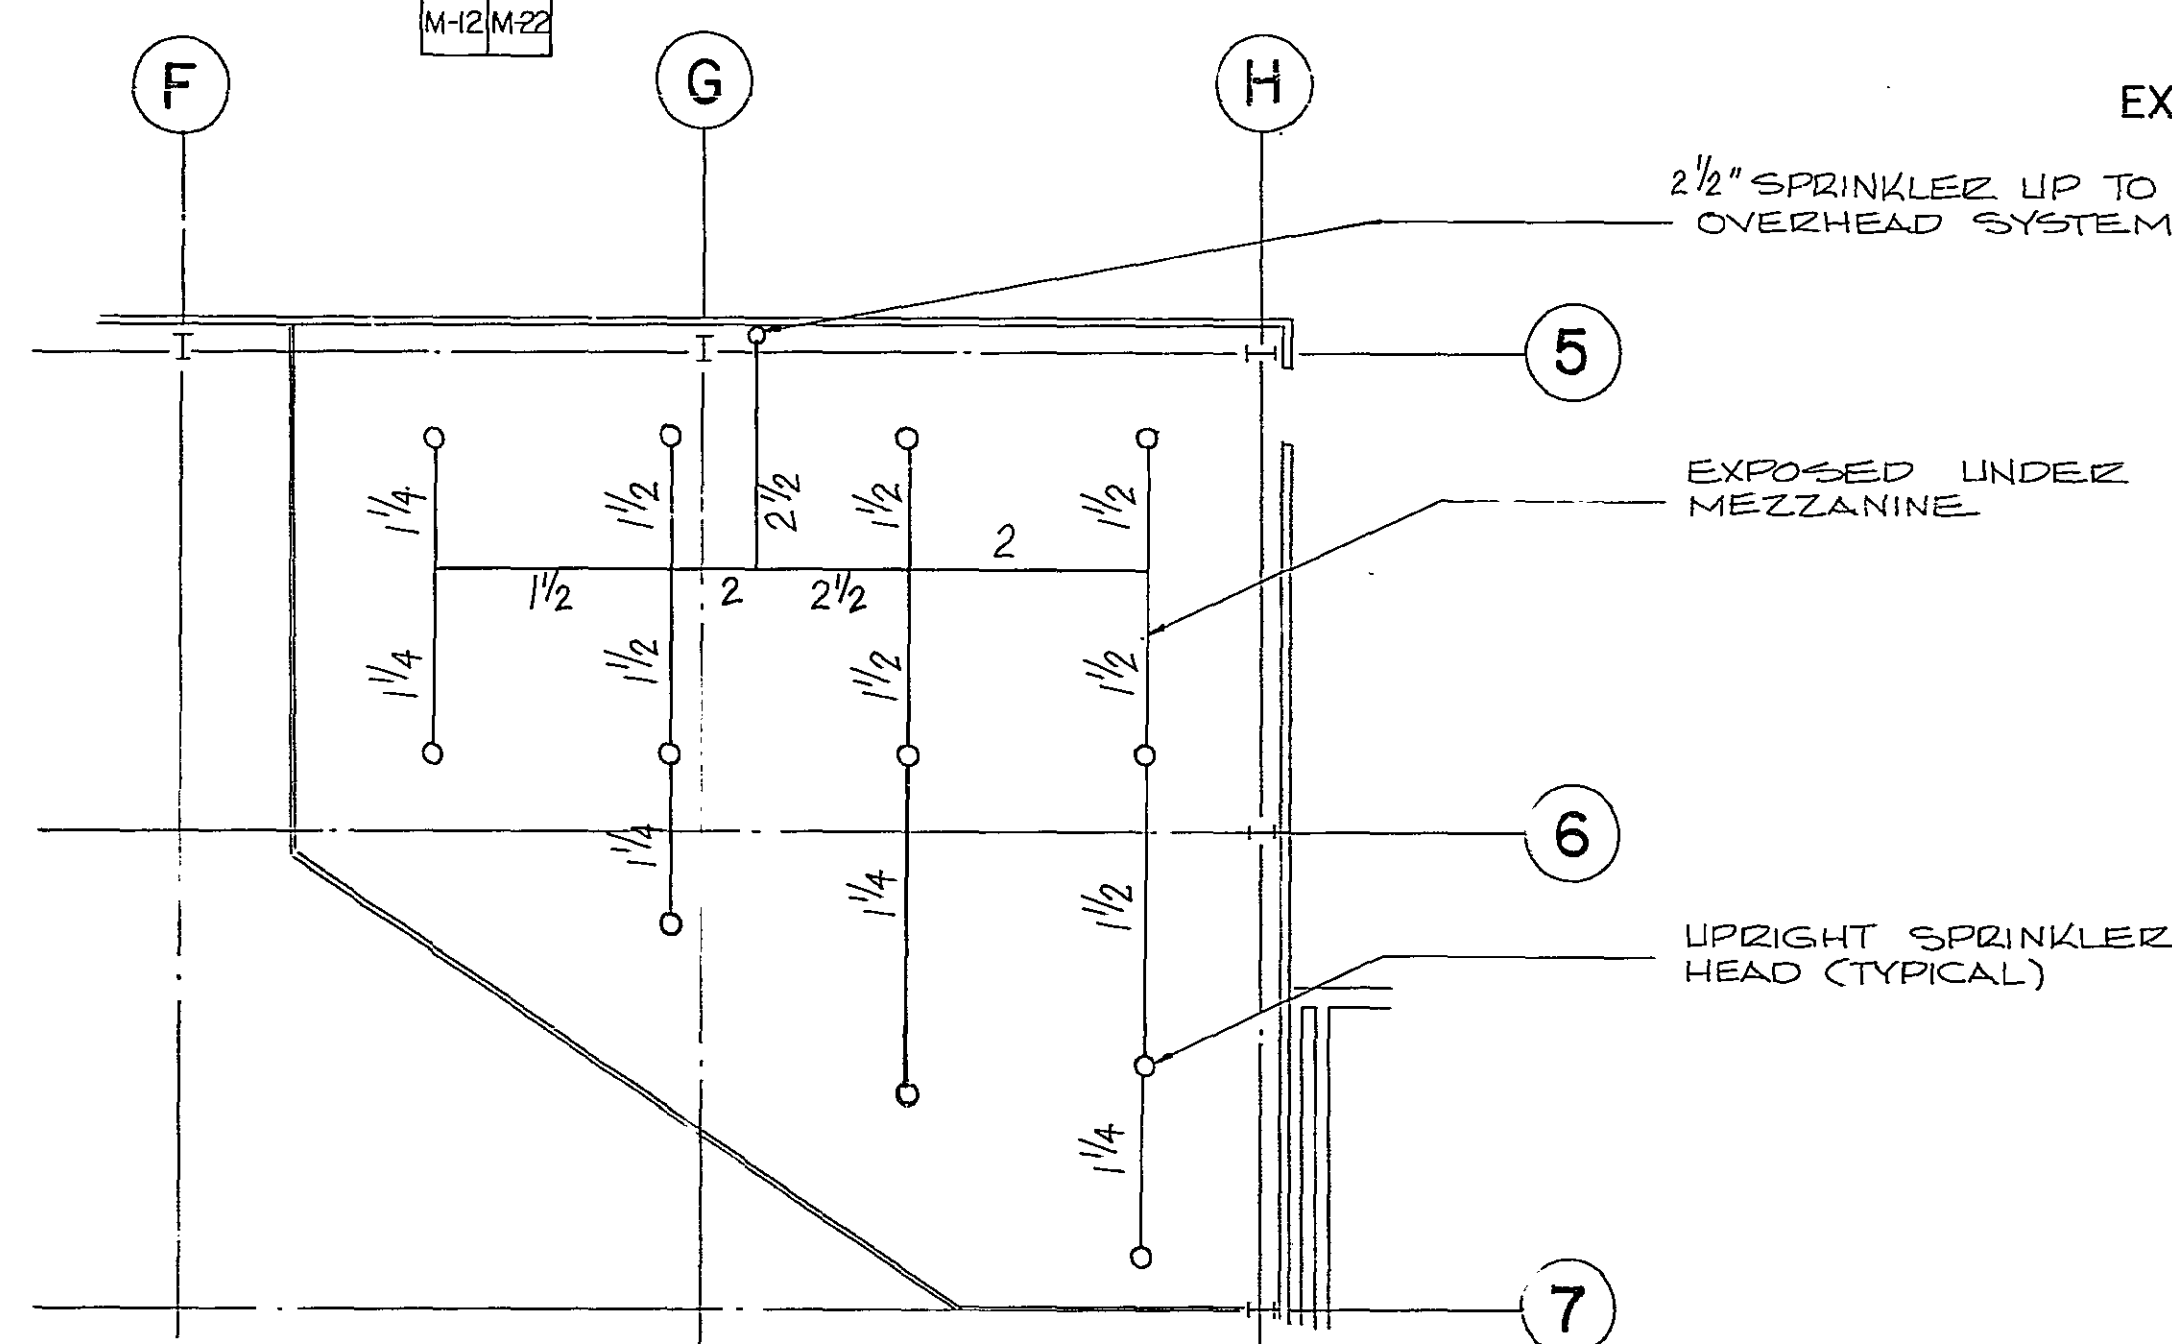

UNDER-MEZZANINE PLAN - FIRE PROTECTION


SCALE: 1/8" = 1'-0"

WURZ, WISECARVER & PRUETT ARCHITECTS - ENGINEERS ATLANTA, GEORGIA		U. S. ARMY ENGINEER DISTRICT, SAVANNAH CORPS OF ENGINEERS SAVANNAH, GEORGIA	
NOSE DOCK EMPENNAGE ENCLOSURE			
BUILDING 44 FIRE PROTECTION			
ROBINS AIR FORCE BASE, GEORGIA			
DATE	INVESTIGATION NO.	DRAWING NO.	PLATE
F	CACA 21 85 B 0090	39-01-08	M-12
SYMBOL		ZONE	REVISIONS
DATE		B	
SCALE		AS SHOWN	
SHEET 65		FORMAT 6	

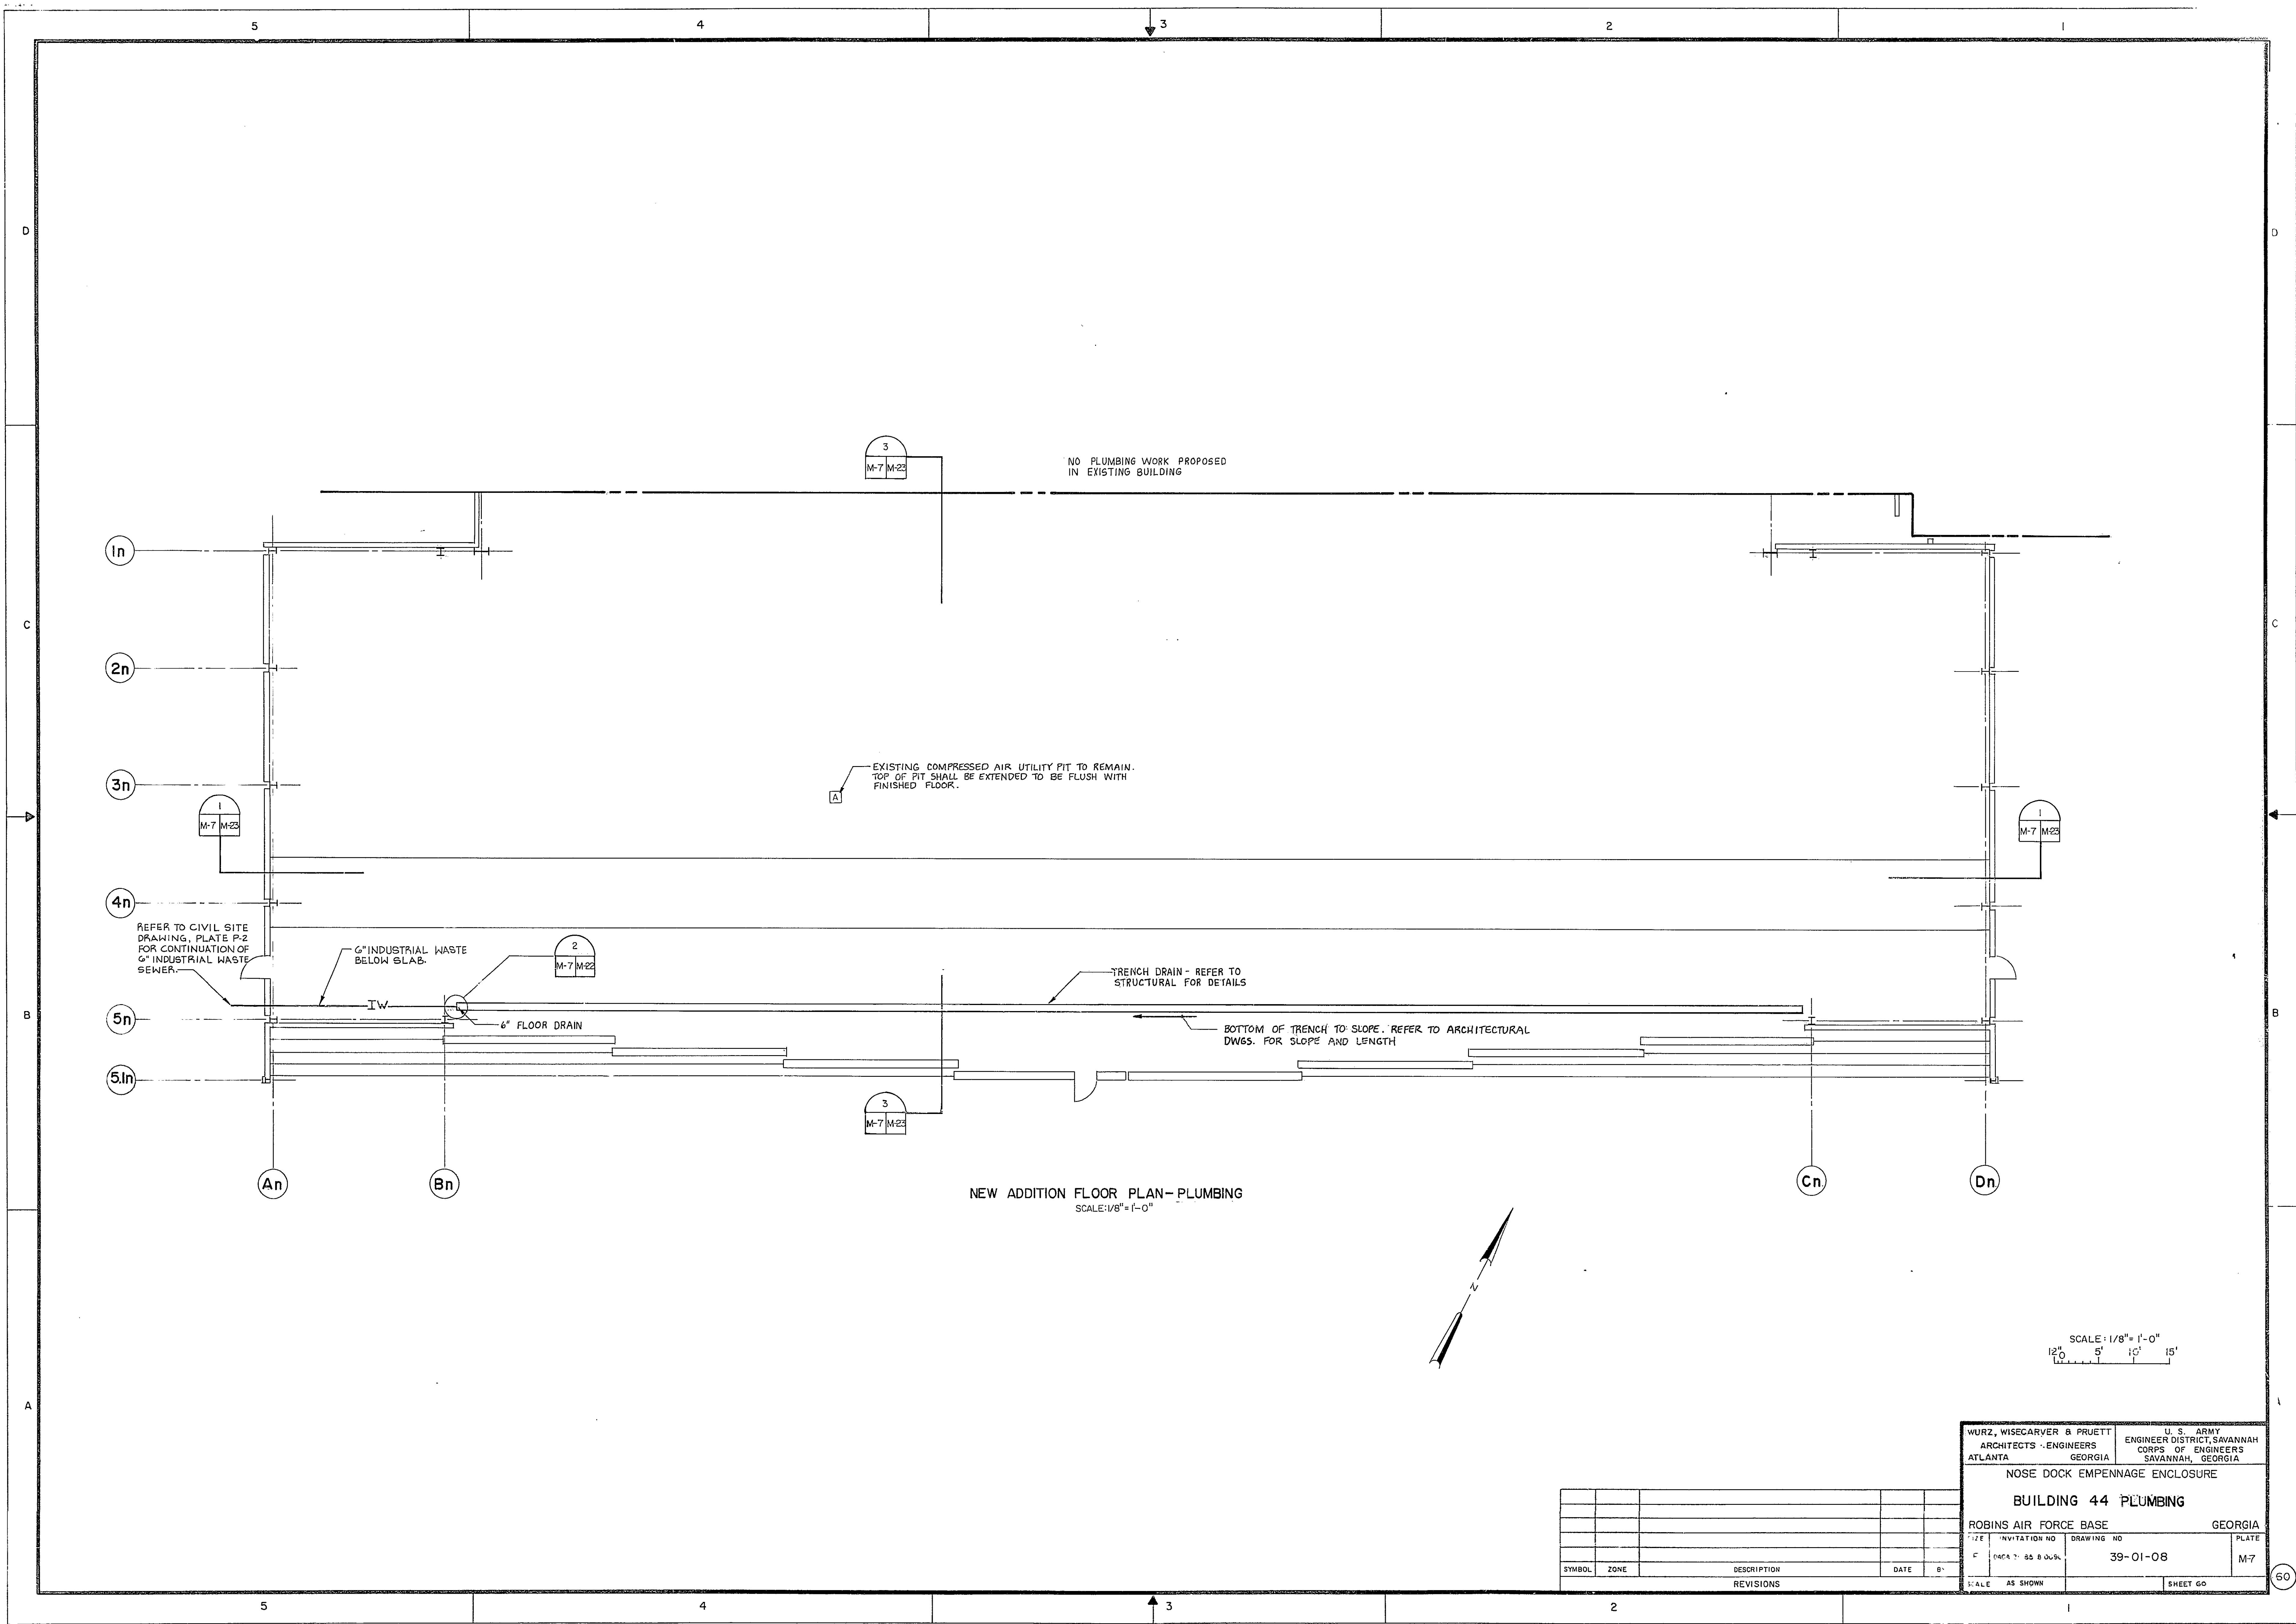


SYMBOL	ZONE	DESCRIPTION	DATE	BY
		REVISIONS		

WURZ, WISECARVER & PRUETT ARCHITECTS - ENGINEERS ATLANTA, GEORGIA		U. S. ARMY ENGINEER DISTRICT, SAVANNAH CORPS OF ENGINEERS SAVANNAH, GEORGIA	
NOSE DOCK EMPENNAGE ENCLOSURE			
BUILDING 44 PLUMBING			
ROBINS AIR FORCE BASE		GEORGIA	
DATE	INVESTIGATION NO.	DRAWING NO.	PLATE
F	DATA 7-85 B.006L	39-01-08	M-7
SCALE AS SHOWN		SHEET 60	

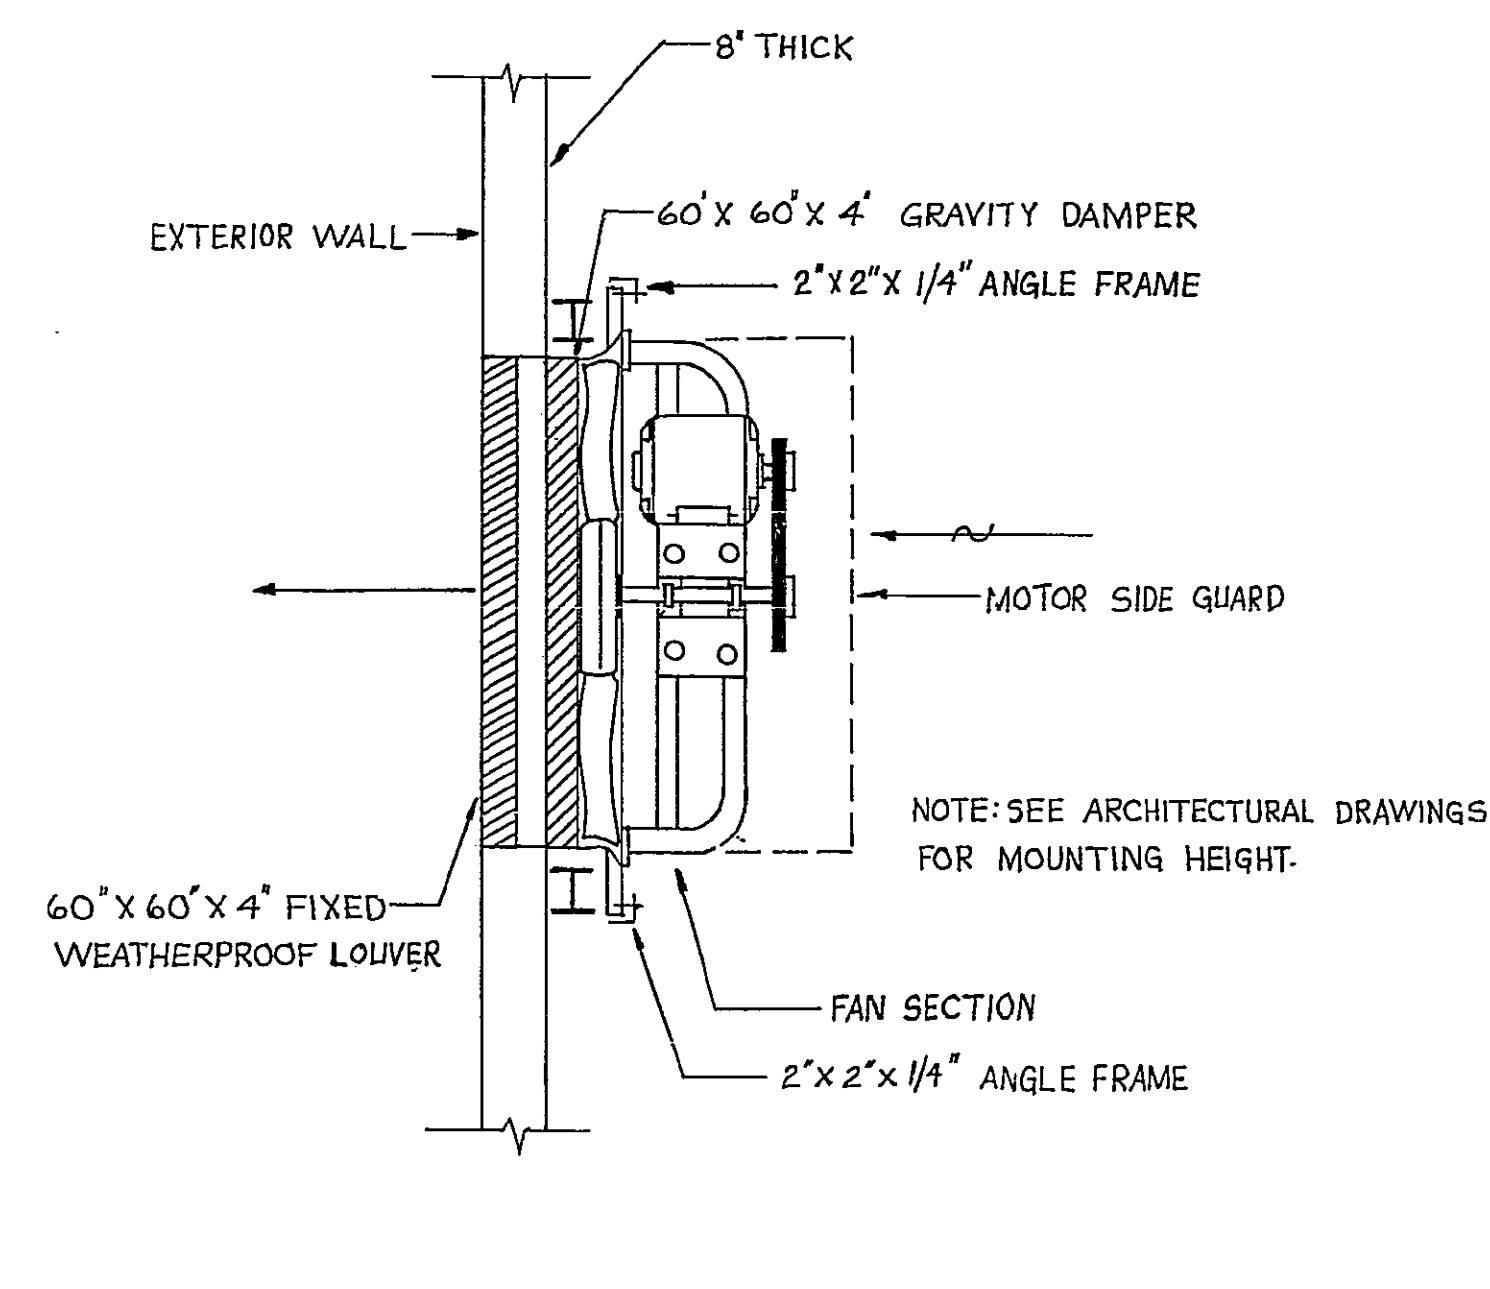

FAN DETAIL
NOT TO SCALE

1
M-1 M-6
M-2
M-3
M-4
M-5

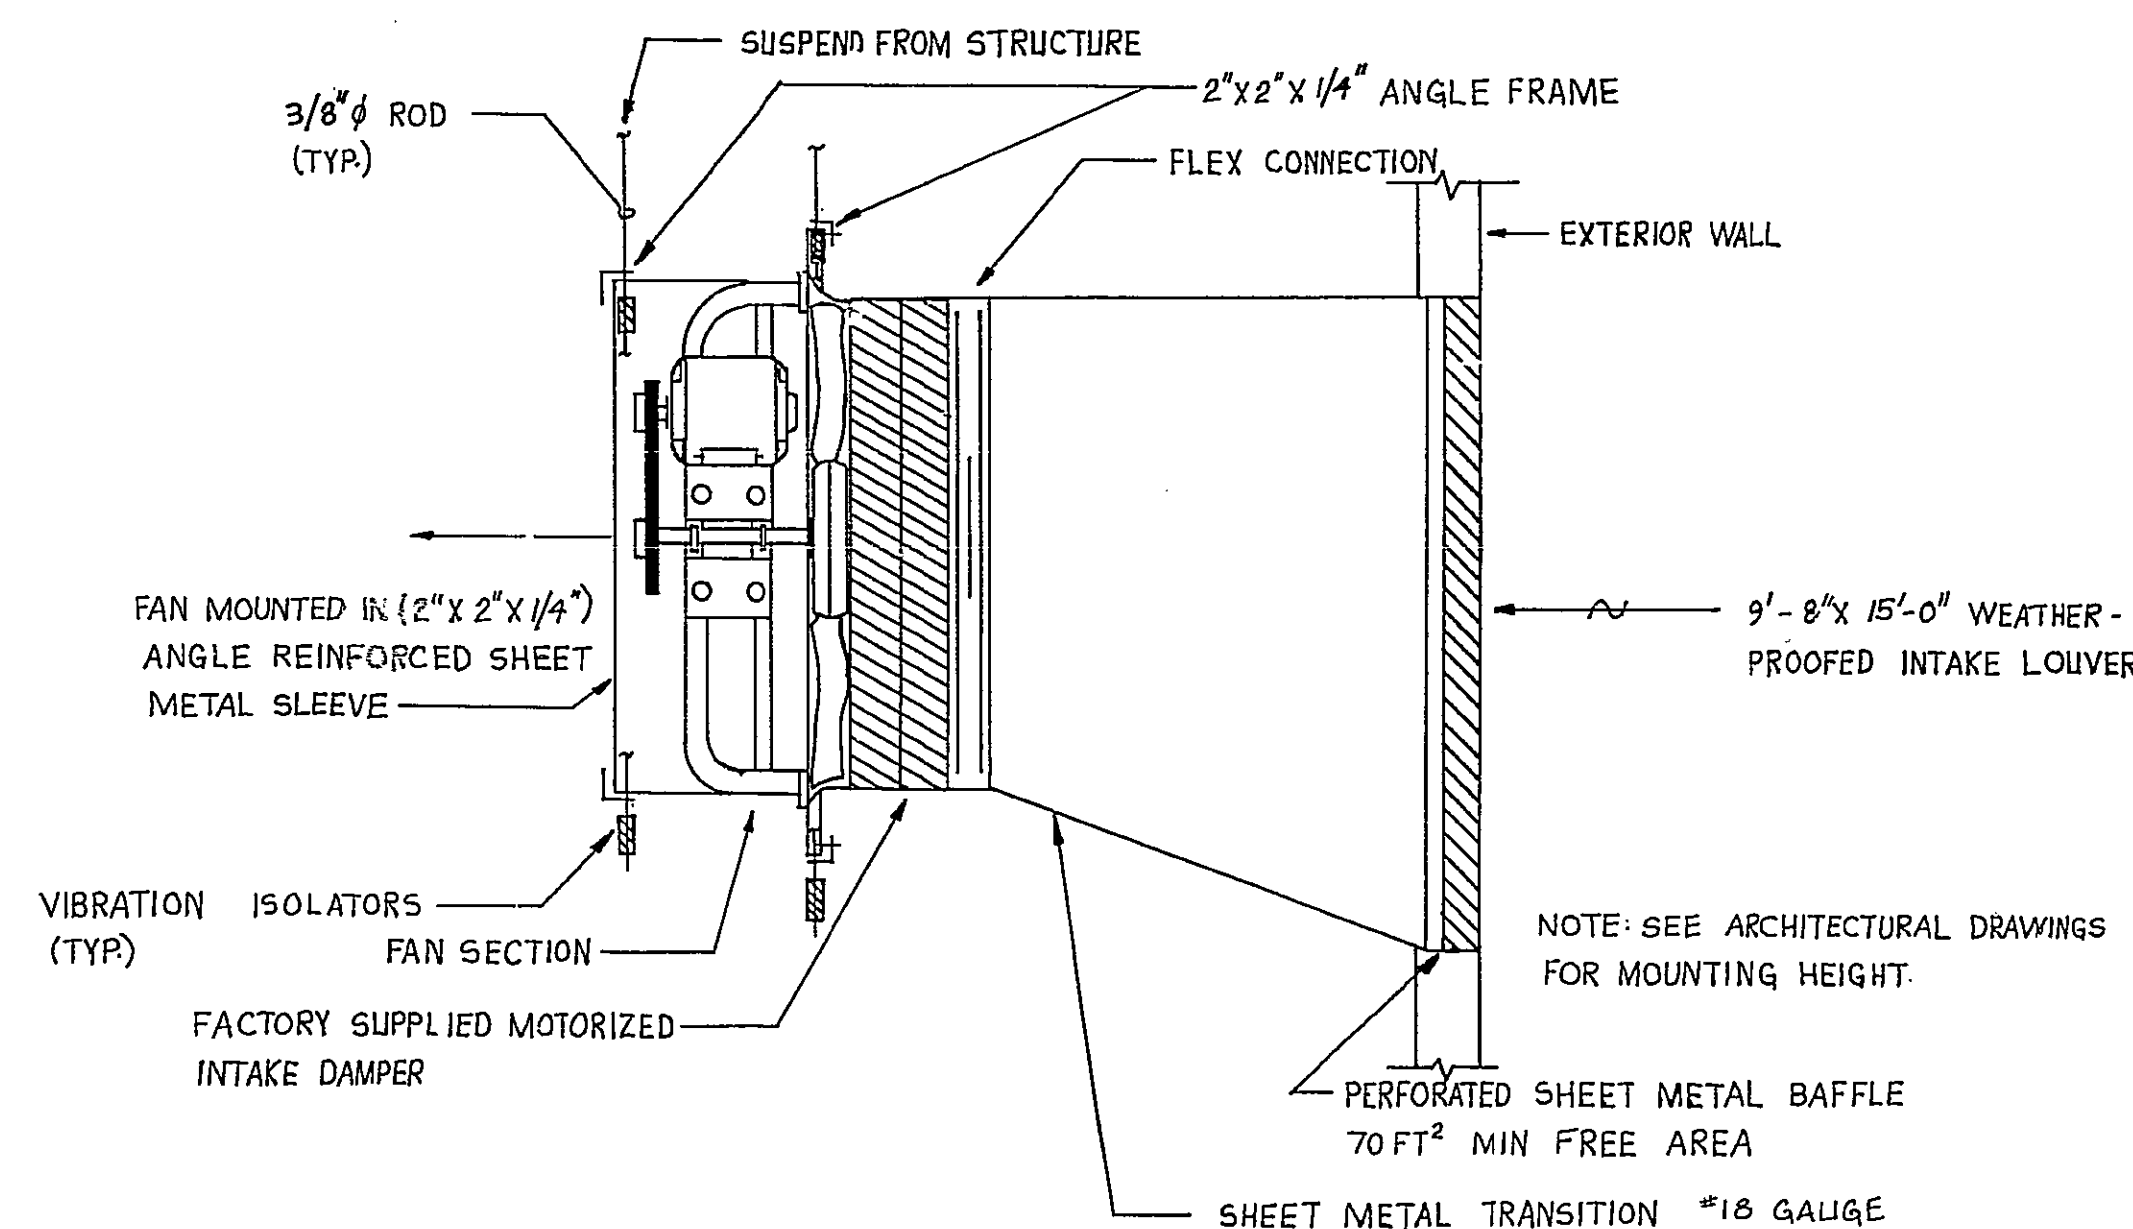


FAN DETAIL
NOT TO SCALE

2
M-1 M-6
M-2
M-3
M-4
M-5


FAN SCHEDULE								
TAG	CFM	APPROX. SP. IN. H ₂ O	DRIVE	H.P.	TYPE	BASIS OF DESIGN	LOCATION	NOTES
EF-1	50,400	.20	BELT	7.5	PROP	GREENHECK SPN-60	WALL MOUNTED	① ② ⑤
EF-2	50,400	.20	BELT	7.5	PROP	GREENHECK SPN-60	WALL MOUNTED	② ③ ④
EF-3	43,200	.20	BELT	5.0	PROP	GREENHECK SPN-60	WALL MOUNTED	① ② ⑥
EF-4	43,200	.20	BELT	5.0	PROP	GREENHECK SPN-60	WALL MOUNTED	② ③ ④

- ① GRAVITY DISCHARGE DAMPER
 ② MOTOR SIDE GUARD
 ③ MOTOR OPERATED DAMPER
 ④ FAN WILL NOT OPERATE UNTIL DAMPERS ARE COMPLETELY OPEN
 ⑤ INTERLOCK EF-1 WITH EF-2 (1 EACH)
 ⑥ INTERLOCK EF-3 WITH EF-4 (1 EACH)

WURZ, WISECARVER & PRUETT ARCHITECTS - ENGINEERS ATLANTA, GEORGIA		U. S. ARMY ENGINEER DISTRICT, SAVANNAH CORPS OF ENGINEERS SAVANNAH, GEORGIA	
NOSE DOCK EMPENNAGE ENCLOSURE			
VENTILATION DETAILS & SCHEDULES			
ROBINS AIR FORCE BASE		GEORGIA	
SIZE	INVIATION NO.	DRAWING NO.	PLATE
F	DACA 21-85-9-0090	39-01-08	M-6
SYMBOL	ZONE	DESCRIPTION	DATE BY
REVISIONS			
SCALE: AS SHOWN		SHEET 59	

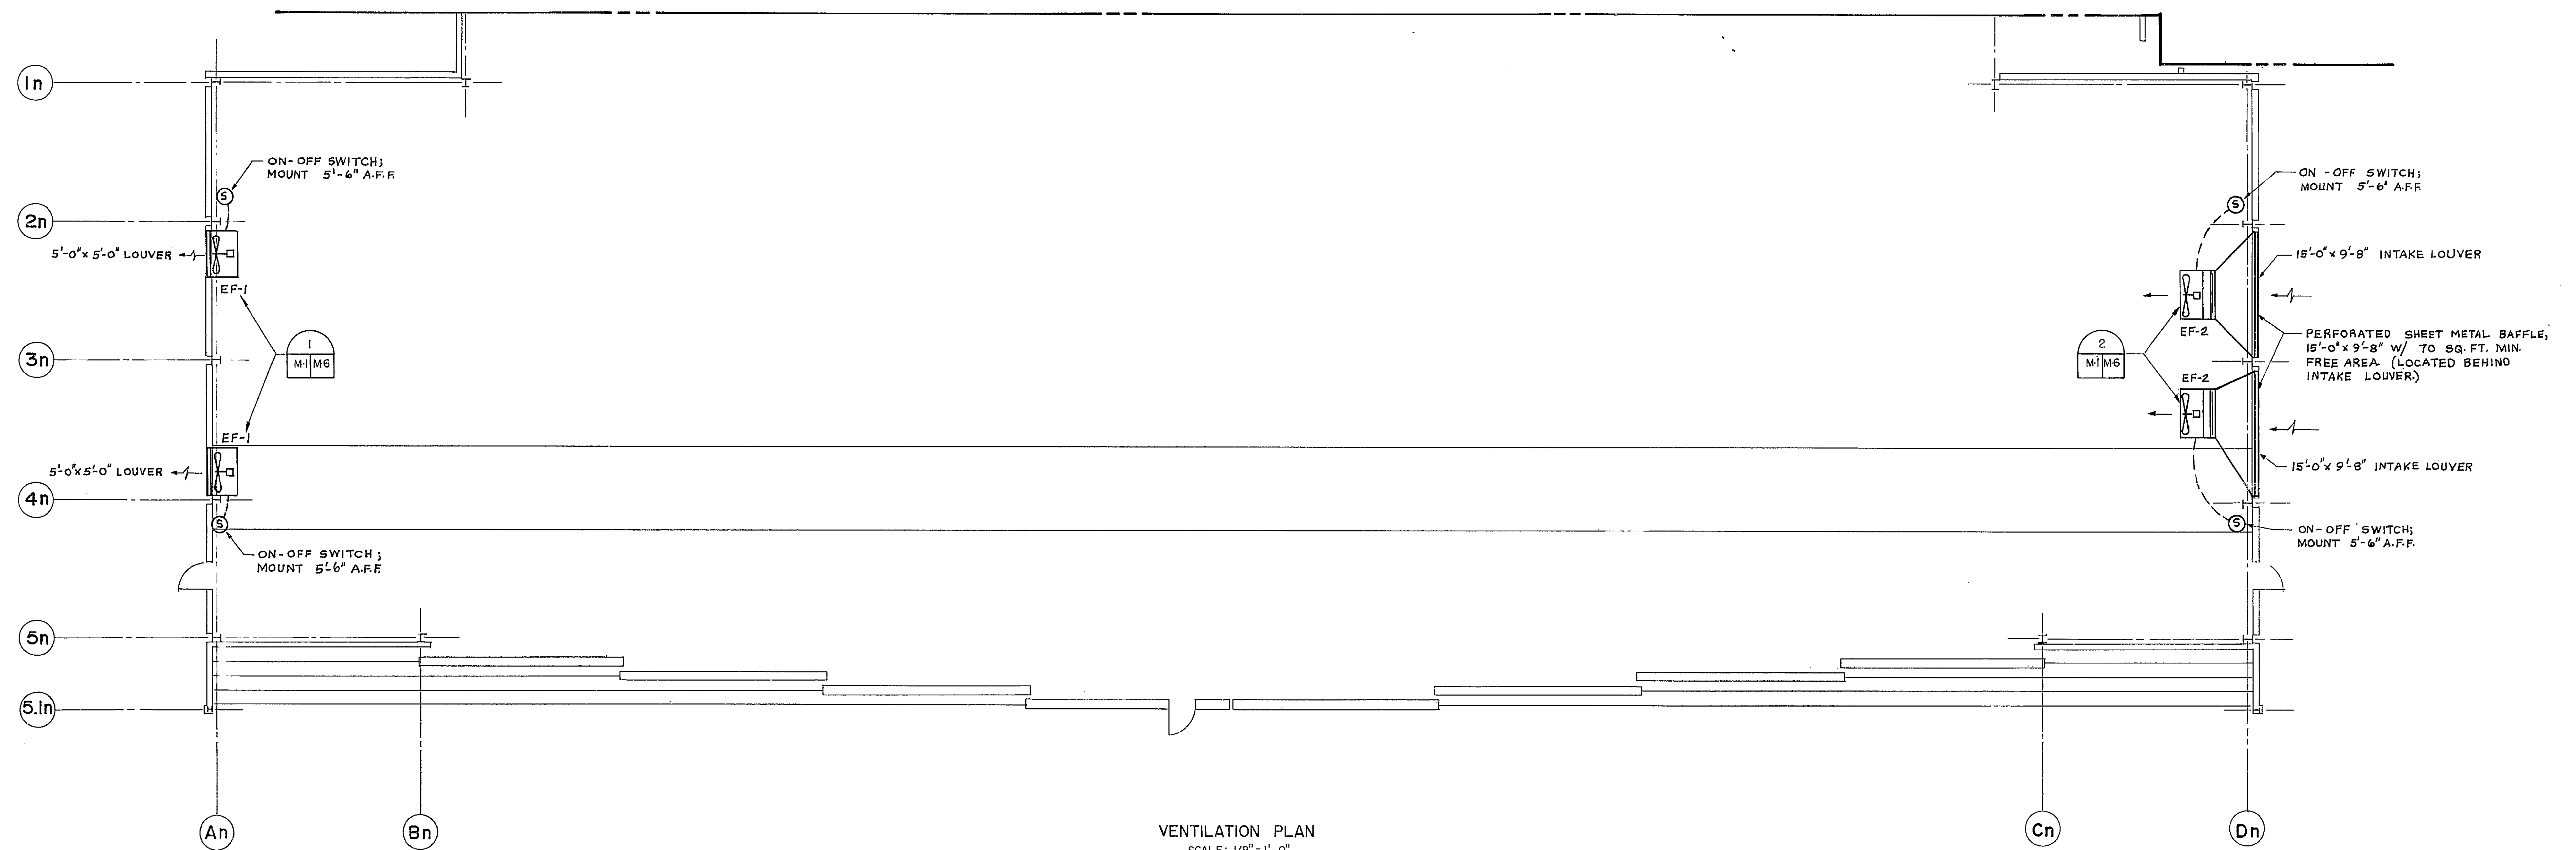

VENTILATION PLAN
SCALE: 1/8" = 1'-0"

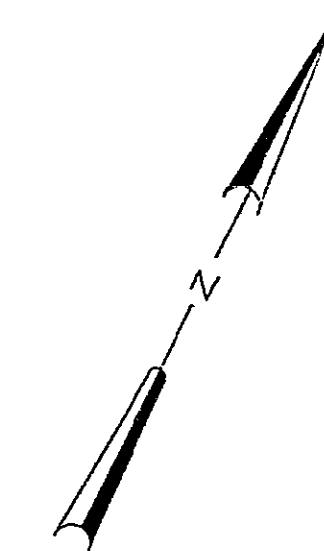

SCALE 1/8" = 1'-0"

LESIGRA AME PREPARED BY APPROVED BY REVIEWED PROJECT MANAGER RECOMMEND CHIEF MAIL ROOMS & RECORDS SECTION DATE 01 SEPT 83	WURZ, WISECARVER & PRUETT ARCHITECTS - ENGINEERS ATLANTA GEORGIA NOSE DOCK EMPENNAGE ENCLOSURE BUILDING 44 VENTILATION ROBINS AIR FORCE BASE GEORGIA 2E INVITATION NO F DACA 21-85-B-0090 SCALE AS SHOWN SHEET 54	U. S. ARMY ENGINEER DISTRICT, SAVANNAH CORPS OF ENGINEERS SAVANNAH, GEORGIA PLATE M-1
---	---	--

(BASIC SHEET) RED/OVERLAY
FOR BASIC R M-1

GENERAL NOTES

DESIGN LOADS

- VERTICAL LOADS
LIVE LOAD = 20 PSF
WIND UPLIFT = 42 PSF
- HORIZONTAL WIND FORCES - PRESSURE OR SUCTION
a. WALL SIDING, PURLINE, WIND COLUMNS
0'-30' = 39 PSF
30'-50' = 42 PSF
50'-65' = 46 PSF
b. TRUSSES, 'X' BRACING, BOTTOM CHORD BRACING
0'-30' = 20 PSF
30'-50' = 39 PSF
50'-65' = 42 PSF
- SEISMIC - ZONE ONE
Z=0.1, I=1.25, K=1.33, G=1.5, C=12
WIND FORCES CONTROL LATERAL DESIGN

FOUNDATION NOTES

- ALLOWABLE SOIL BEARING PRESSURE = 2000 PSF (MAX.)
- ALLOWABLE SOIL LATERAL RESISTANCE BASED ON COEFFICIENT OF PASSIVE EARTH PRESSURE (K_p) = 1.79

CONCRETE NOTES

- SEE SPECIFICATION SECTION 301
- ALL REINFORCING STEEL SHALL BE GRADE 60
- ALL CONCRETE OTHER THAN PAVING SHALL HAVE A COMPRESSIVE STRENGTH OF 3000 PSI AT 28 DAYS.
- ALL CONCRETE PAVING (CENTER 40' OF DOCK) SHALL HAVE A FLEXURAL STRENGTH OF 600 PSI AT 28 DAYS

CONCRETE NOTES CONT.

- BASE PLATES SHALL BE ASTM A36
- ANCHOR BOLTS SHALL BE AS INDICATED ON DMS 510
- SEE SPECIFICATIONS FOR VAPOR BARRIER.

STRUCTURAL STEEL NOTES

- SEE SPECIFICATION SECTIONS 581 AND 5W1
- ALL STEEL SHALL CONFORM TO ASTM A36

STEEL JOIST NOTES

- SEE SPECIFICATION SECTION 5J1
- ALL JOIST SHALL BE DESIGNED FOR THE GROSS UPLIFT LISTED.
- ALL BRIDGING SHALL BE L 11 x 11 x 8 'X' BRACING AND BOLTED AT THE INTERSECTION.
- SPECIAL JOISTS SHALL BE DESIGNED FOR THE FOLLOWING LOADS, IN ADDITION TO THE LOADS GIVEN IN THE STANDARD LOAD TABLE FOR A36 LHO8 JOIST.

SPECIAL NO. 1

CRANE LOAD: 9.0 KIP AND 1.5 KIP AT LOCATIONS INDICATED ON PLAN. THESE LOADS OCCUR SIMULTANEOUSLY AND ARE REVERSABLE. THESE LOADS MUST BE VERIFIED WITH CRANE MANUFACTURER.

- SPECIAL NO. 2: BOTTOM CHORD FORCE = 150 KIP - COMP. AT TENON
SPECIAL NO. 3: BOTTOM CHORD FORCE = 120 KIP - COMPRESSION
SPECIAL NO. 4: BOTTOM CHORD FORCE = 70 KIP - COMPRESSION
SPECIAL NO. 5: BOTTOM CHORD FORCE = 20 KIP - COMPRESSION

- ALL JOIST SHALL HAVE BOTTOM CHORD EXTENSIONS CONNECTED TO BOTTOM CHORD BRACING.

METAL ROOFING

- SEE ARCH. DWGS AND SPECIFICATIONS FOR TYPICAL ROOF PROFILE, DETAILS ETC
- ROOF SHALL BE STEEL 22 GA (MIN) OR ALUMINUM .040" THICKNESS (MIN.)
- ROOFING SHALL BE CAPABLE OF RESISTING THE DESIGN LOADS WITH A MAXIMUM DEFLECTION OF $\frac{1}{160}$
- ROOFING SHALL BE APPROVED BY CONTRACTING OFFICER

METAL WALL SIDING

- SEE ARCH. DRAWINGS AND SPECIFICATIONS FOR TYPICAL PROFILE, DETAILS ETC.
- SIDING SHALL BE STEEL 22 GA. (MIN)
- SIDING SHALL BE CAPABLE OF RESISTING THE DESIGN LOADS WITH A MAXIMUM DEFLECTION OF $\frac{1}{160}$
- SIDING SHALL BE APPROVED BY CONTRACTING OFFICER

WELDING REQUIREMENTS


- FOR MISCELLANEOUS WELD SIZES NOT SHOWN USE A MIN. OF $\frac{3}{16}$ " OR AISC MINIMUM SIZE, WHICHEVER IS LARGER.

UNDERPINNING NOTES


- UNDERPINNING SHALL BE DONE IN SEGMENTS NOT TO EXCEED 4'-0"
- CIRCLE NUMBERS INDICATE SEQUENCING.
- ALLOW DRY PACK & CONCRETE TO CURE FOR A MINIMUM OF 48 HOURS PRIOR TO PROCEEDING TO NEXT SEGMENT
- UNDERPINNING SHALL MATCH WIDTH OF EXIST. FOUNDATION
- ANY ALTERNATE DETAILS SHALL BE SUBMITTED TO THE CONTRACTING OFFICER FOR APPROVAL.

UNDERPINNING NOTES CONT.

- THE CONTRACTOR SHALL BE RESPONSIBLE FOR MAINTAINING THE INTEGRITY OF THE EXISTING STRUCTURE AND FOUNDATION DURING THE UNDERPINNING PROCESS AND UNTIL ALL ADJACENT BACKFILL HAS BEEN PLACED TO FINISH GRADE.
- THE CONTRACTOR SHALL SUBMIT THREE (3) WEEKS PRIOR TO INITIATING ANY EXCAVATION ASSOCIATED WITH EXCAVATION BRACING, SHORING, AND UNDERPINNING OF THE EXISTING CONCRETE BLOCK BLDG, DETAILS OF THE PROPOSED PROCEDURES AND SEQUENCE FOR ACCOMPLISHING THE WORK.
- IN ADDITION TO THE REQUIRED SHORING ALONG THE LONGITUDINAL FACE OF EXCAVATION, TEMPORARY SHORING AND BRACING SHALL BE REQUIRED AS NEEDED TO PREVENT RAVELING, GLOUGHING AND CAVING OF THE BACK AND SIDES OF THE INDIVIDUAL PANEL OR SEGMENT EXCAVATION.

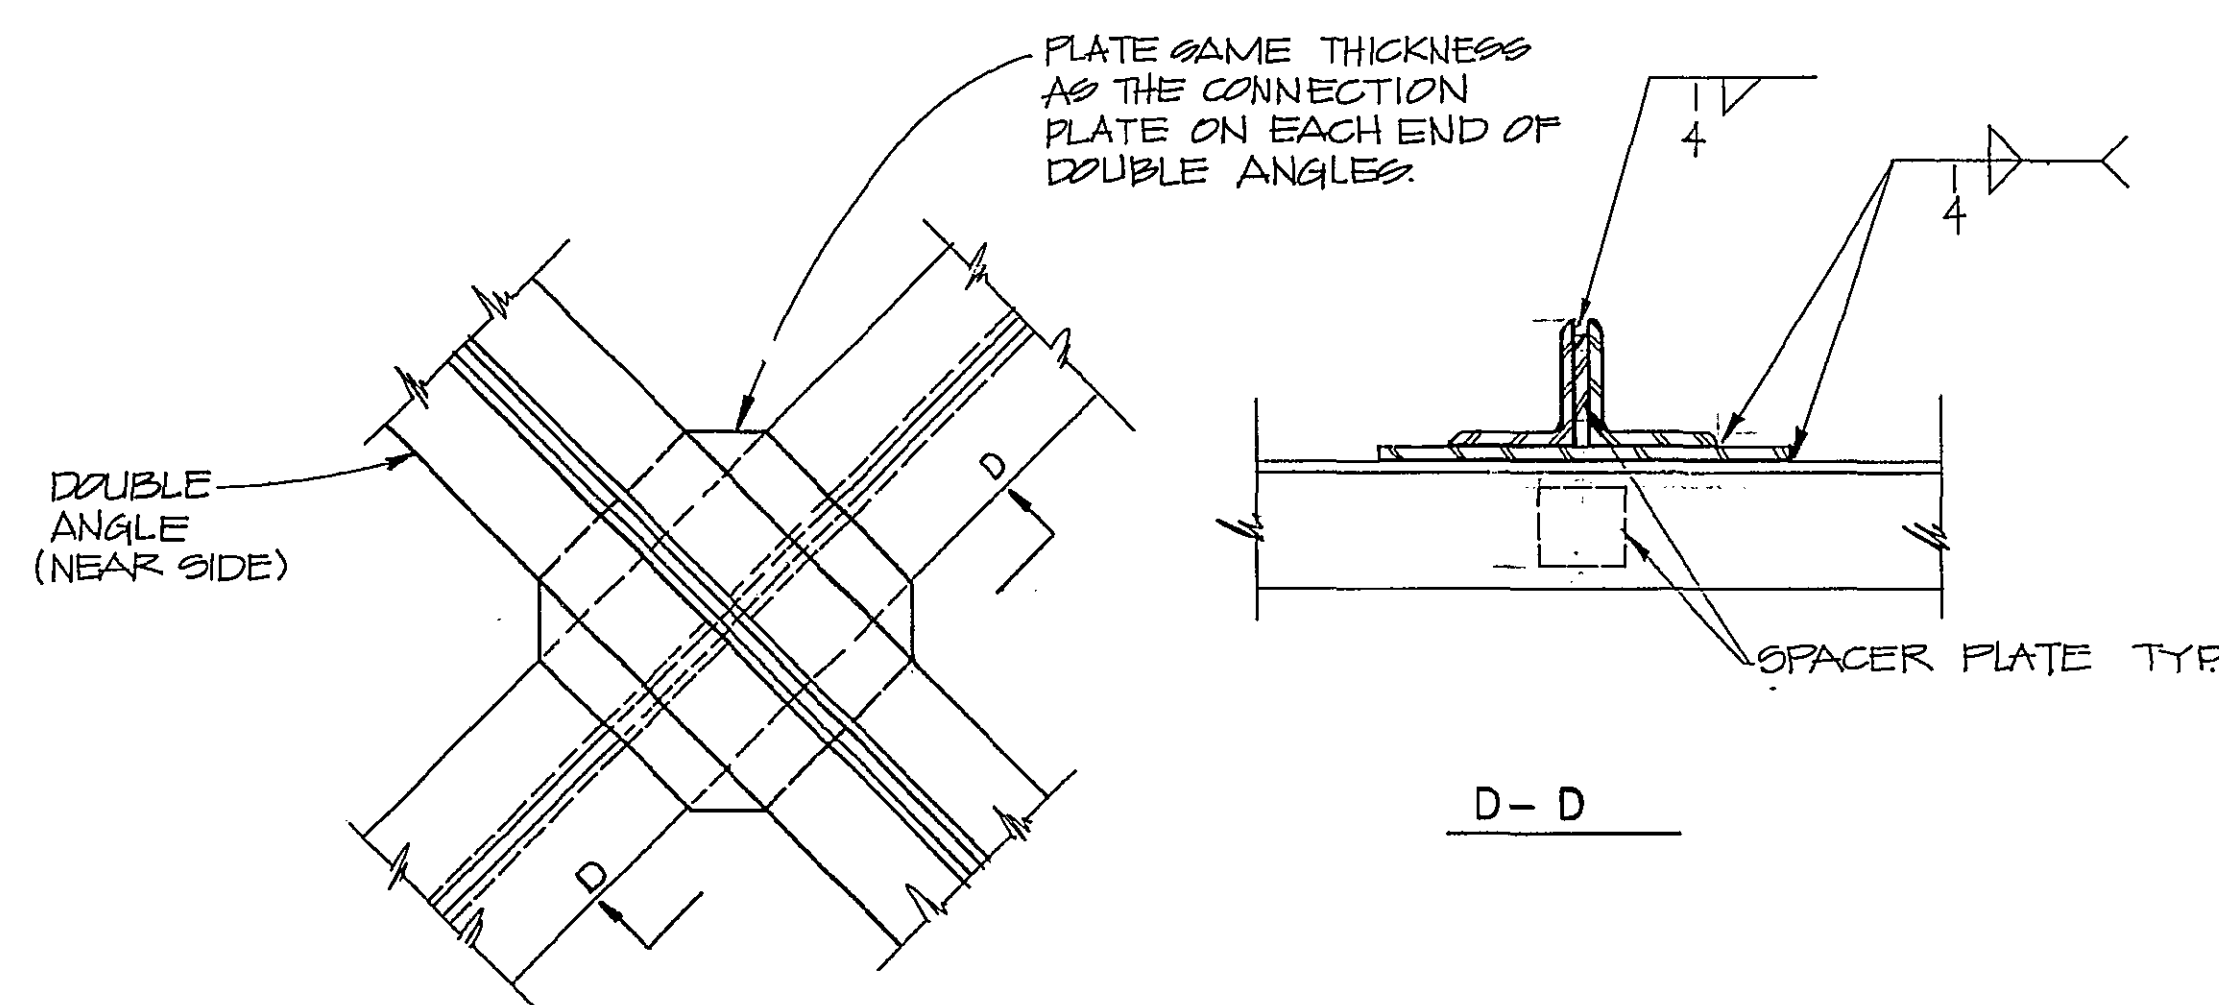


TYP DOUBLE ANGLE INTERSECTIONS AND SPACER PLATE DETAIL
SCALE: 1" = 1'-0"

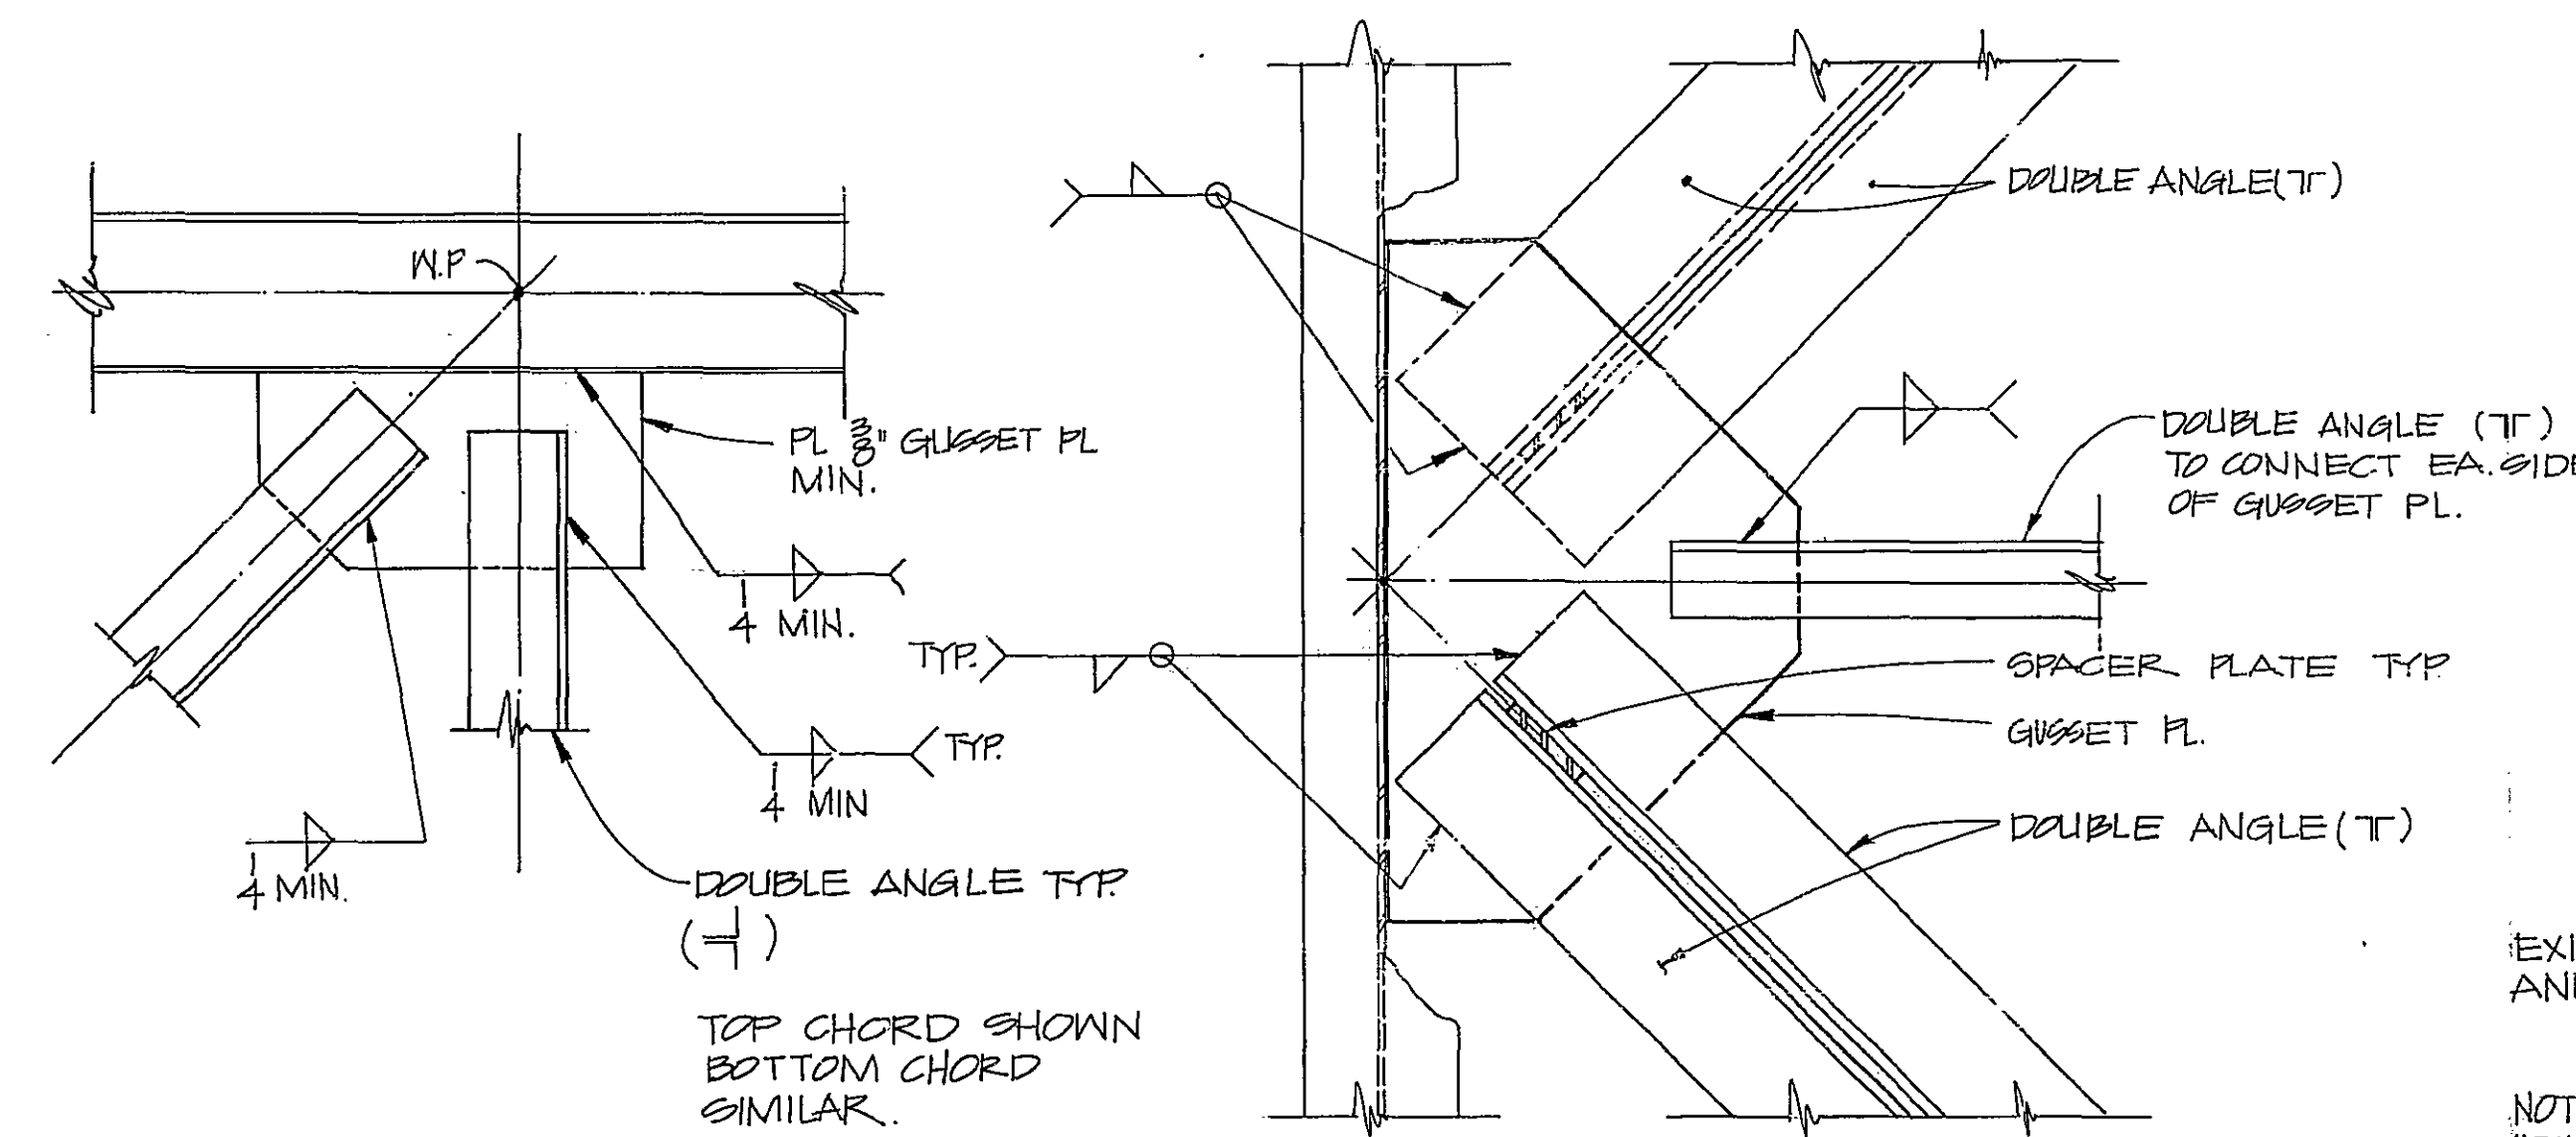


TYP TRUSS 1 CONNECTION
SCALE: 1" = 1'-0"


TYP TRUSS 1 CONNECTION
SCALE: 1" = 1'-0"

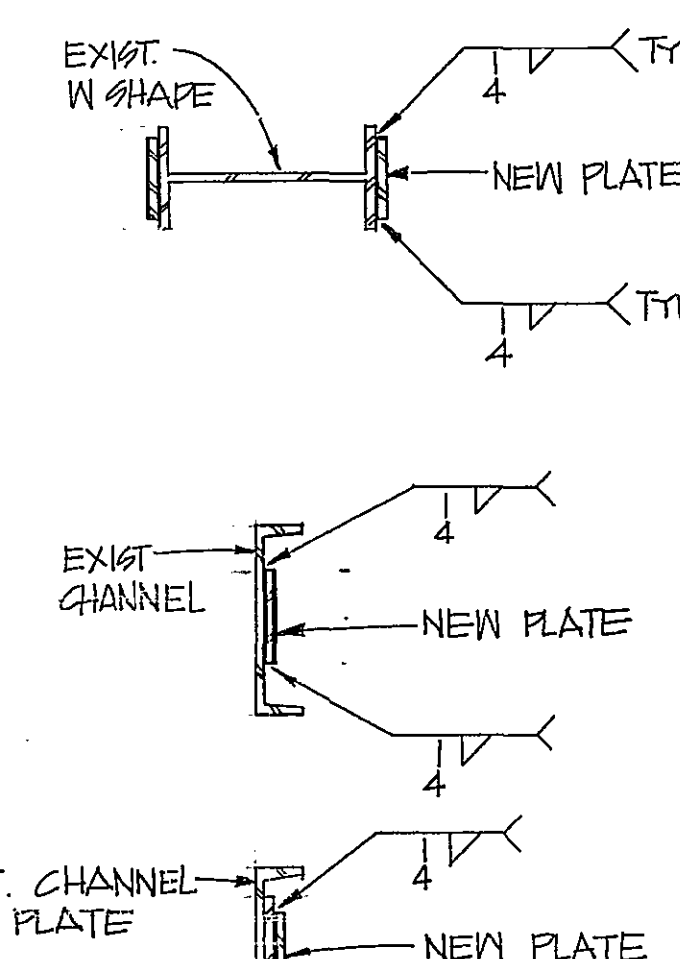


TYP TRUSS 2 CONNECTION
ADDL PLATES
SCALE: 1" = 1'-0"

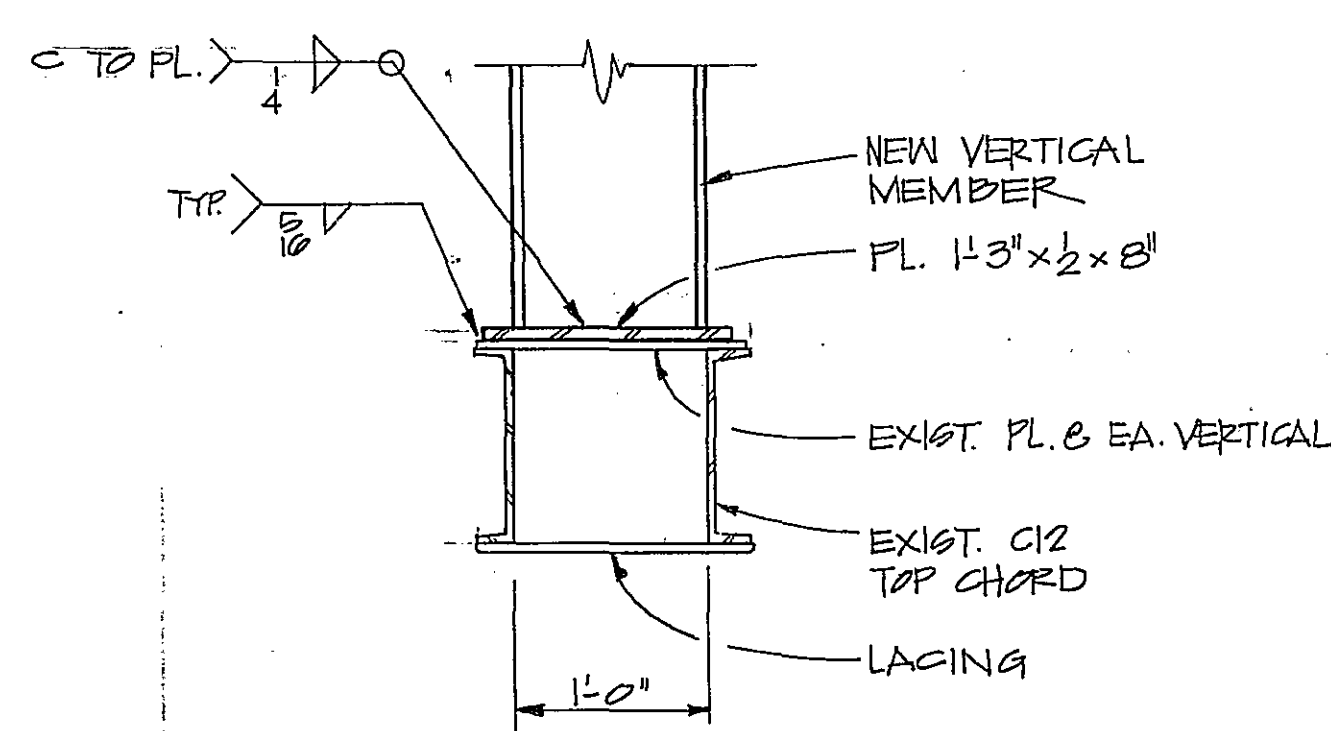


TYP TRUSS 2 CONNECTION
NEW VERTICAL MEMBER
SCALE: 1" = 1'-0"

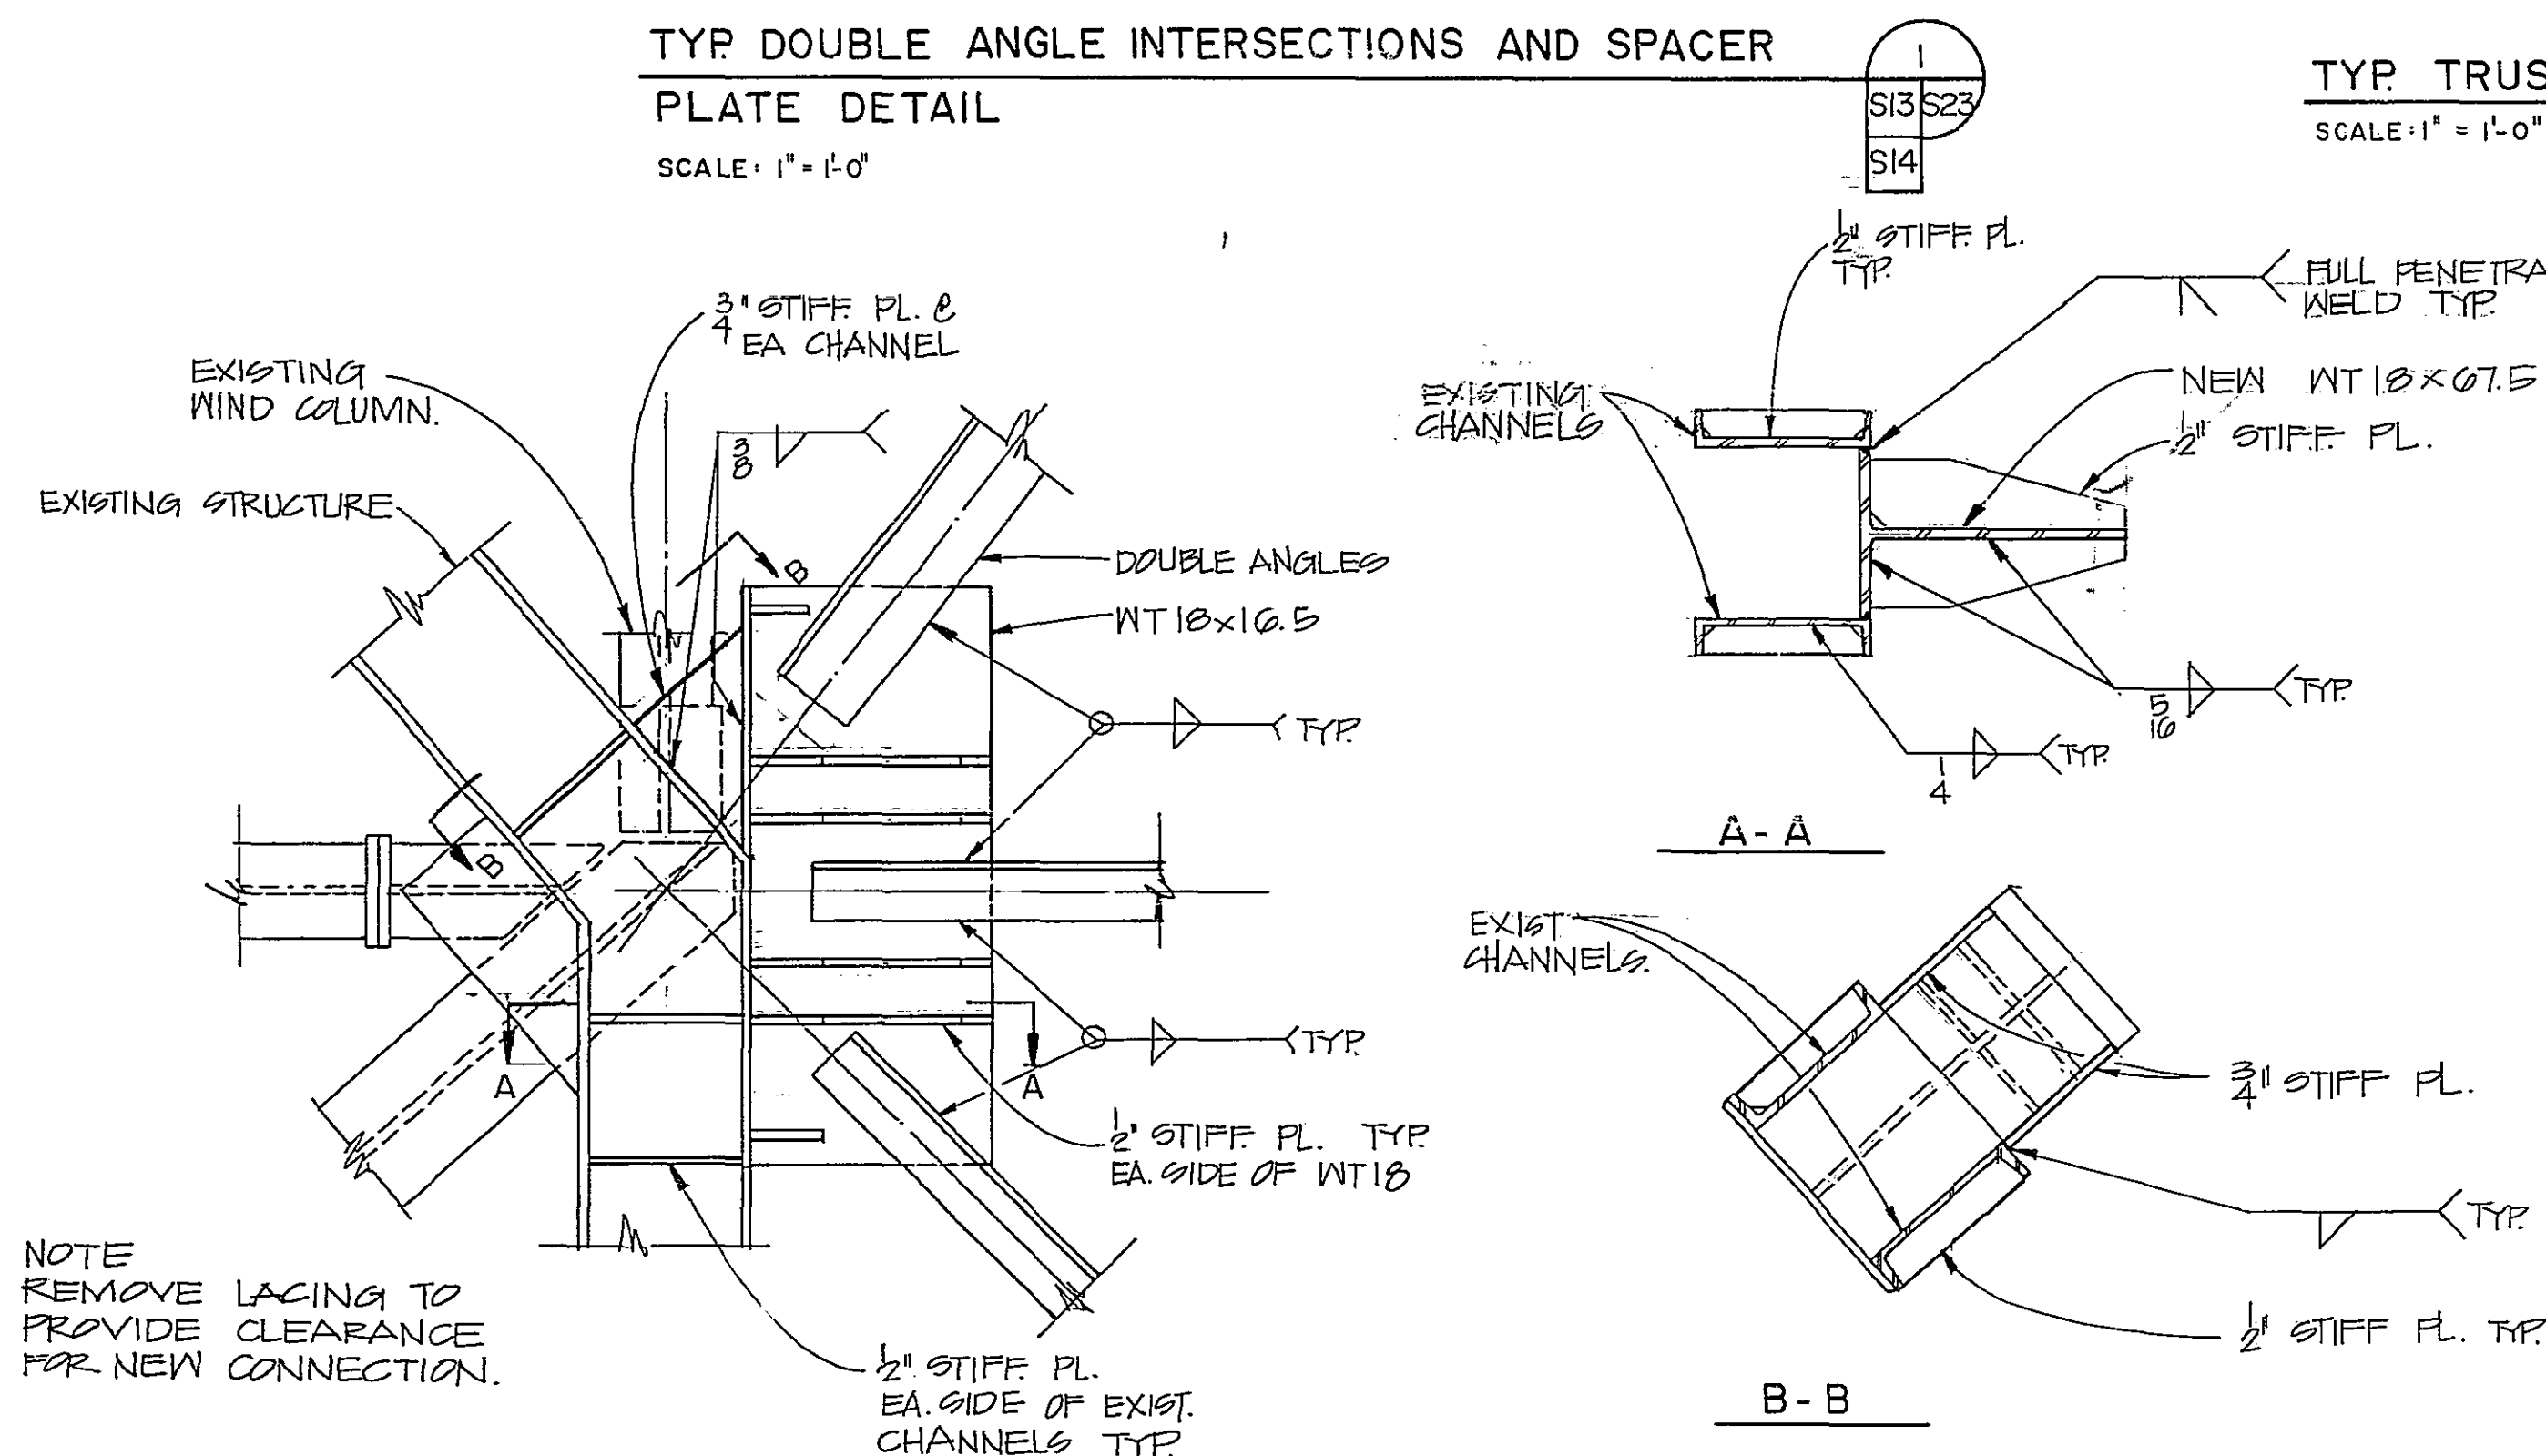


TYPICAL TRUSS 2 CONNECTION
SCALE: 1" = 1'-0"

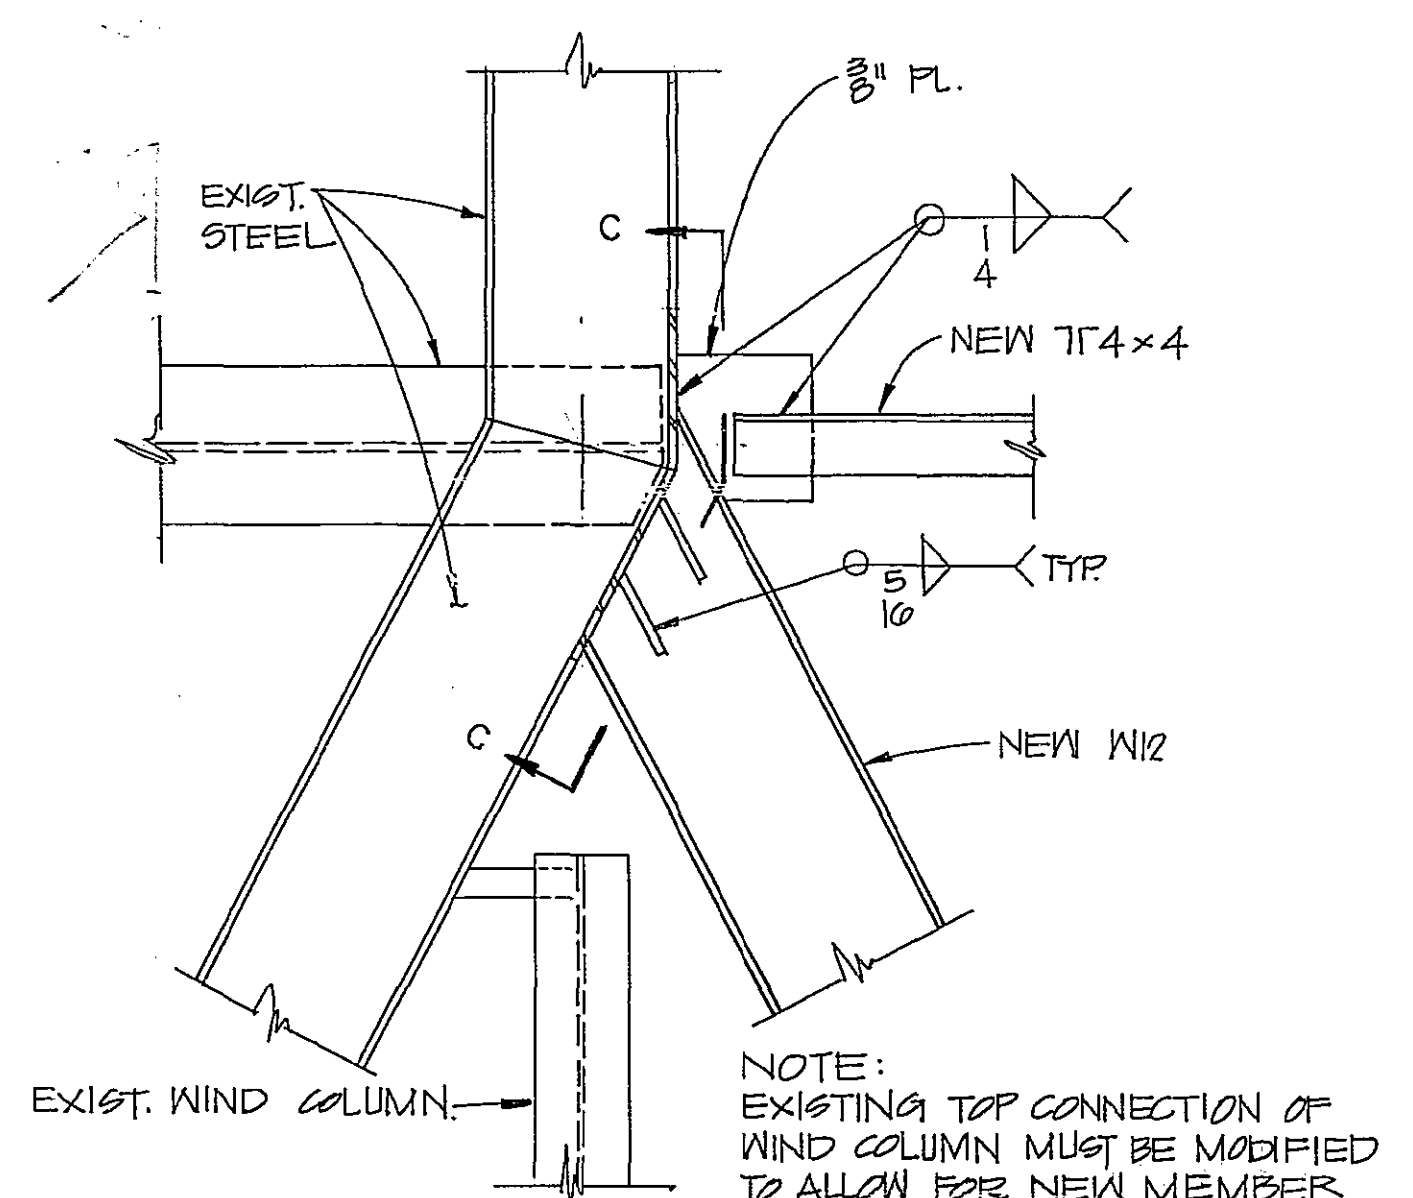

TYPICAL TRUSS 2 CONNECTION
SCALE: 1" = 1'-0"

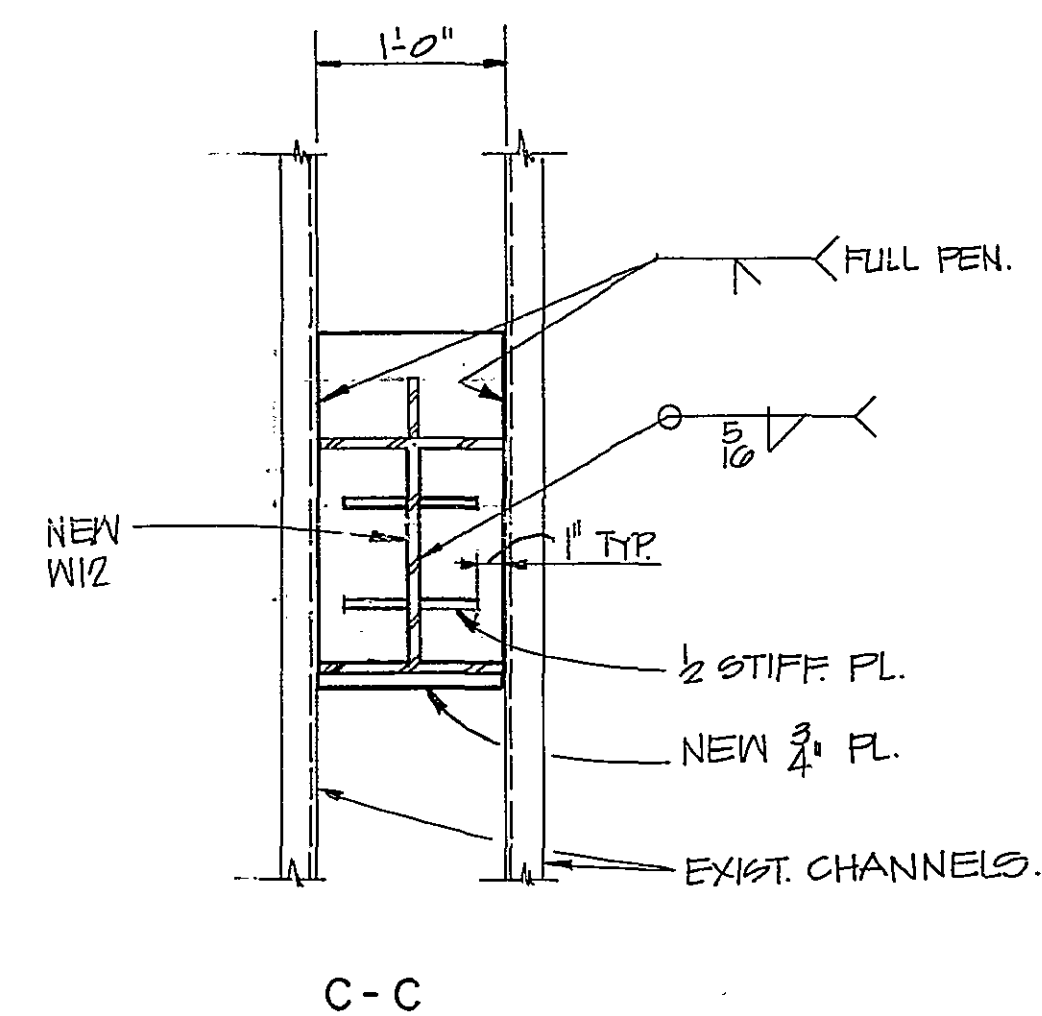


C-C

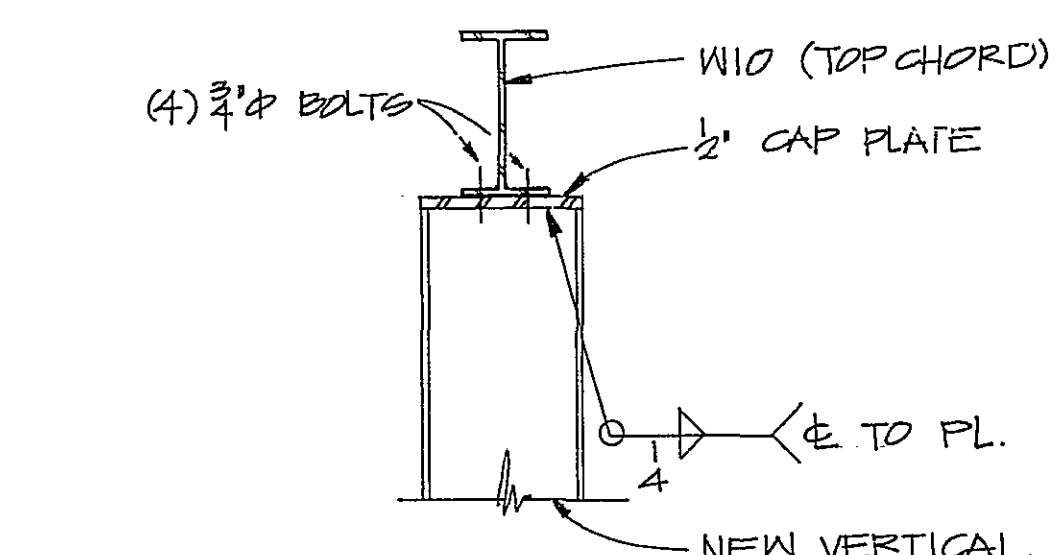

TYP TRUSS 2 CONNECTION
SCALE: 1" = 1'-0"


SCALE: 1" = 1'-0"

WURZ WISECARVER & PRUETT ARCHITECTS ENGINEERS ATLANTA GEORGIA		U. S. ARMY ENGINEER DISTRICT SAVANNAH CORPS OF ENGINEERS SAVANNAH, GEORGIA	
NOSE DOCK EMPENNAGE ENCLOSURE GENERAL NOTES SECTIONS AND DETAILS			
ROBINS AIR FORCE BASE		GEORGIA	
SIZE	INVITATION NO.	DRAWING NO.	PLATE
F	DACA 21-85-B-0090	39-01-08	S-23
SCALE: AS SHOWN		SHEET 53	

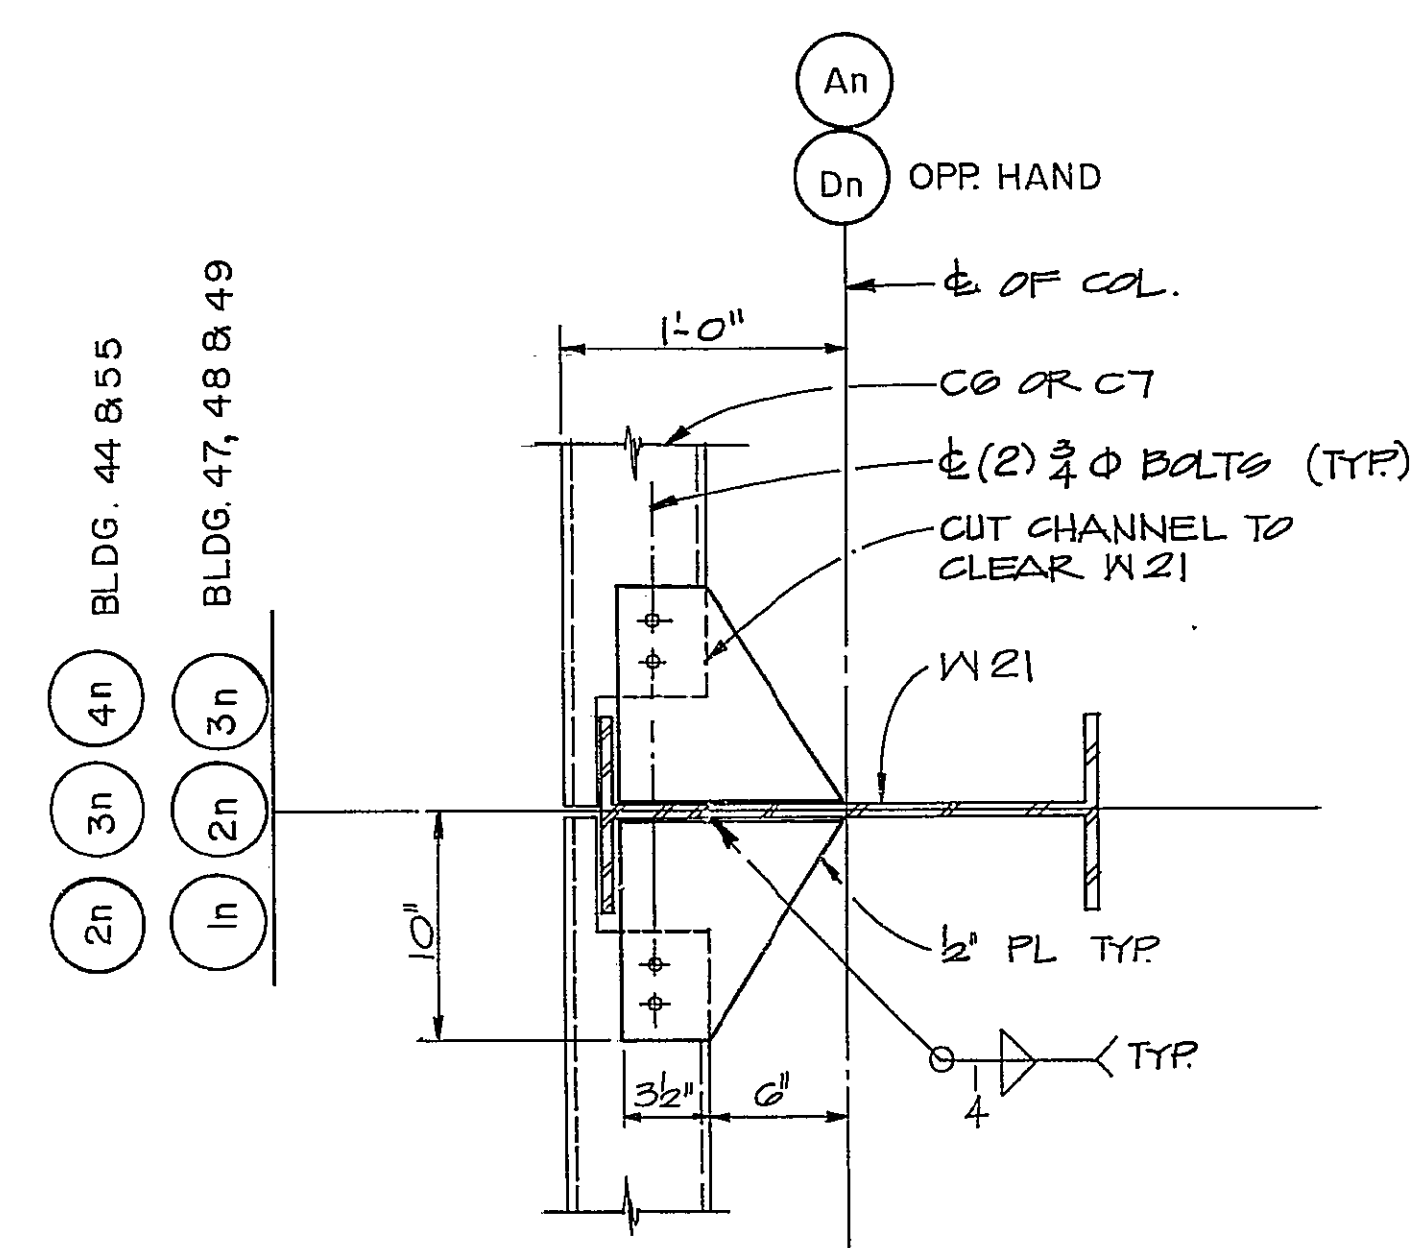


PLAN- GIRT TO COLUMN CONNECTION

SCALE: 1/2" = 1'-0"

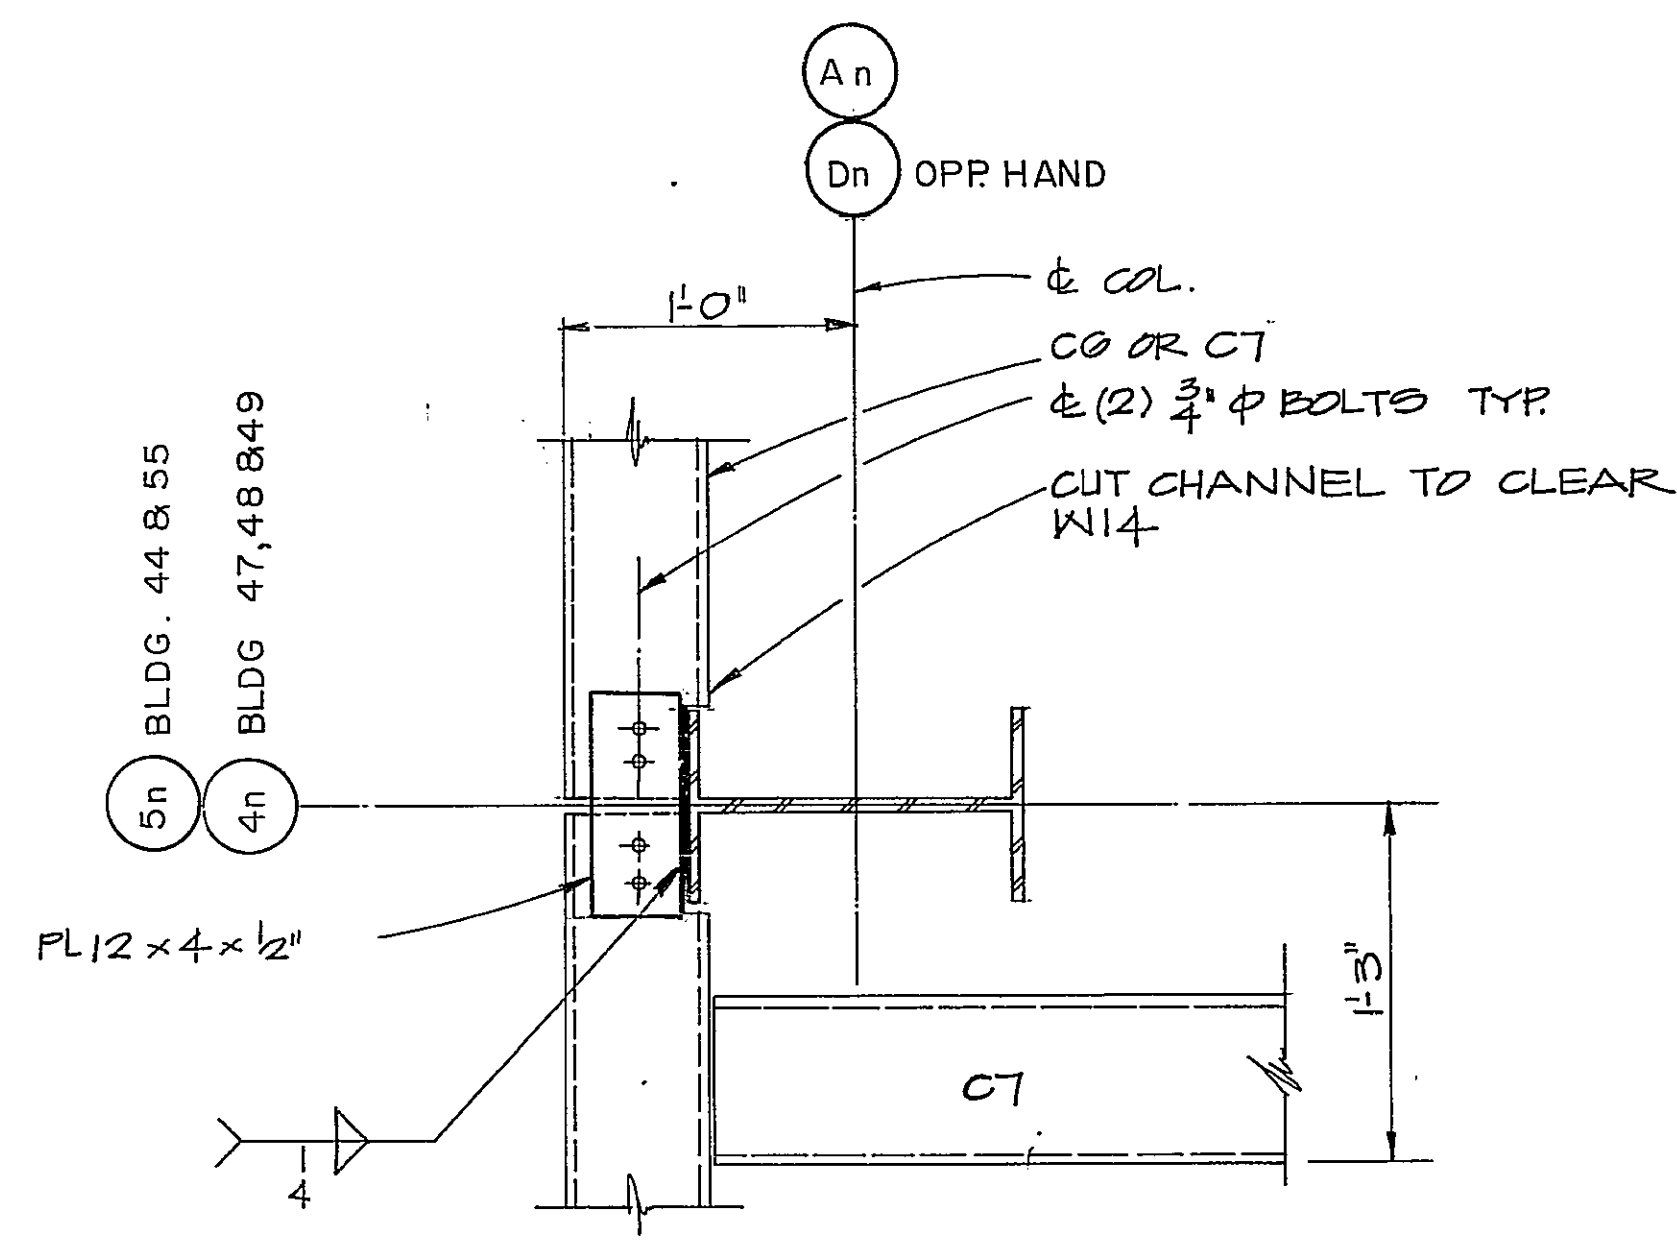


PLAN- GIRT TO COLUMN CONNECTION

SCALE: 1/2" = 1'-0"

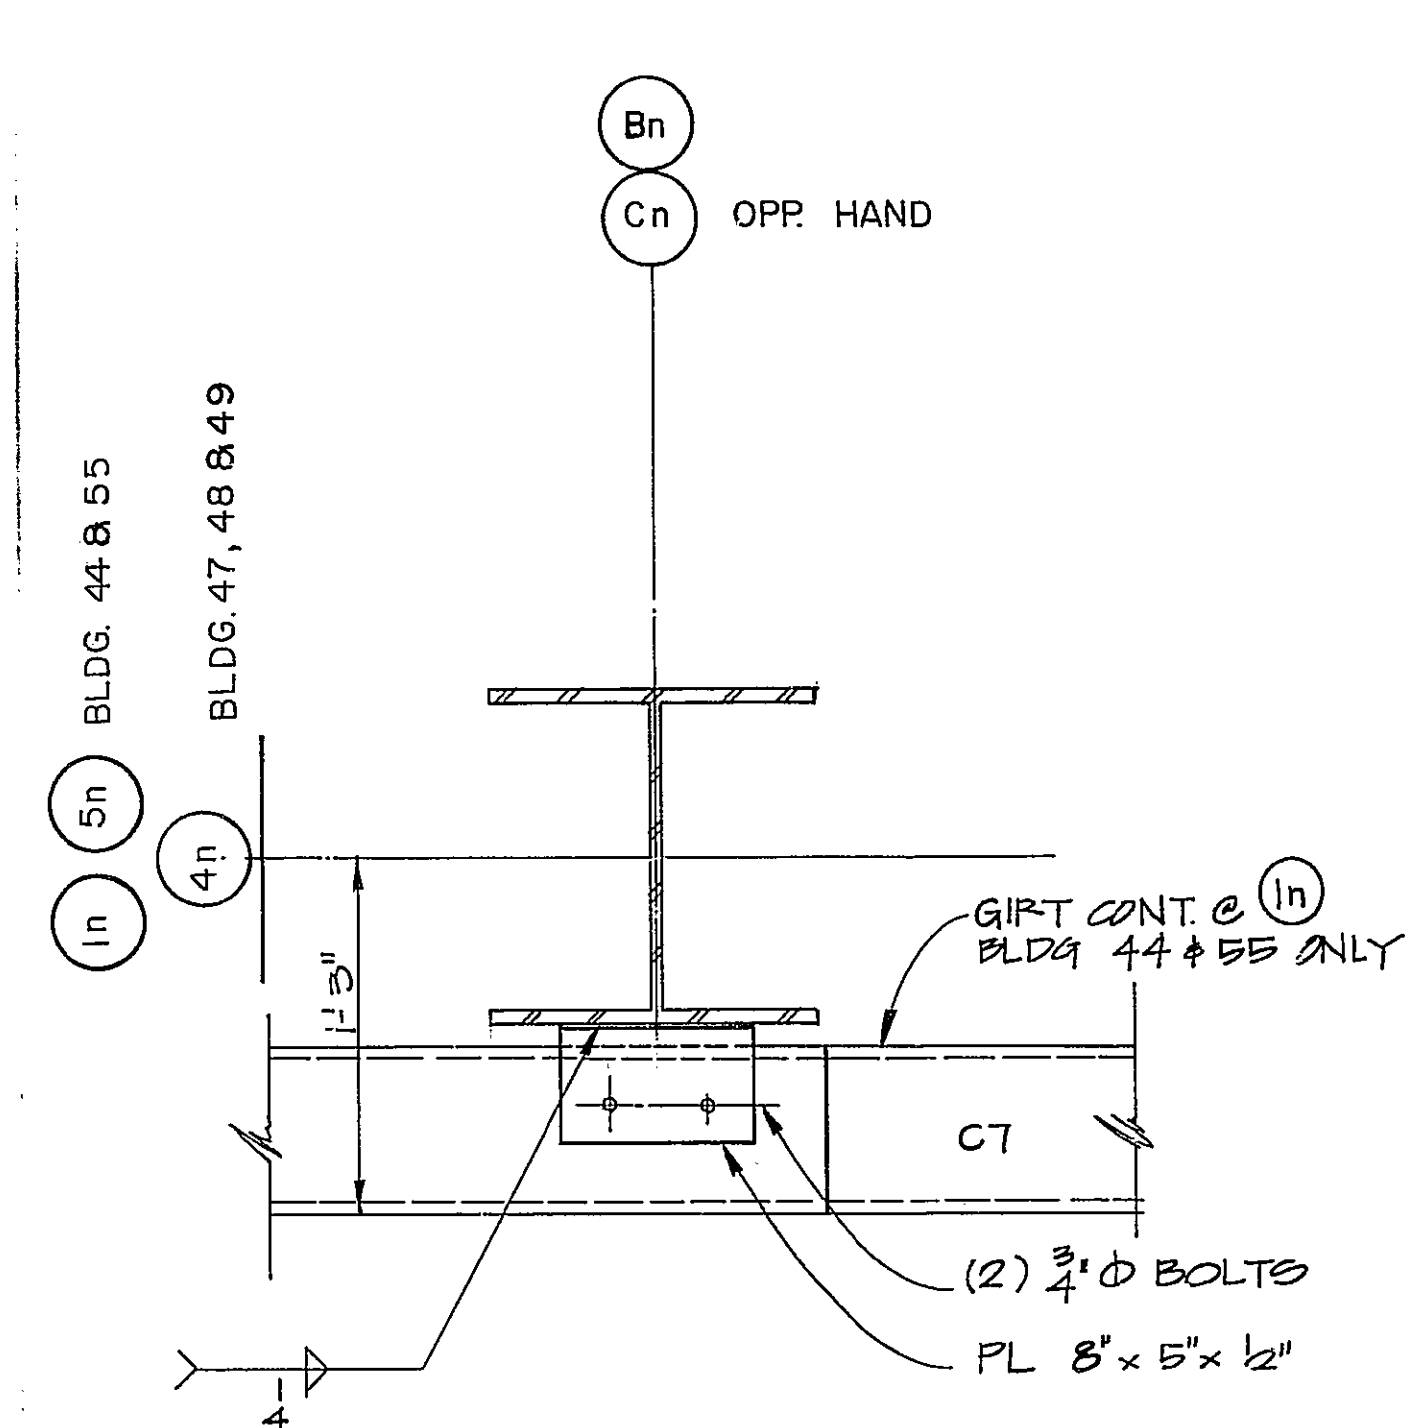


PLAN- GIRT TO COLUMN CONNECTION

SCALE: 1/2" = 1'-0"

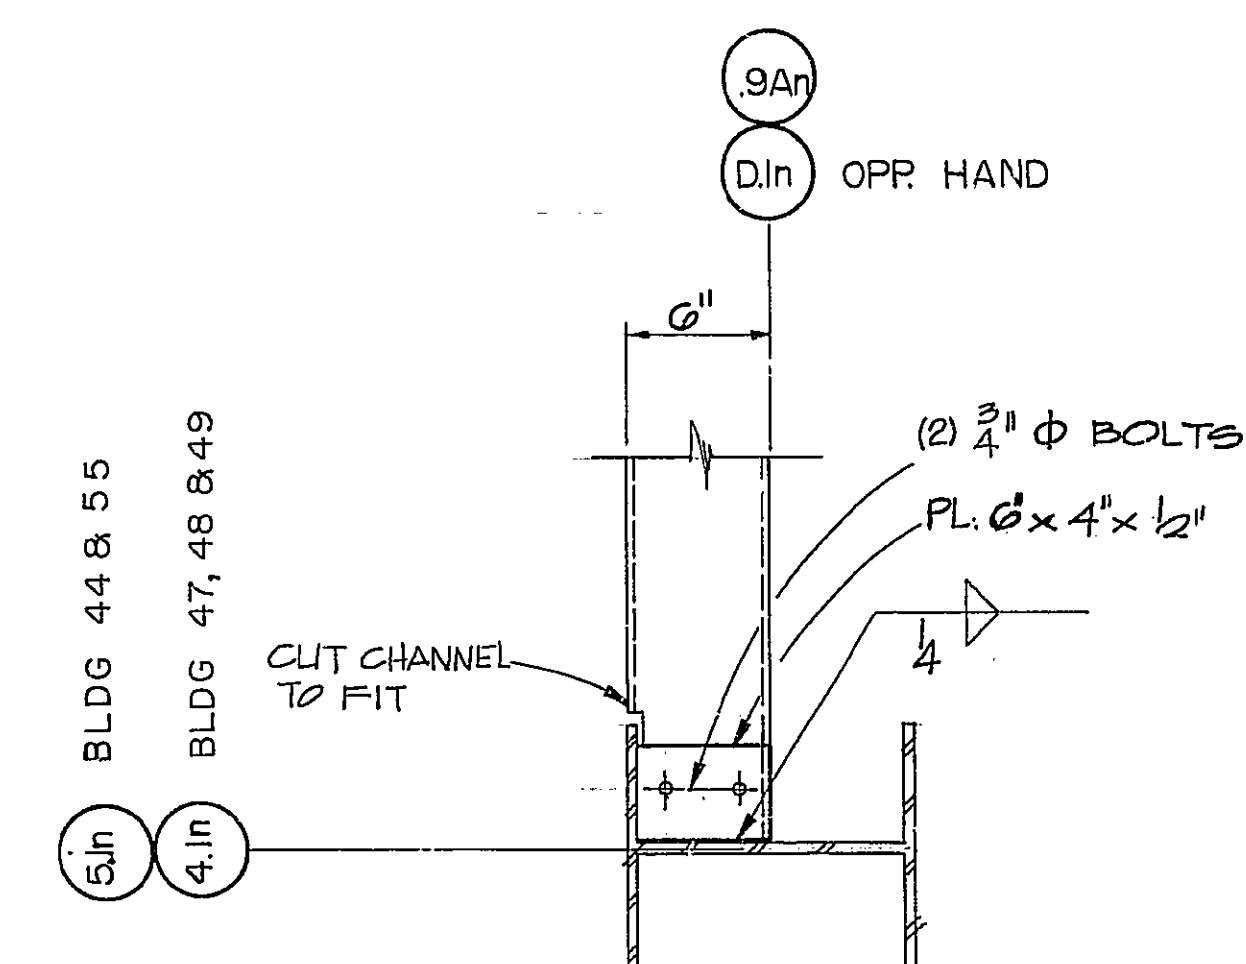


PLAN- GIRT TO COLUMN CONNECTION

SCALE: 1/2" = 1'-0"

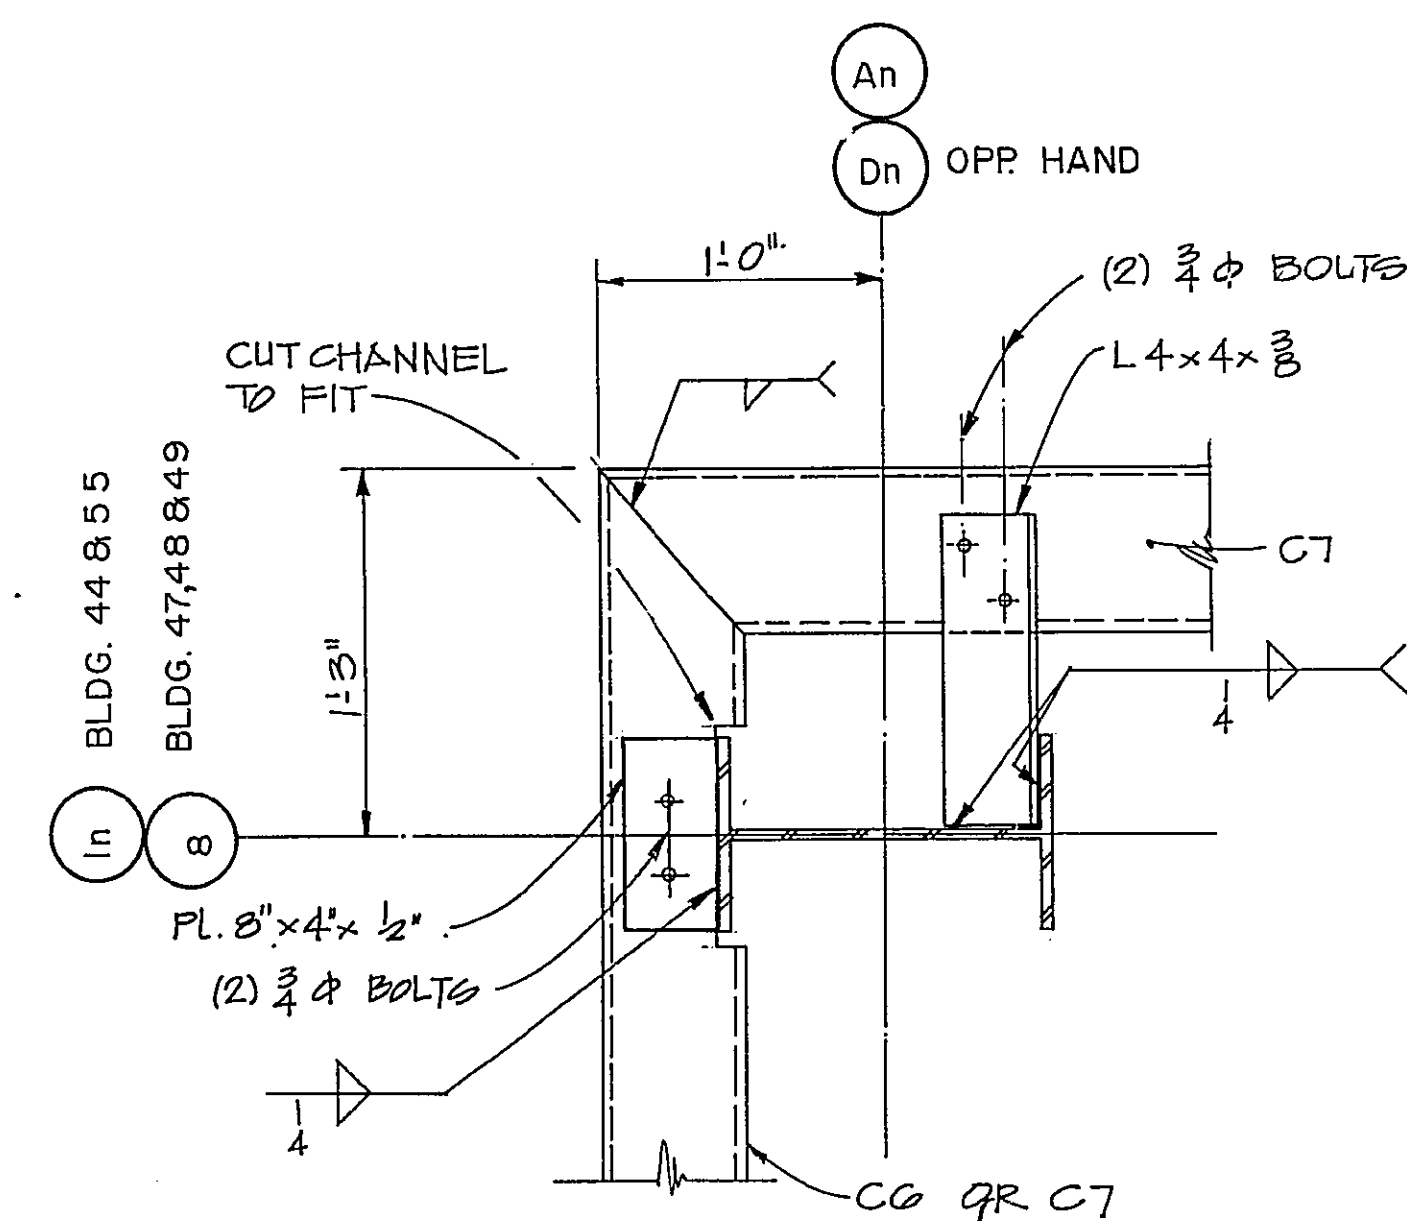


PLAN- GIRT TO COLUMN CONNECTION

SCALE: 1/2" = 1'-0"

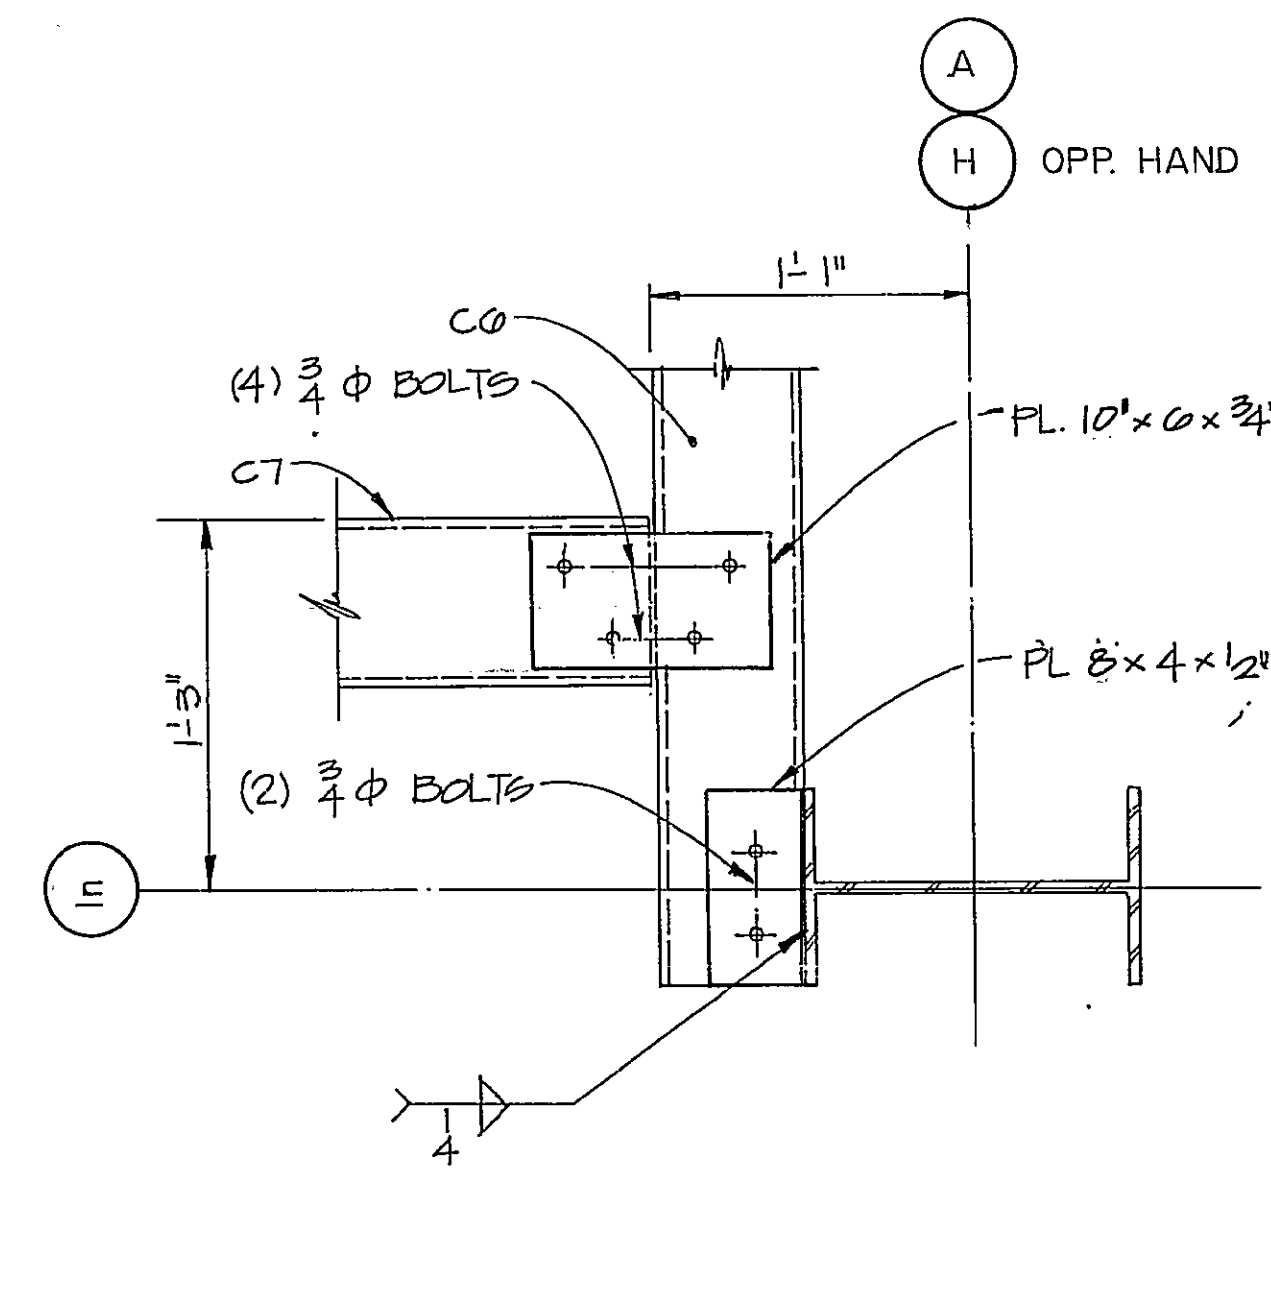


PLAN- GIRT TO COLUMN CONNECTION

SCALE: 1/2" = 1'-0"

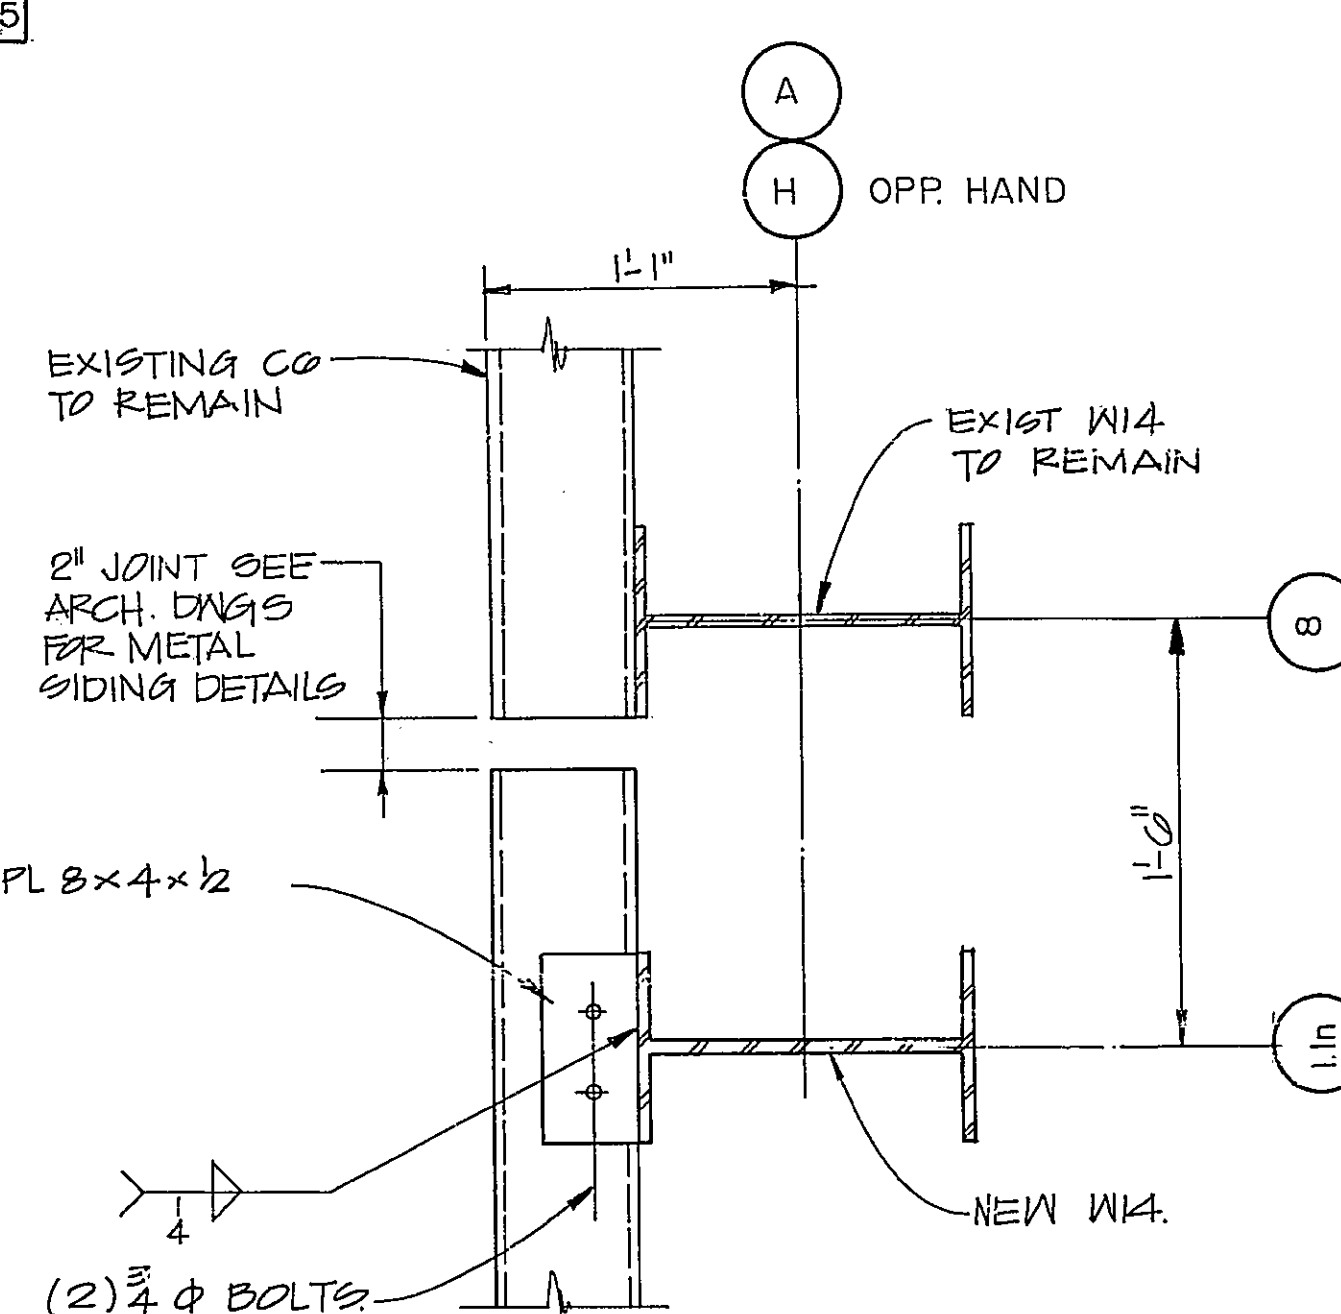


PLAN- GIRT TO COLUMN CONNECTION

SCALE: 1/2" = 1'-0"

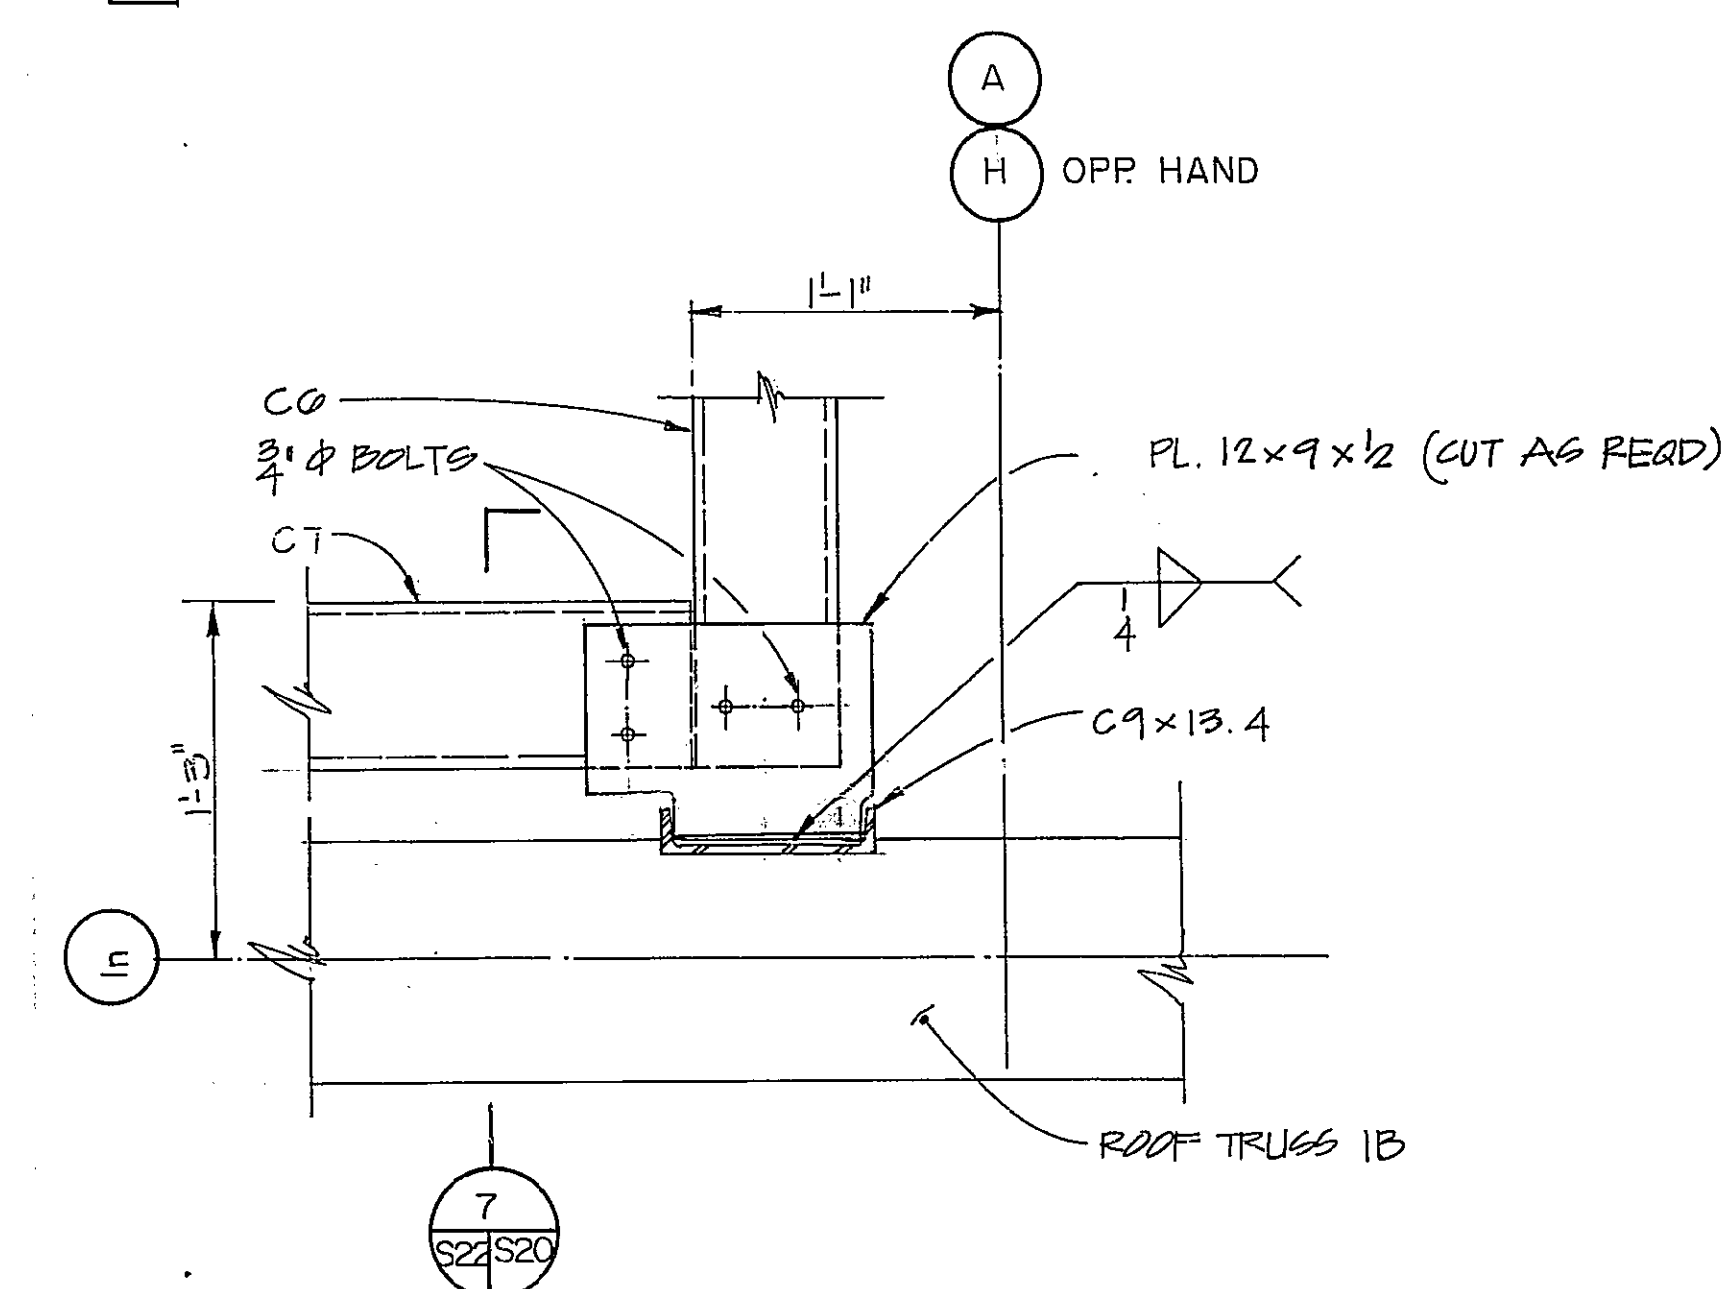


PLAN- GIRT TO TRUSS 1B CONNECTION

SCALE: 1/2" = 1'-0"

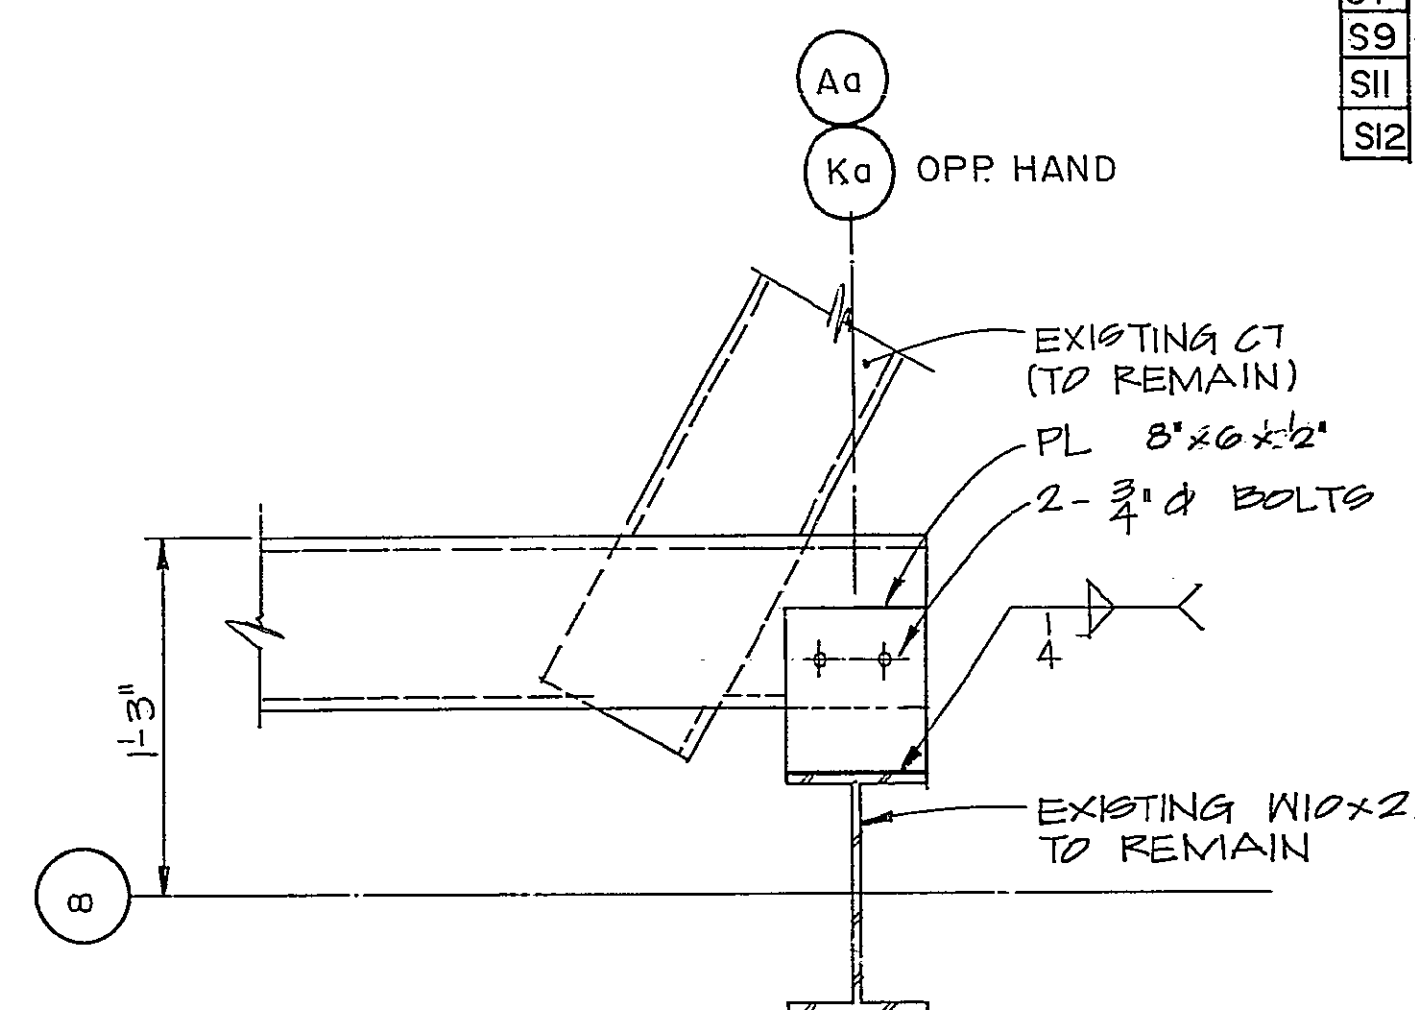

PLAN- GIRT TO COLUMN CONNECTION

SCALE: 1/2" = 1'-0"

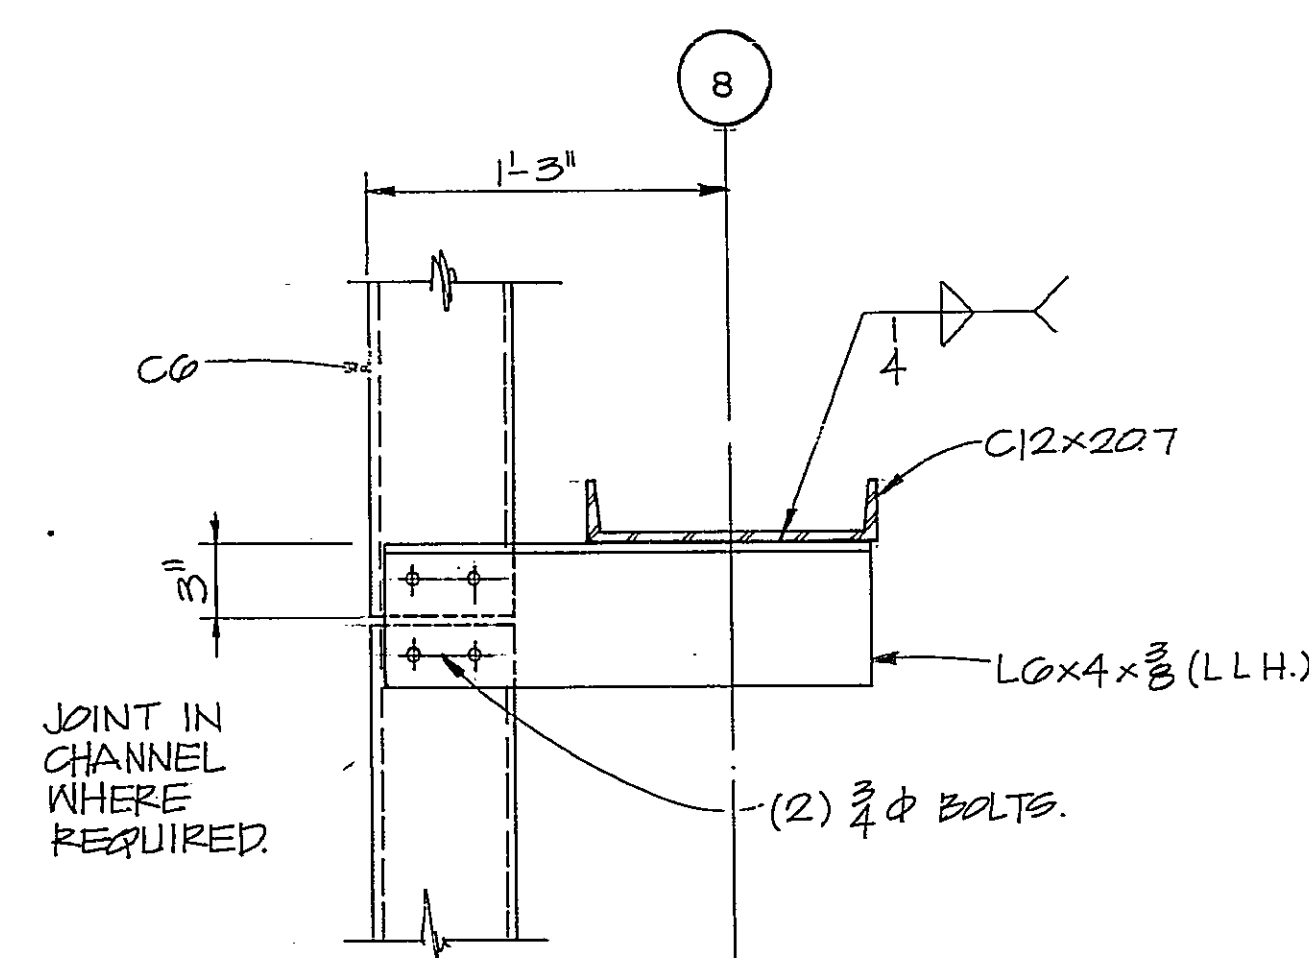

PLAN- GIRT TO TRUSS 2 CONN.

SCALE: 1/2" = 1'-0"

NOTES
1. FOR GENERAL NOTES SEE DWG. NO. 223

SCALE: 1/2" = 1'-0"

NOTE
ADJUST VERTICAL LOCATION OF NEW C7 TO MATCH EXISTING C7 AND EXISTING CONNECTION. COORDINATE NEW C7 LOCATIONS WITH METAL SIDING LAYOUT

WURZ WISECARVER & PRUETT
ARCHITECTS ENGINEERS
ATLANTA, GEORGIA

U. S. ARMY
ENGINEER DISTRICT, SAVANNAH
CORPS OF ENGINEERS
SAVANNAH, GEORGIA

NOSE DOCK EMPENNAGE ENCLOSURE
SECTIONS AND DETAILS


ROBINS AIR FORCE BASE, GEORGIA

SIZE: INVITATION NO. DRAWING NO. PLATE



F: DCA 21-85-B-0090 39-01-08 S-22

SCALE: AS SHOWN SHEET 52



SYMBOL	ZONE	DESCRIPTION	DATE	BY
		REVISIONS		

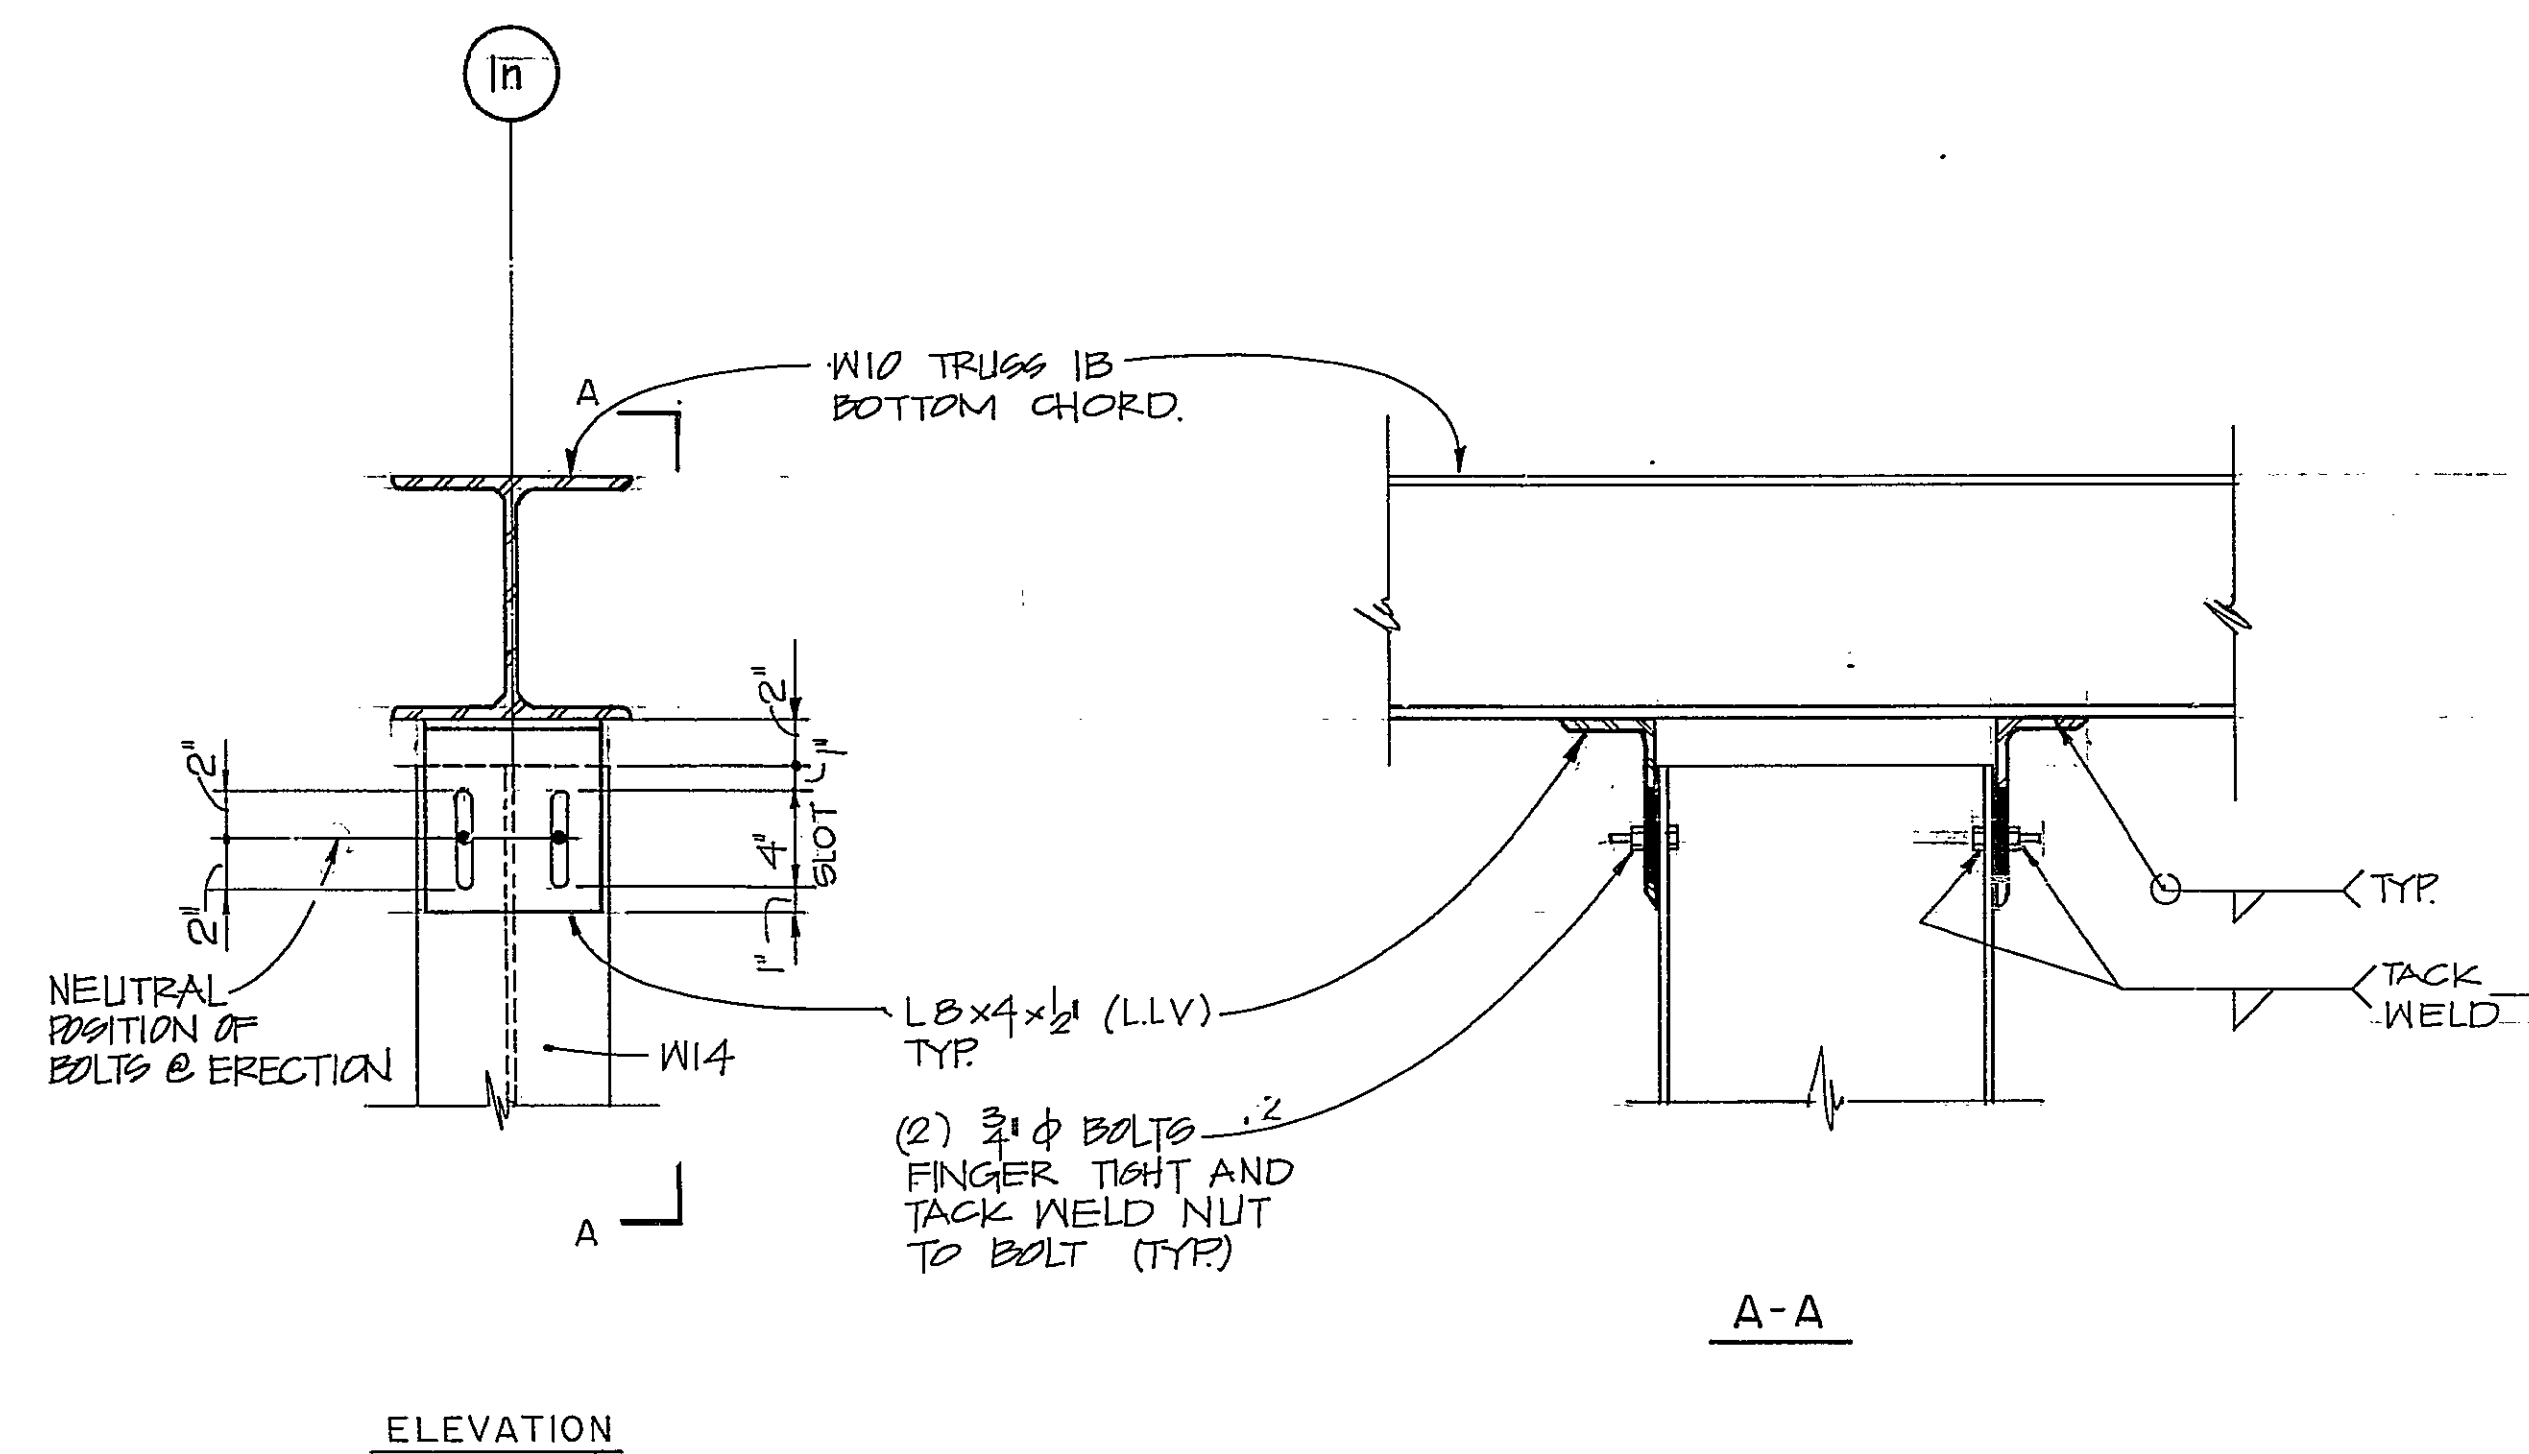



VERTICAL SLOTTED CONNECTION
SCALE: 1/2" = 1'-0"

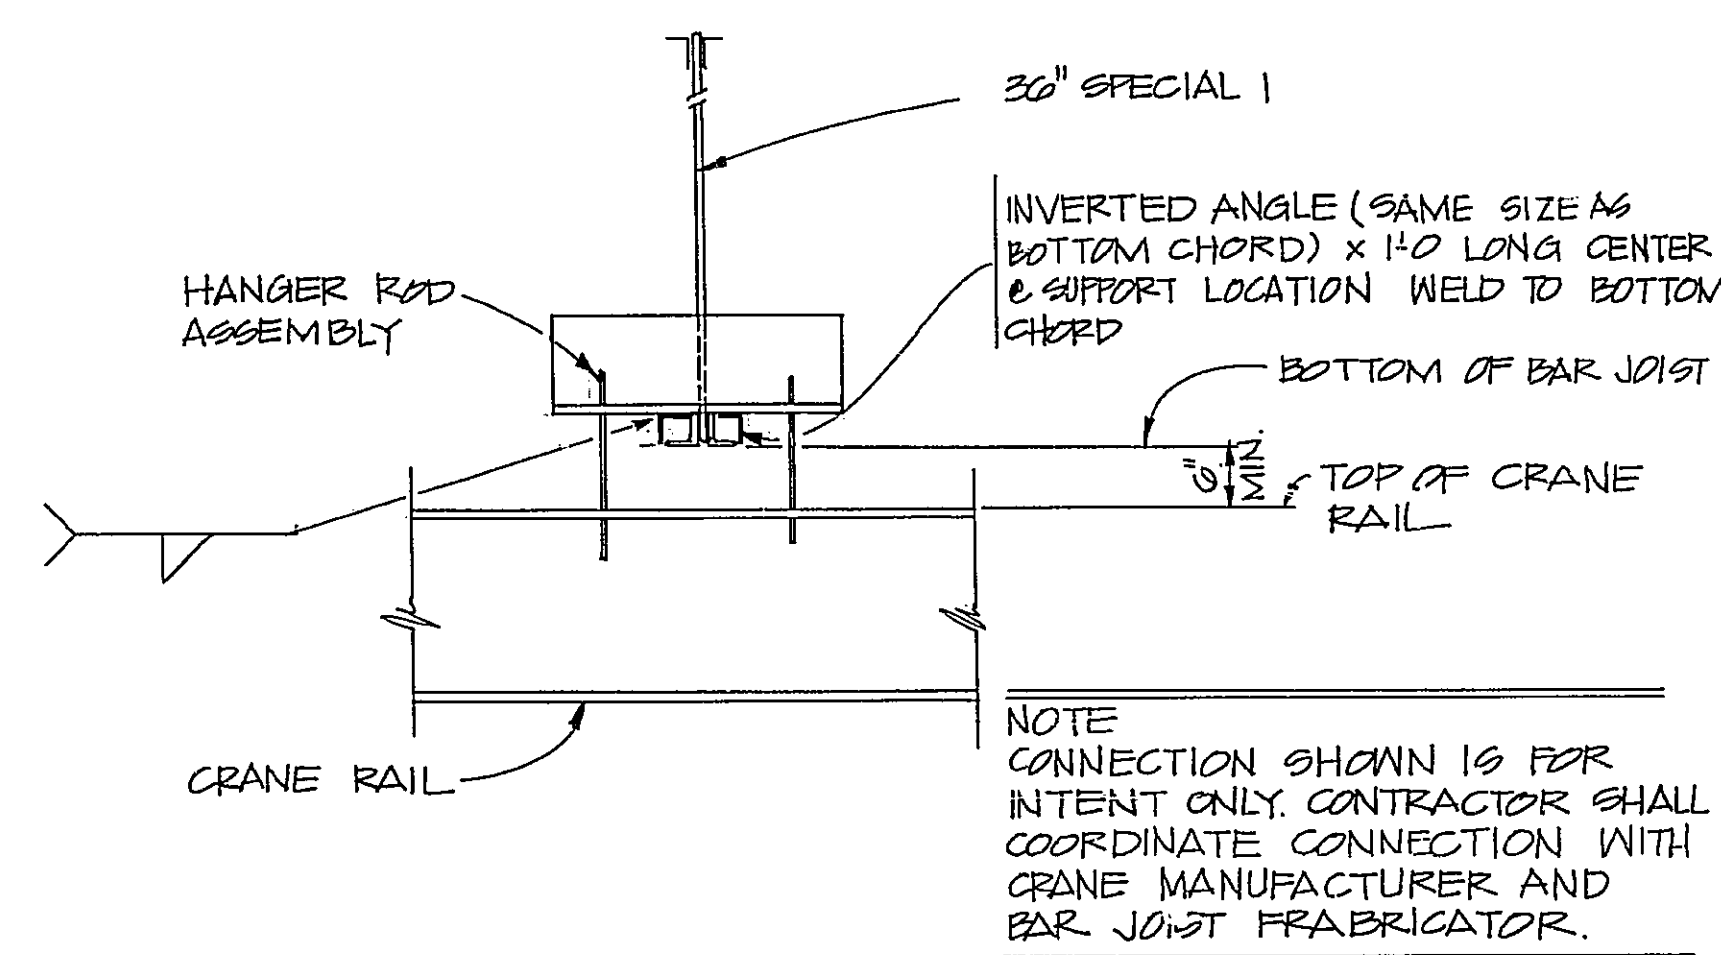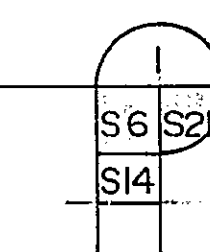



CRANE RAIL CONNECTION
SCALE: 1" = 1'-0"

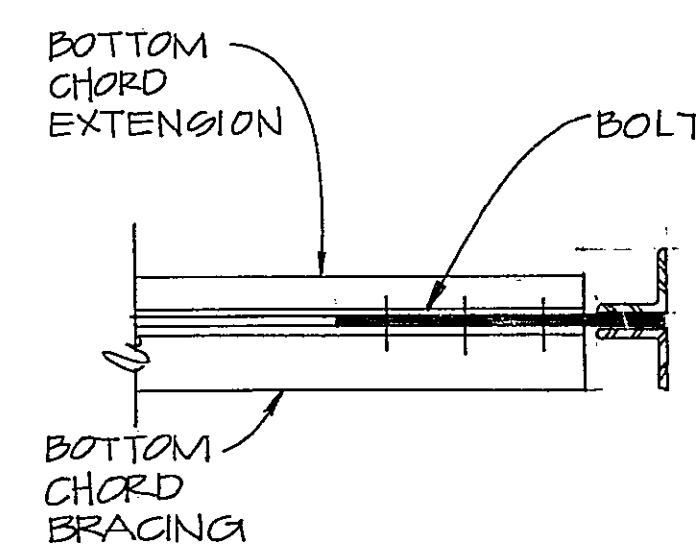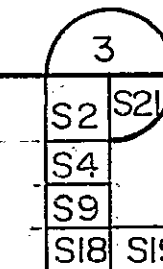



SECTION BOTT. CHORD BRACING CONNECTION
SCALE: 1" = 1'-0"

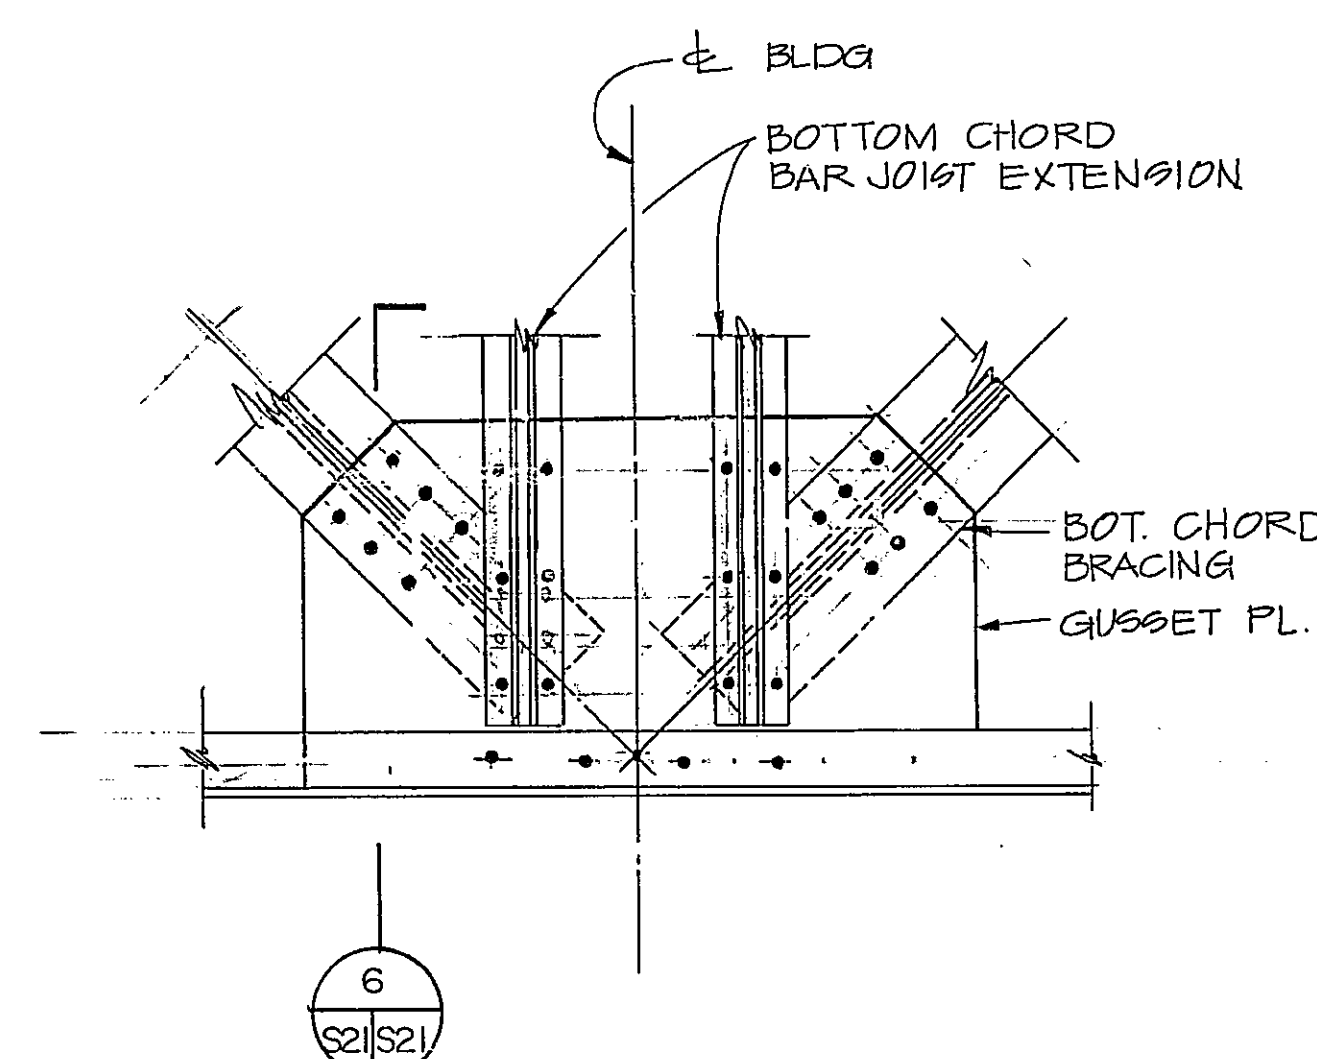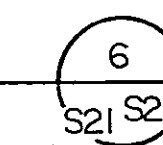



PLAN-BOTT. CHORD BRACING CONNECTION
SCALE: 1" = 1'-0"

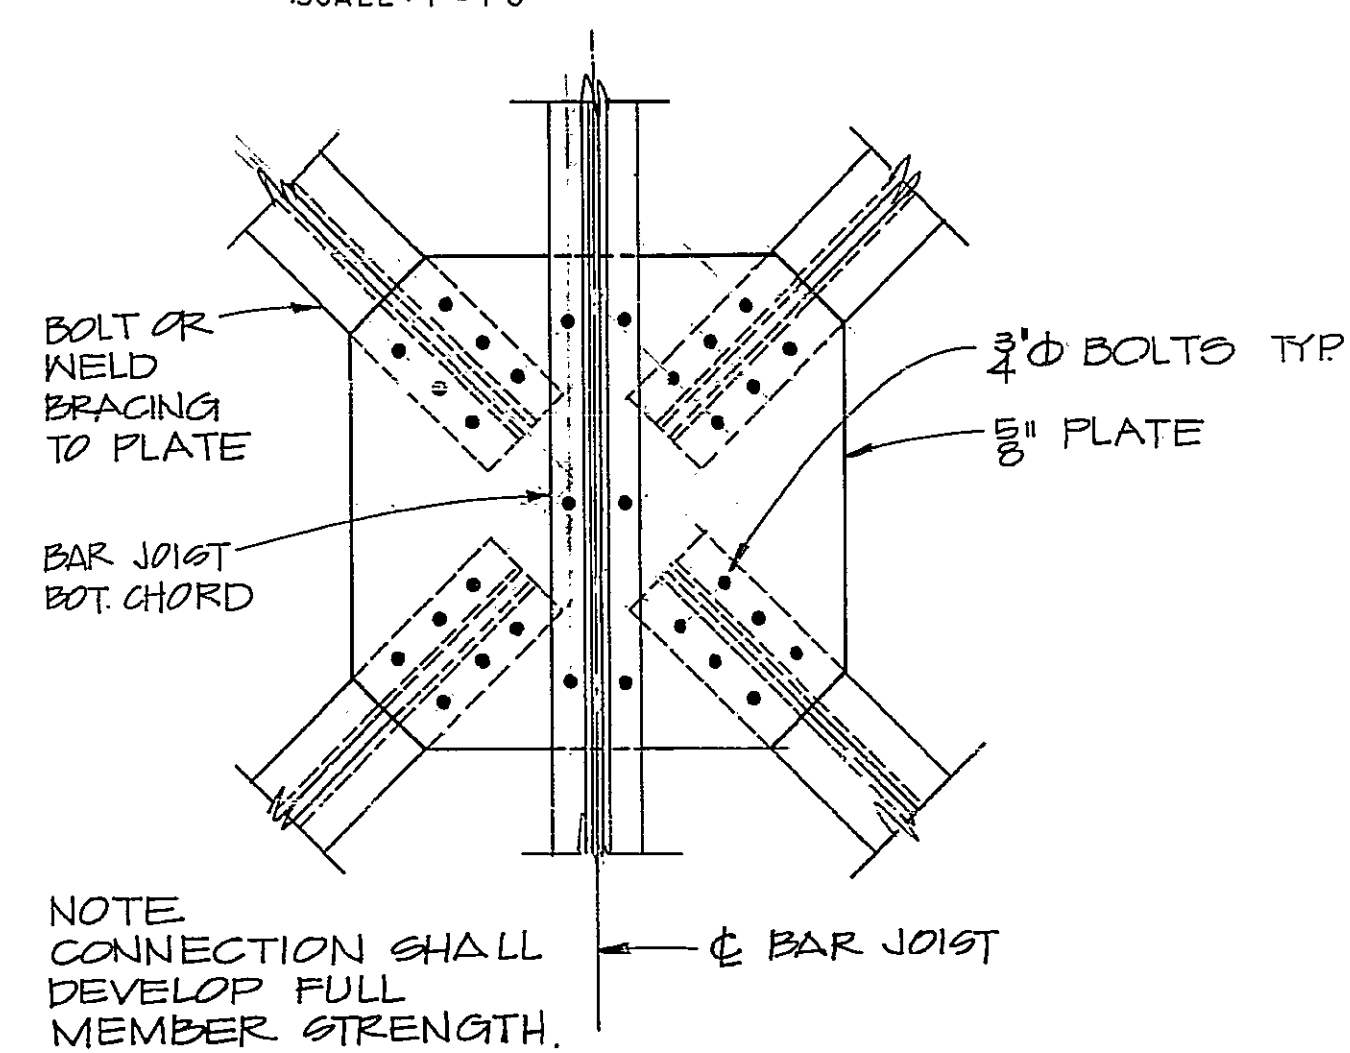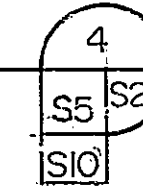



PLAN-BOTTOM CHORD BRACING CONNECTION
SCALE: 1" = 1'-0"

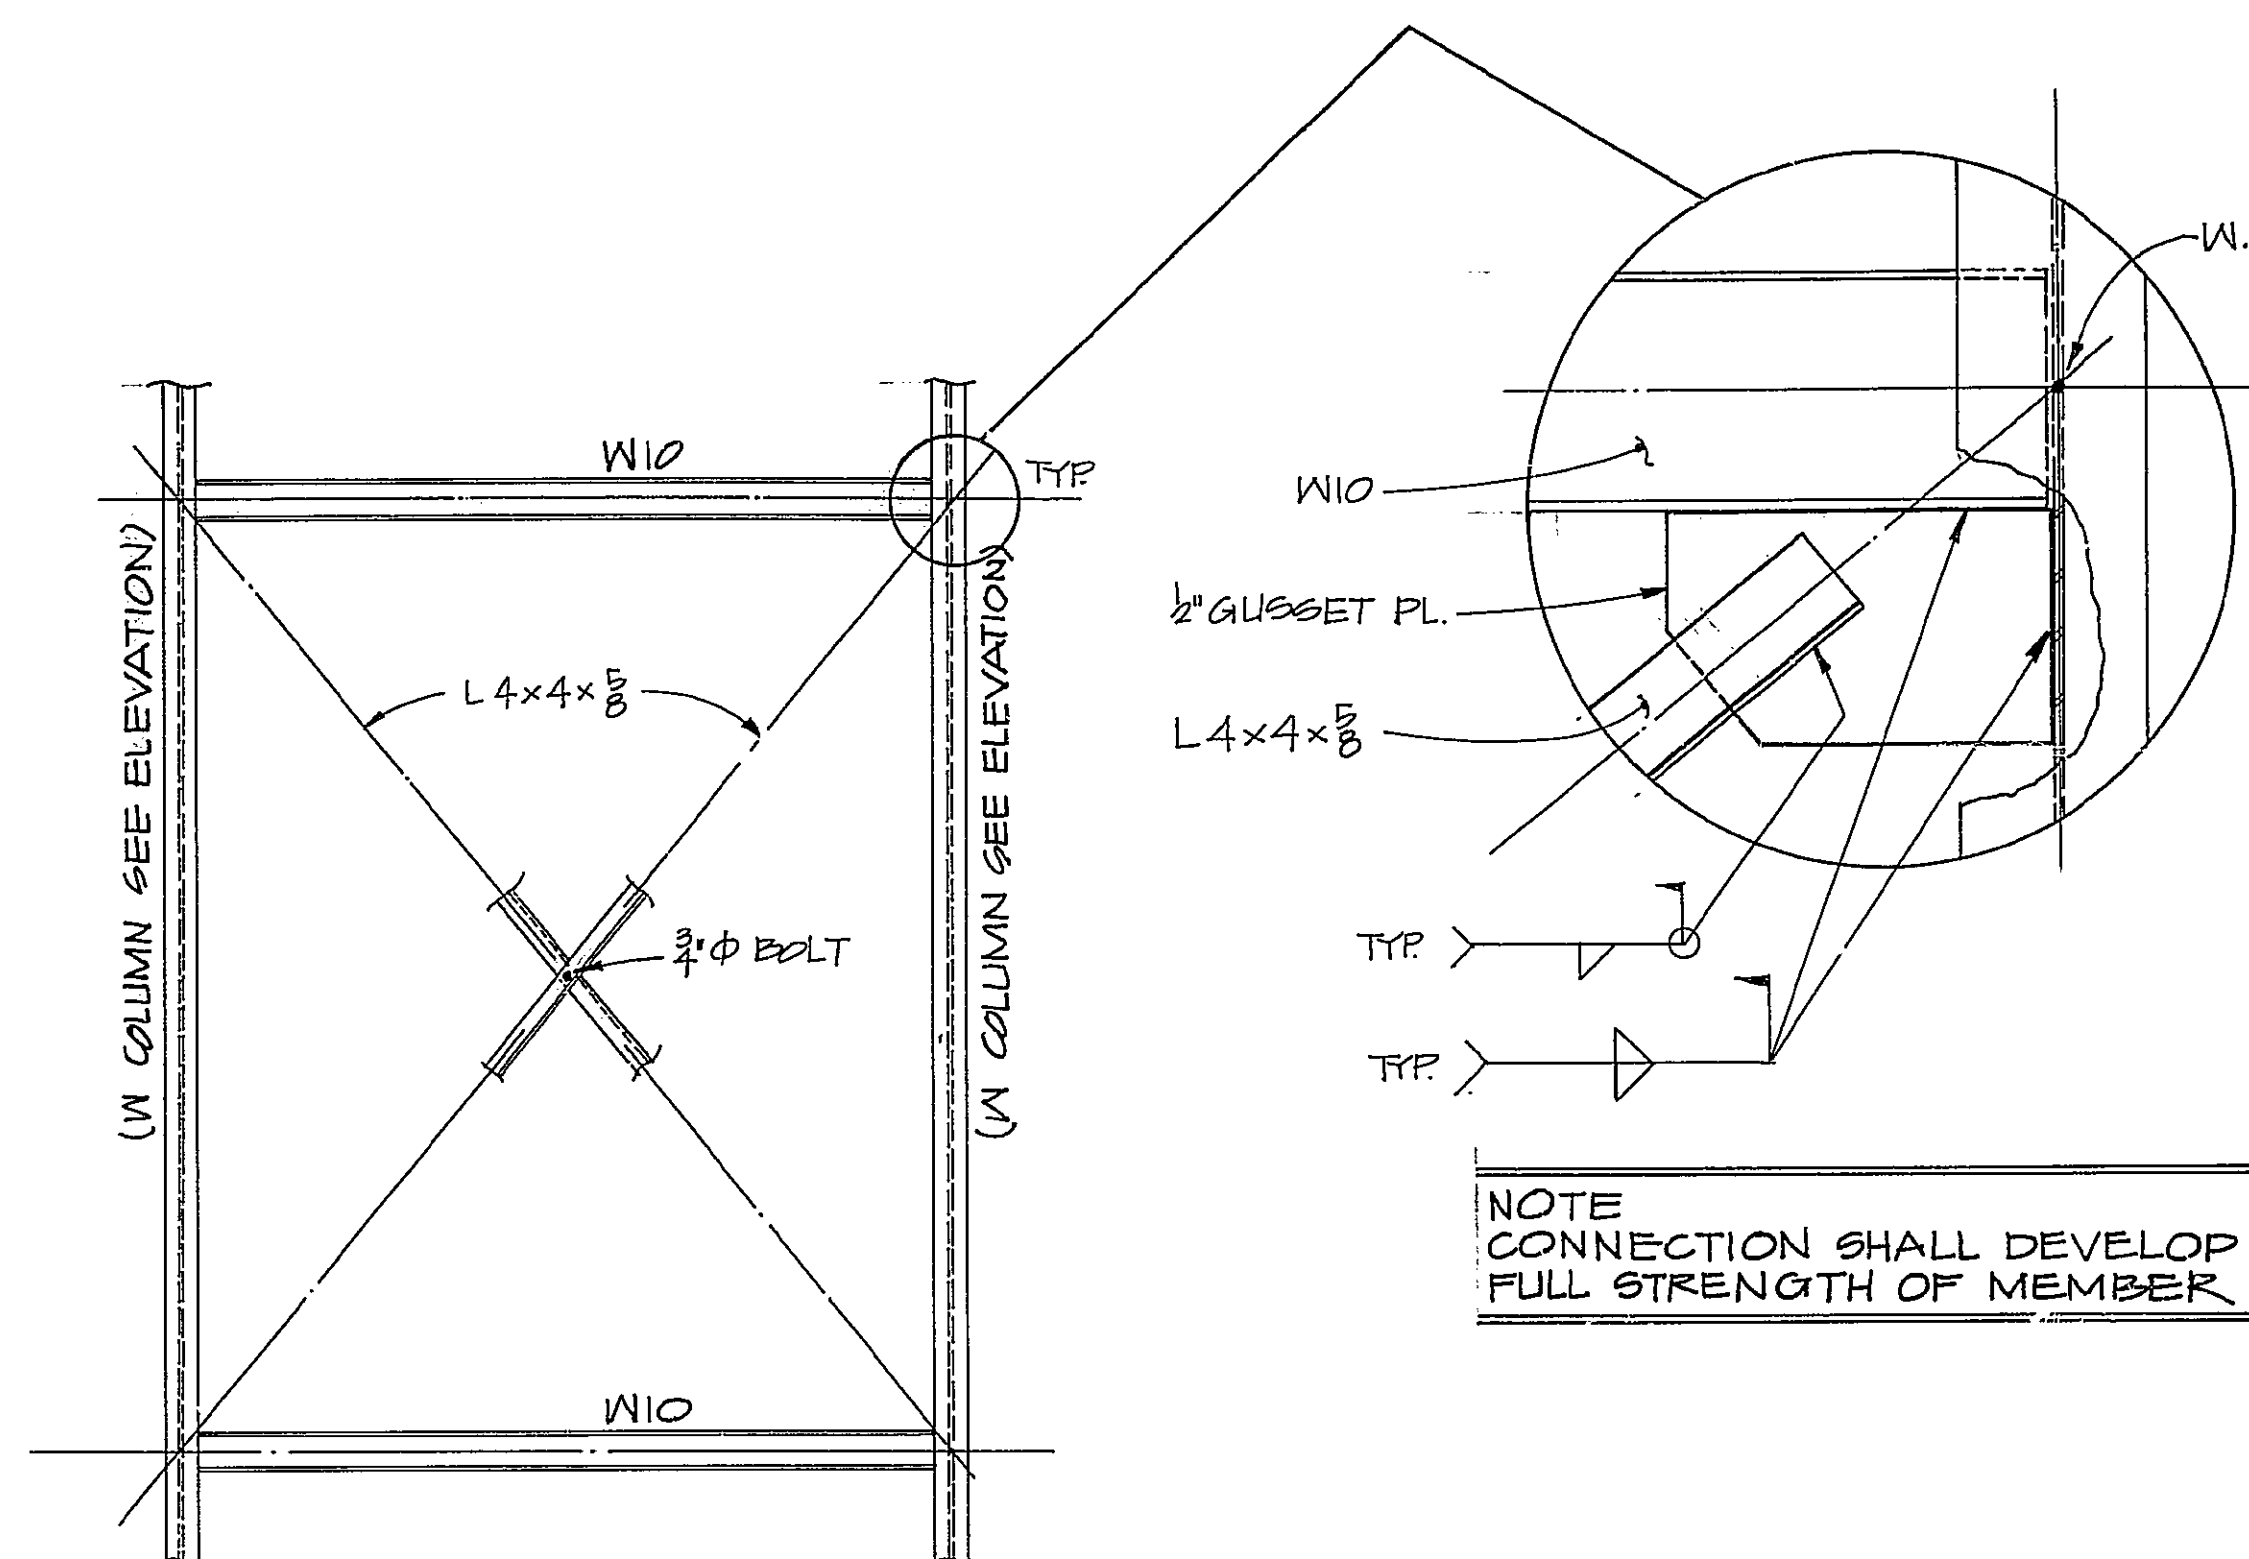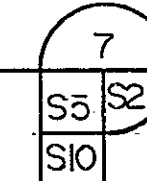


"X" BRACING DETAIL
SCALE: 3/8" = 1'-0"

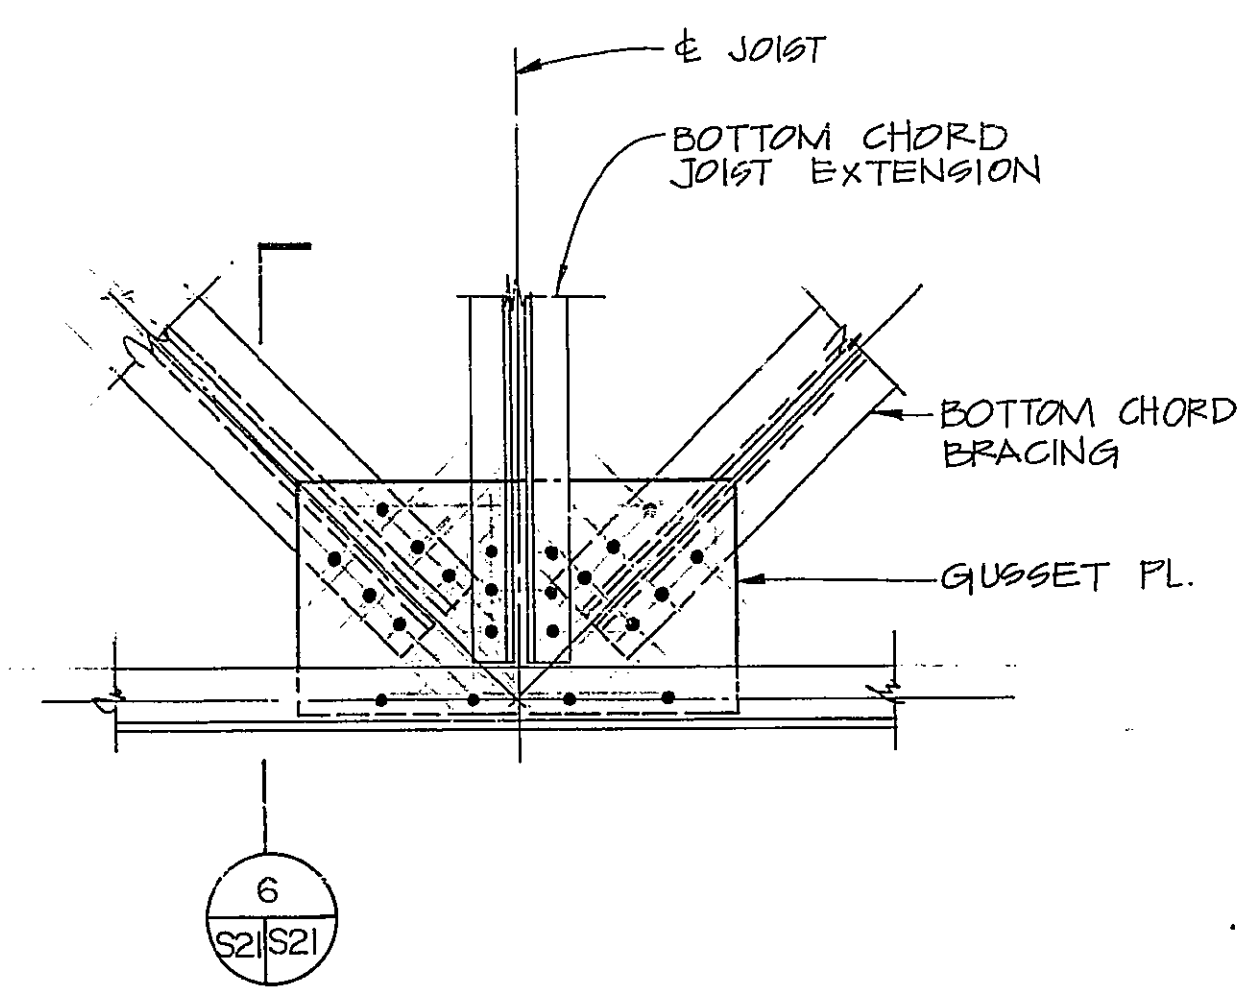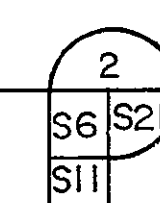


PLAN-BOTT. CHORD BRACING CONNECTION
SCALE: 1" = 1'-0"

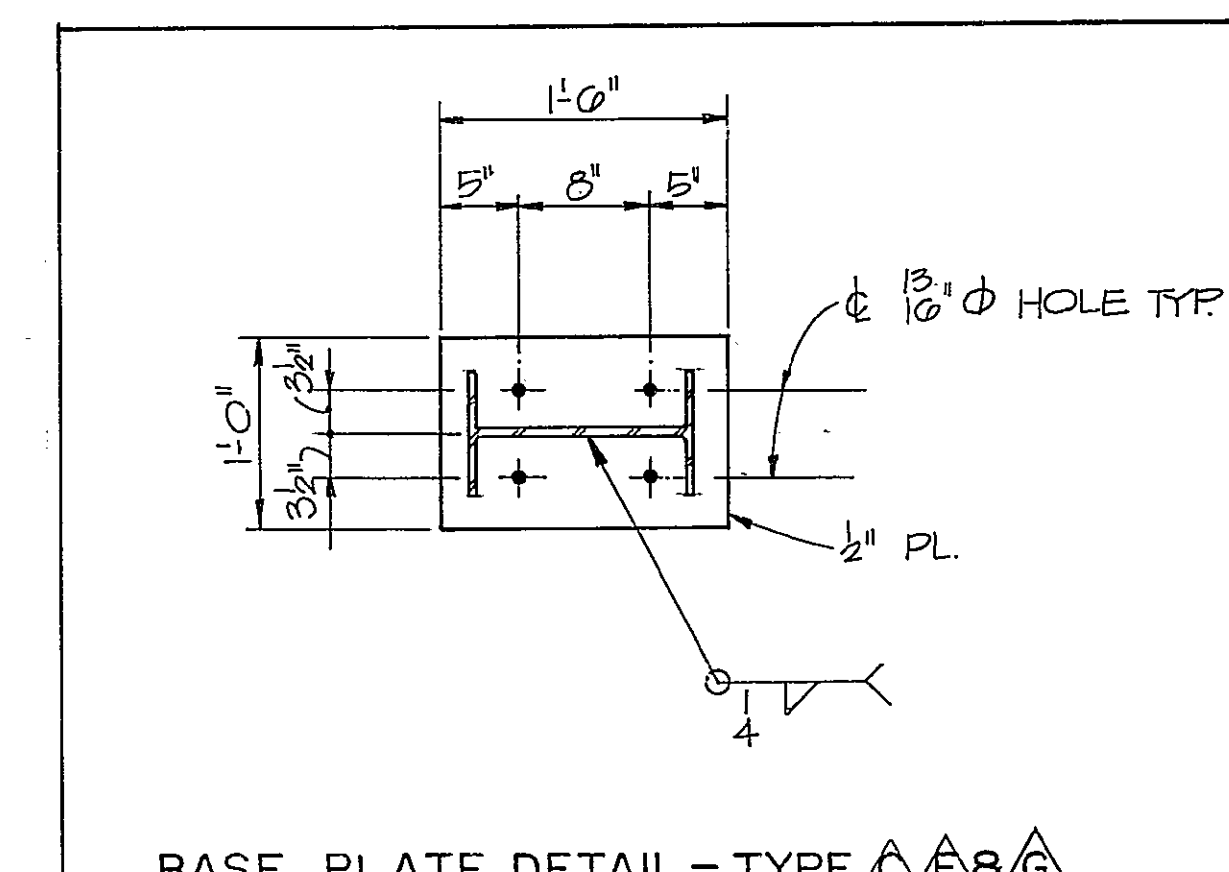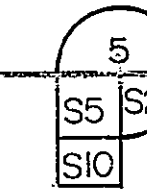


BASE PLATE DETAIL - TYPE A, B, C
SCALE: 1" = 1'-0"

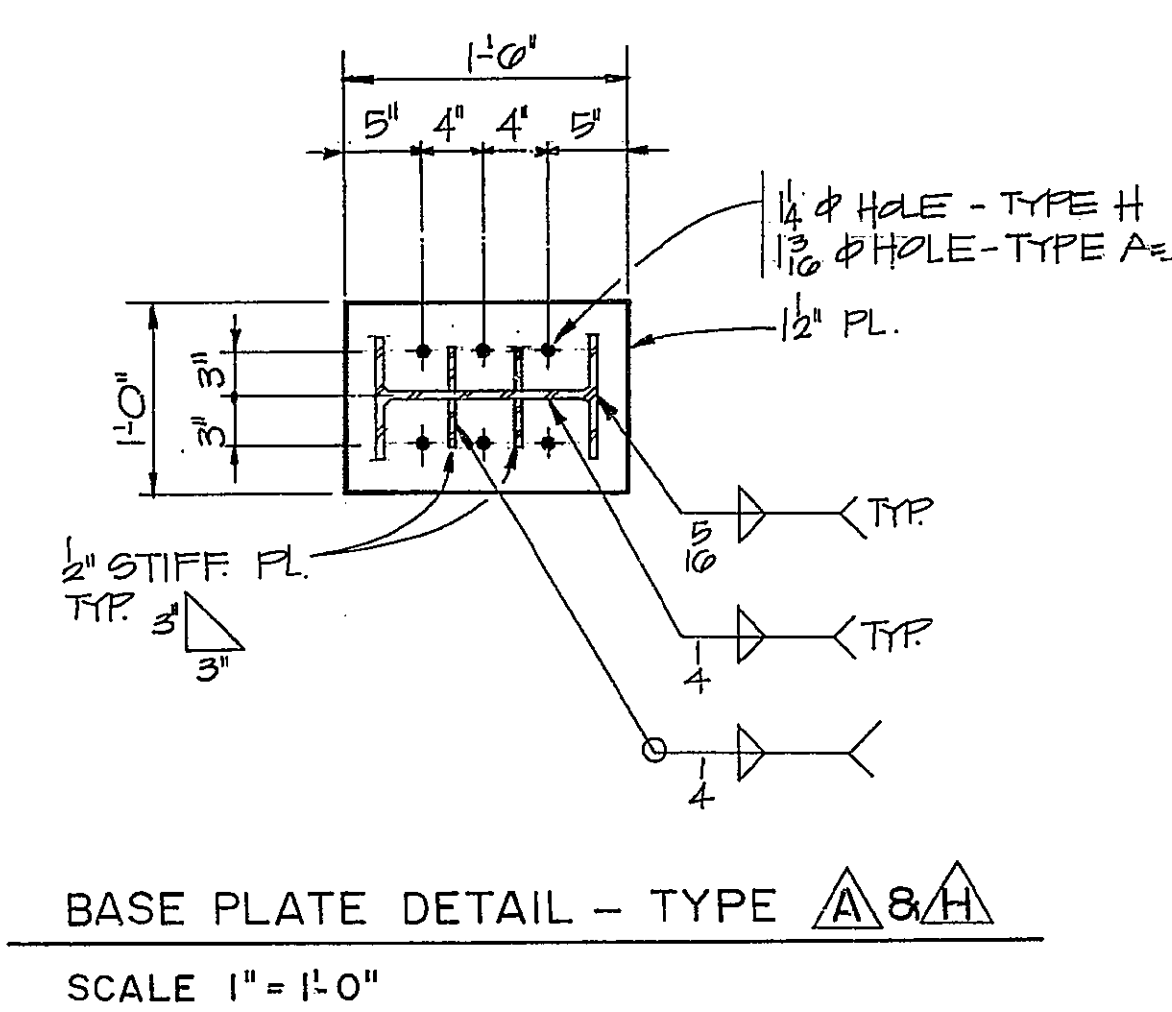


BASE PLATE DETAIL - TYPE A, B
SCALE: 1" = 1'-0"

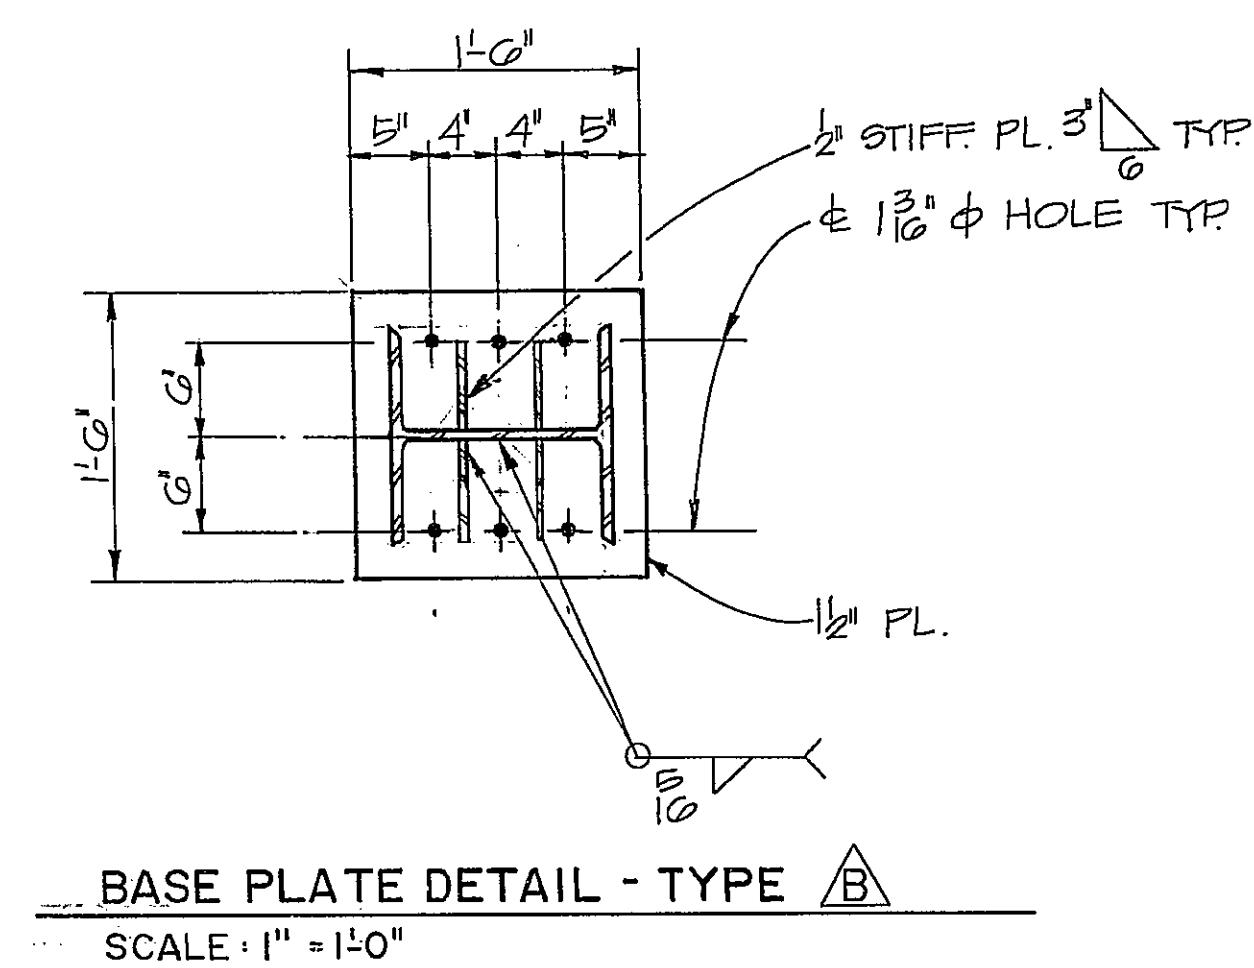

BASE PLATE DETAIL - TYPE A
SCALE: 1" = 1'-0"

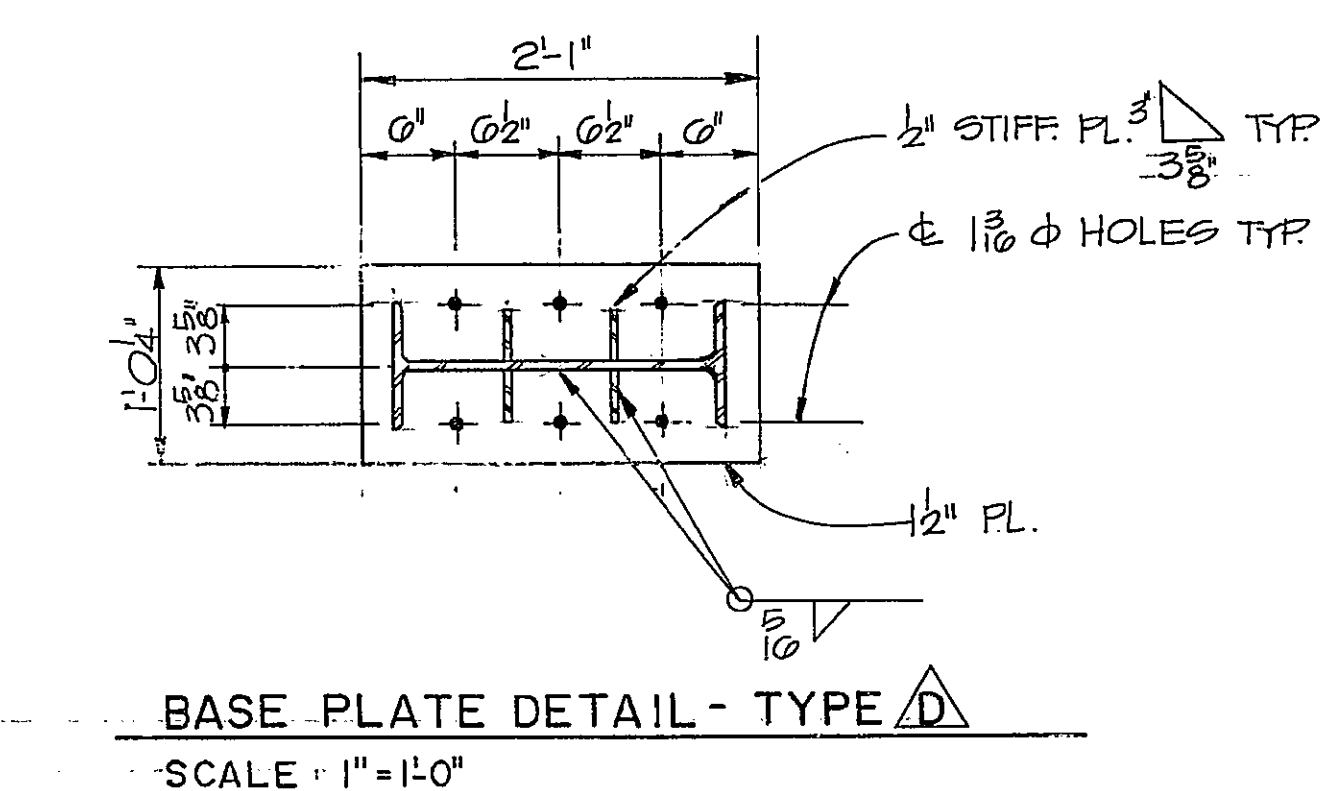



BASE PLATE DETAIL - TYPE D
SCALE: 1" = 1'-0"

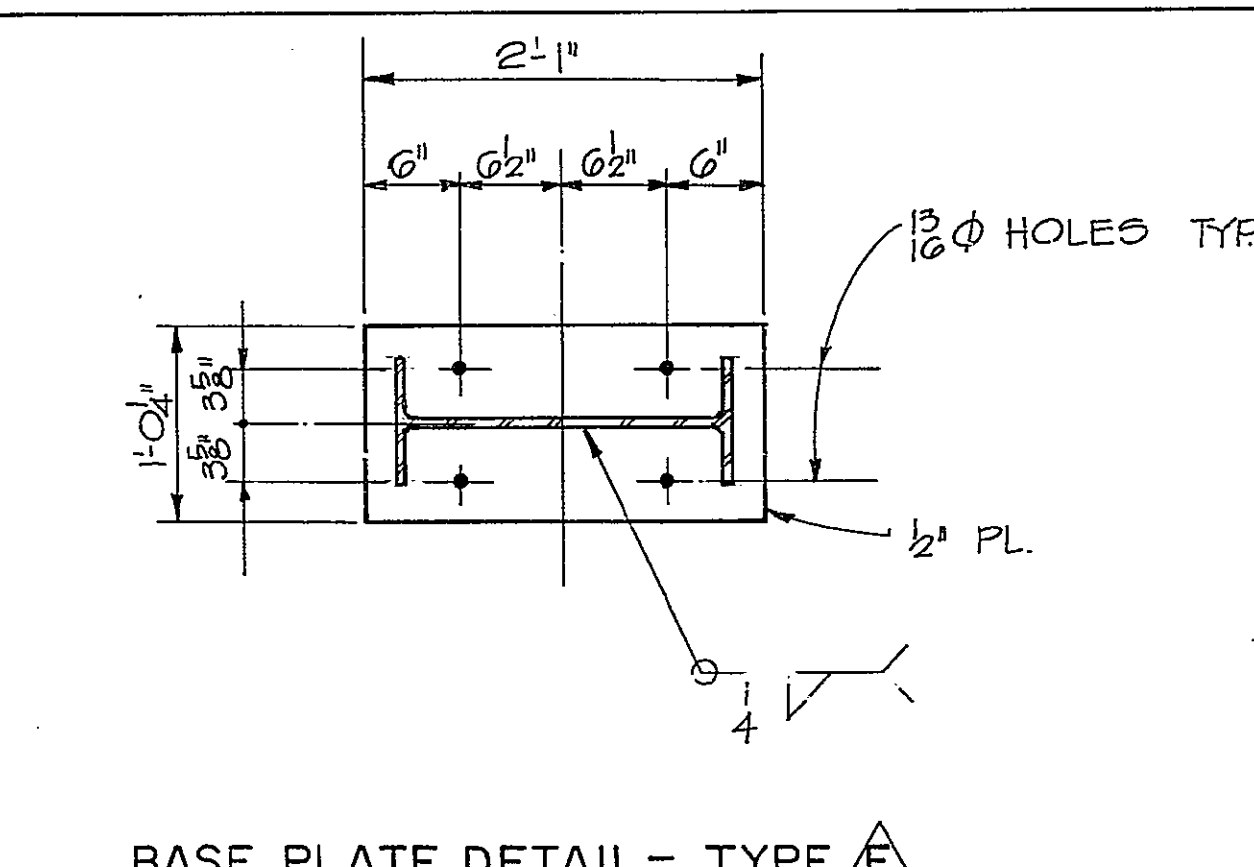

BASE PLATE DETAIL - TYPE E
SCALE: 1" = 1'-0"


NOTES

1. FOR GENERAL NOTES SEE DWG 523

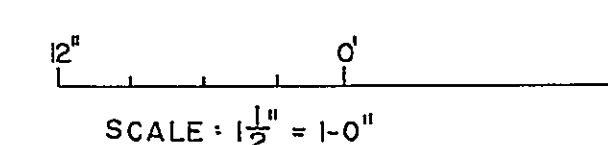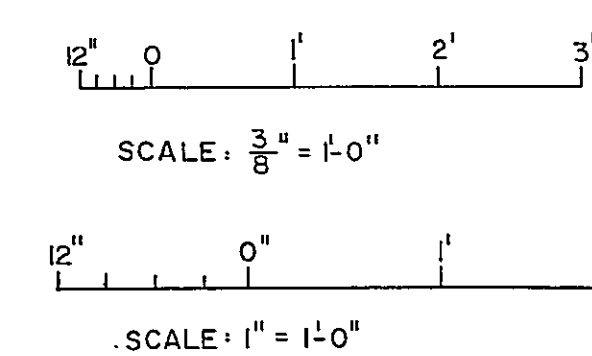


SYMBOL	ZONE	DESCRIPTION	DATE	BY


WURZ WISECARVER & PRUETT ARCHITECTS ATLANTA, GEORGIA		U.S. ARMY ENGINEER DISTRICT, SAVANNAH CORPS OF ENGINEERS SAVANNAH, GEORGIA	
NOSE DOCK EMPENNAGE ENCLOSURE			
SECTIONS AND DETAILS			
ROBINS AIR FORCE BASE, GEORGIA		PLATE	
SIZE	INVESTIGATION NO.	DRAWING NO.	
F	DACA 21-85-8-0093	39-01-08	S-21
SCALE: AS SHOWN		SHEET 51	

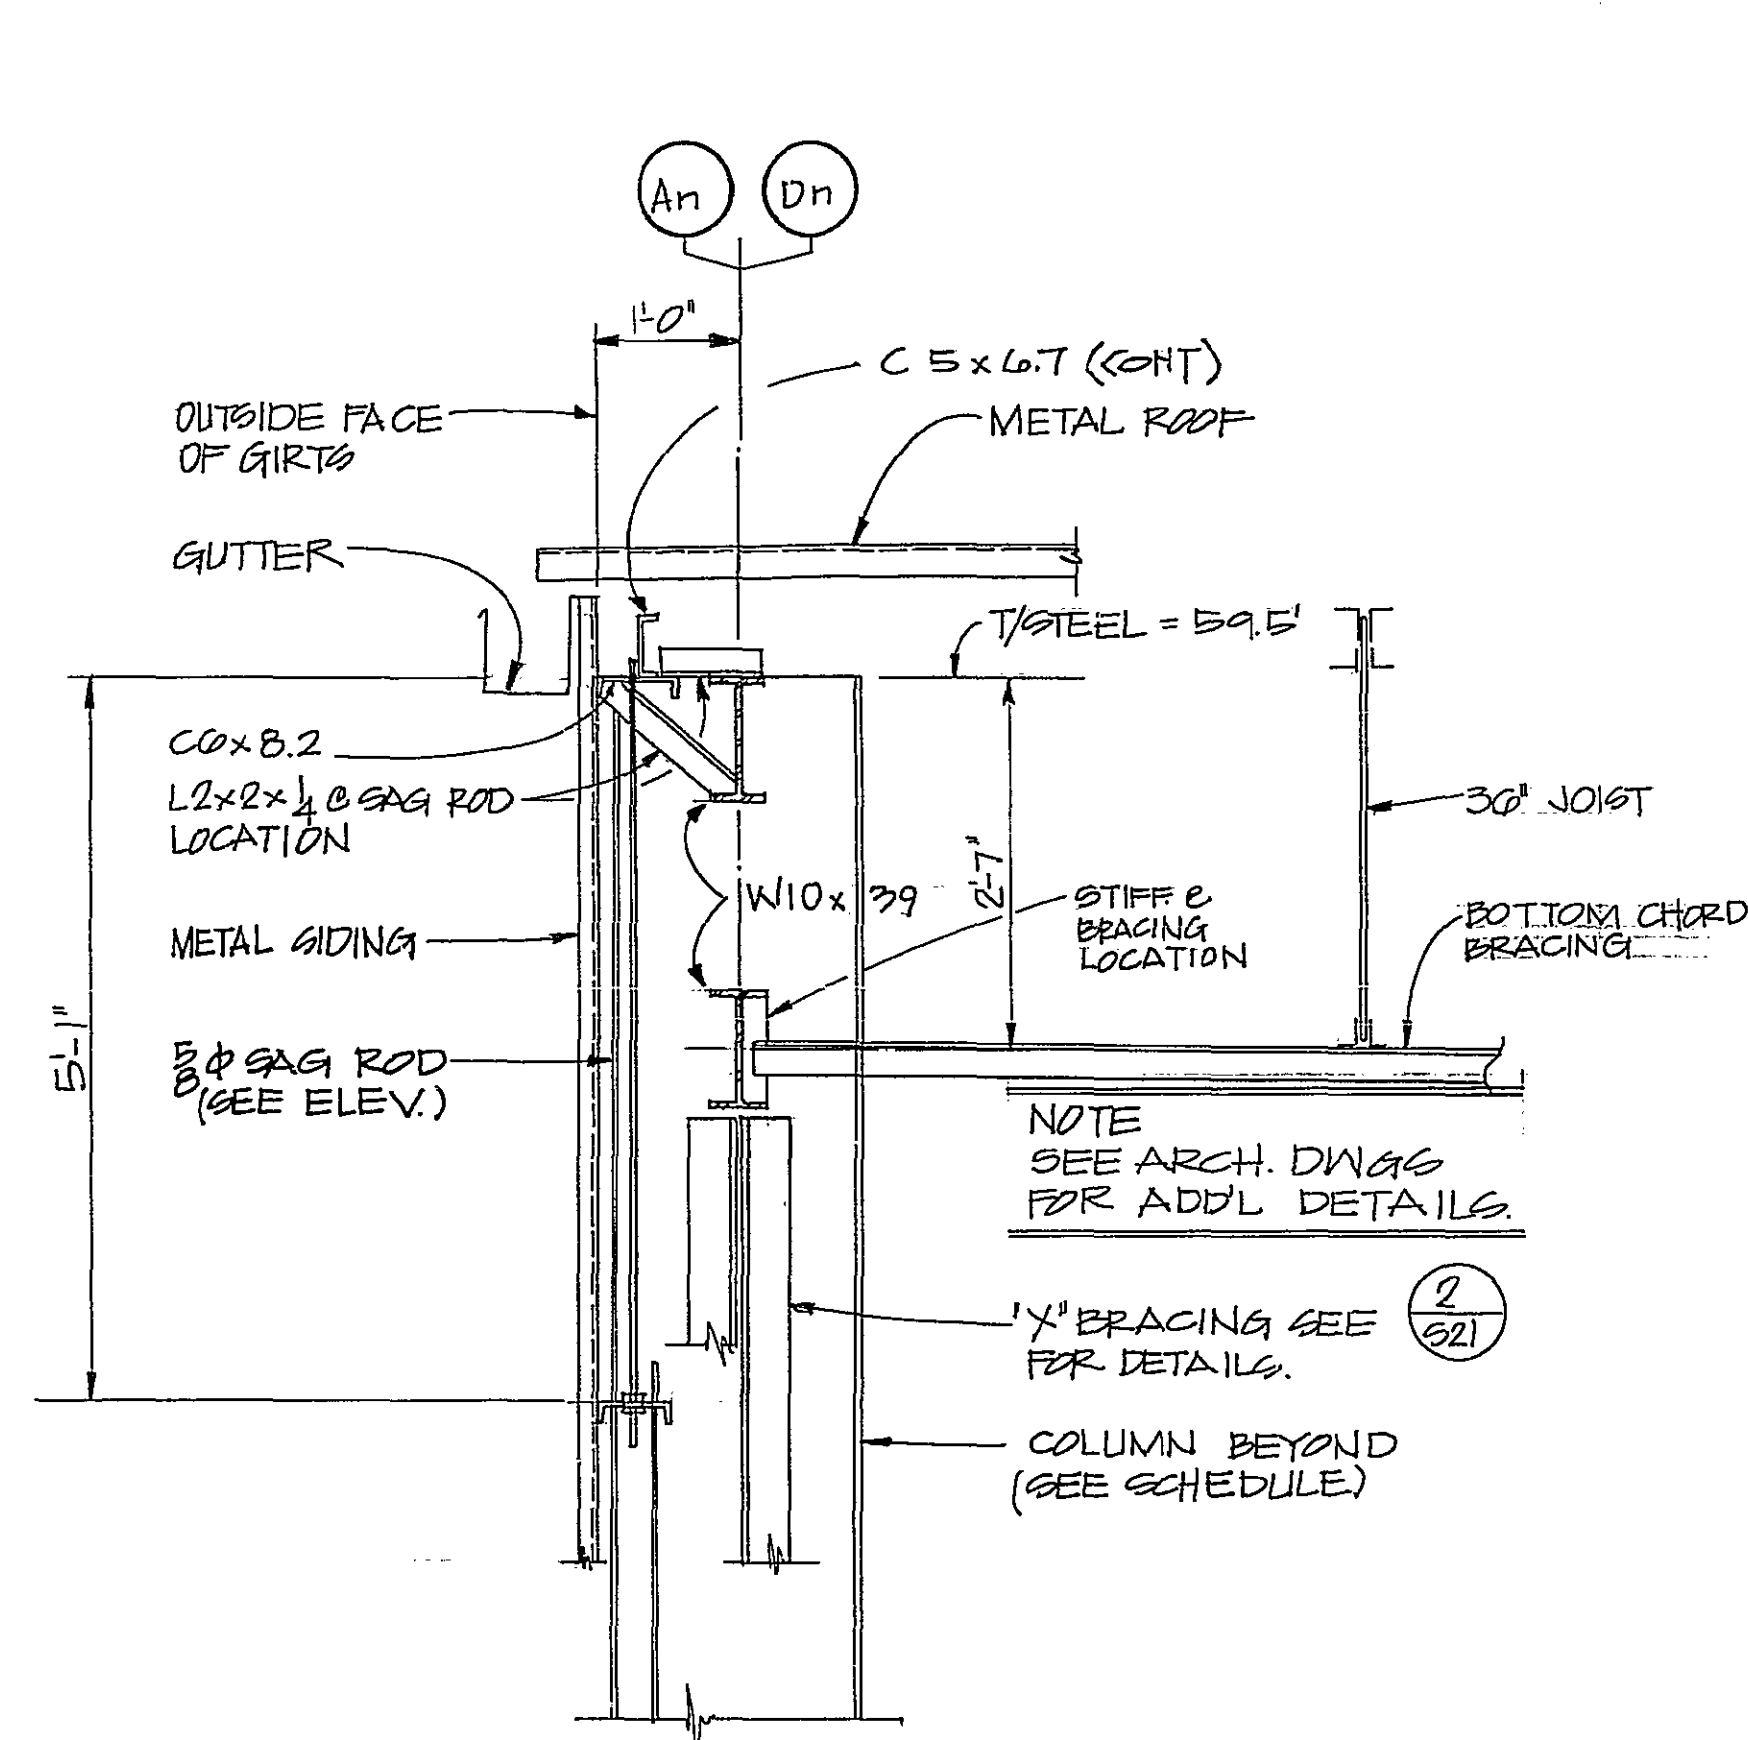


SECTION 1
SCALE: $\frac{3}{4} = 1'-0"$
S2 S20
S4
S9
S5
S10

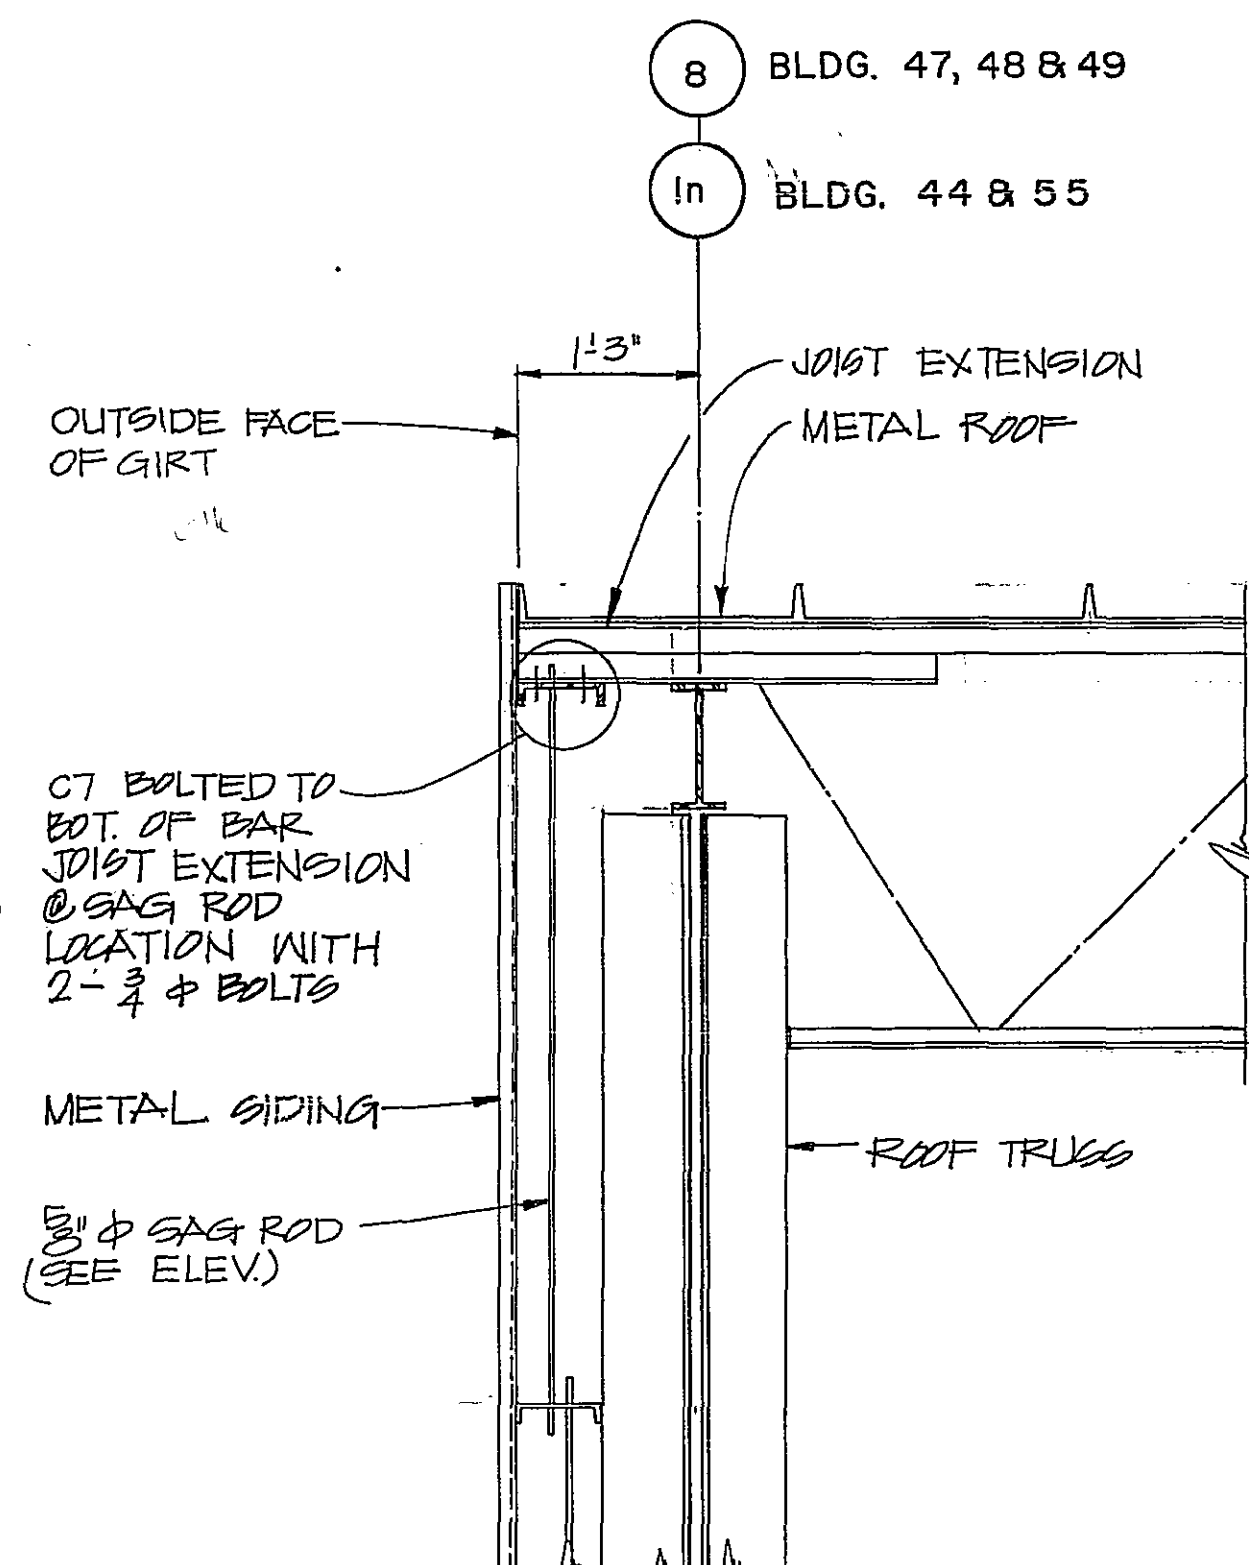


SECTION 2
SCALE: $\frac{3}{4} = 1'-0"$
S2 S20
S4
S9

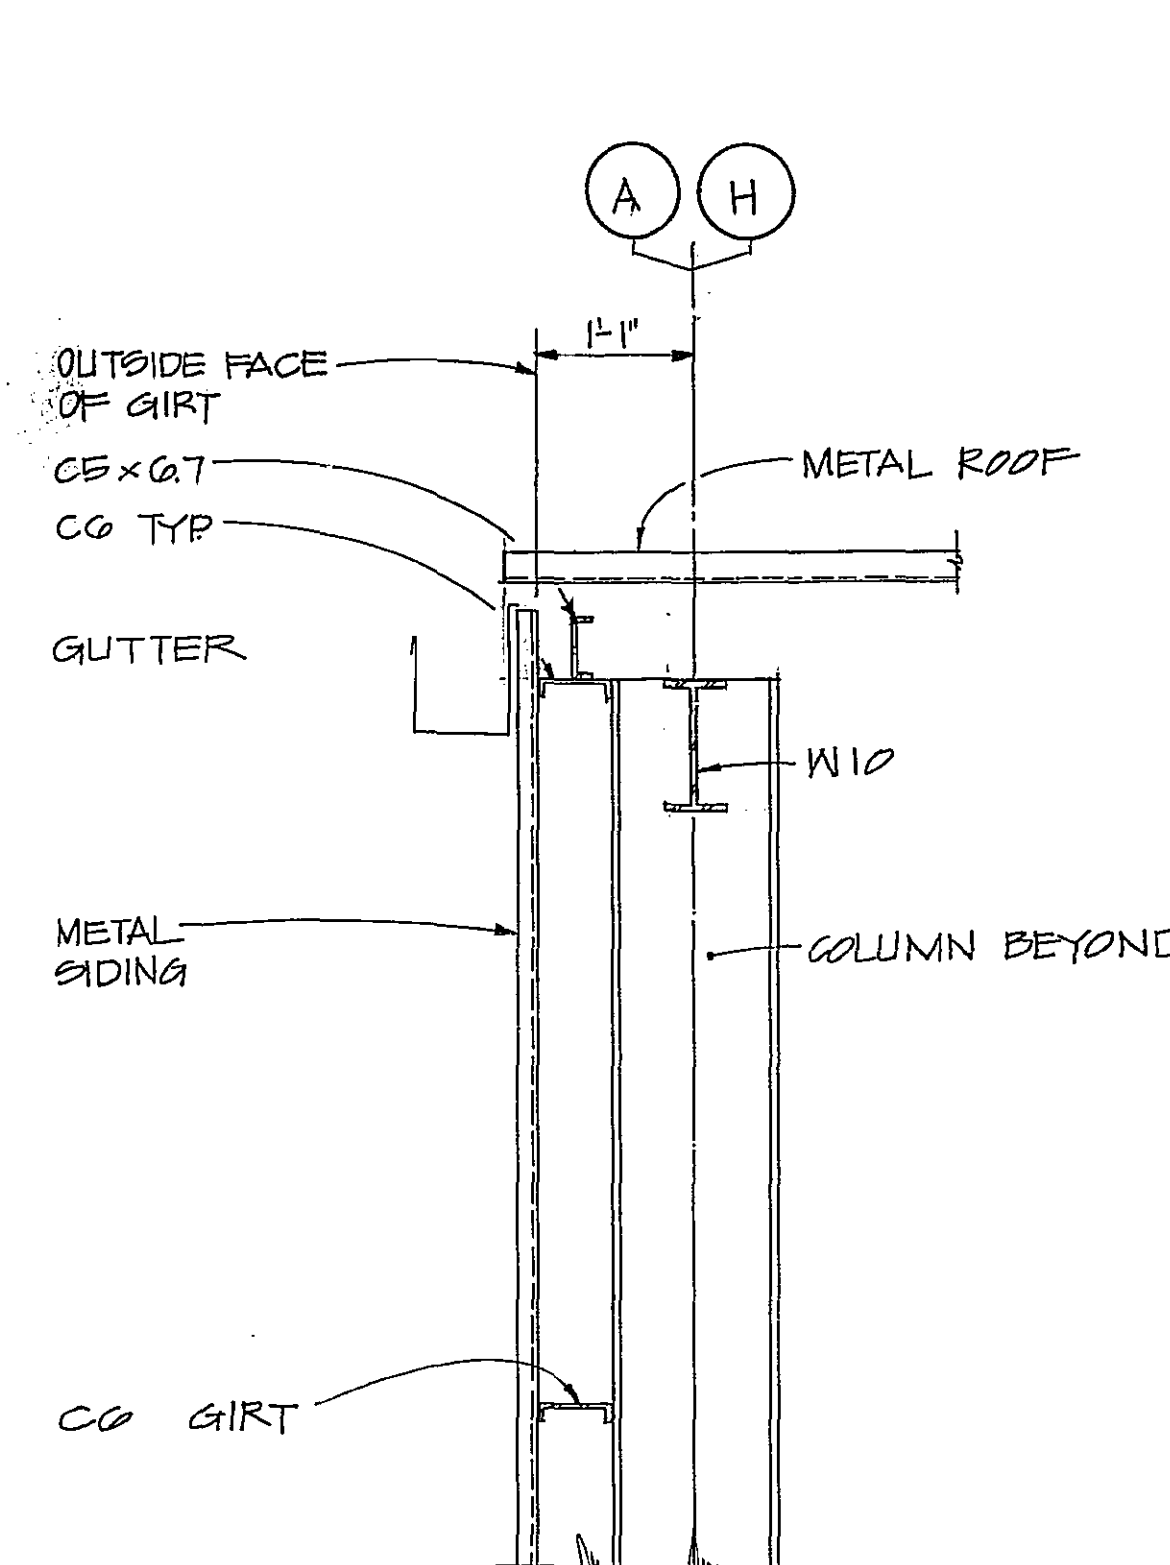


SECTION 3
SCALE: $\frac{3}{4} = 1'-0"$
S2 S20
S4

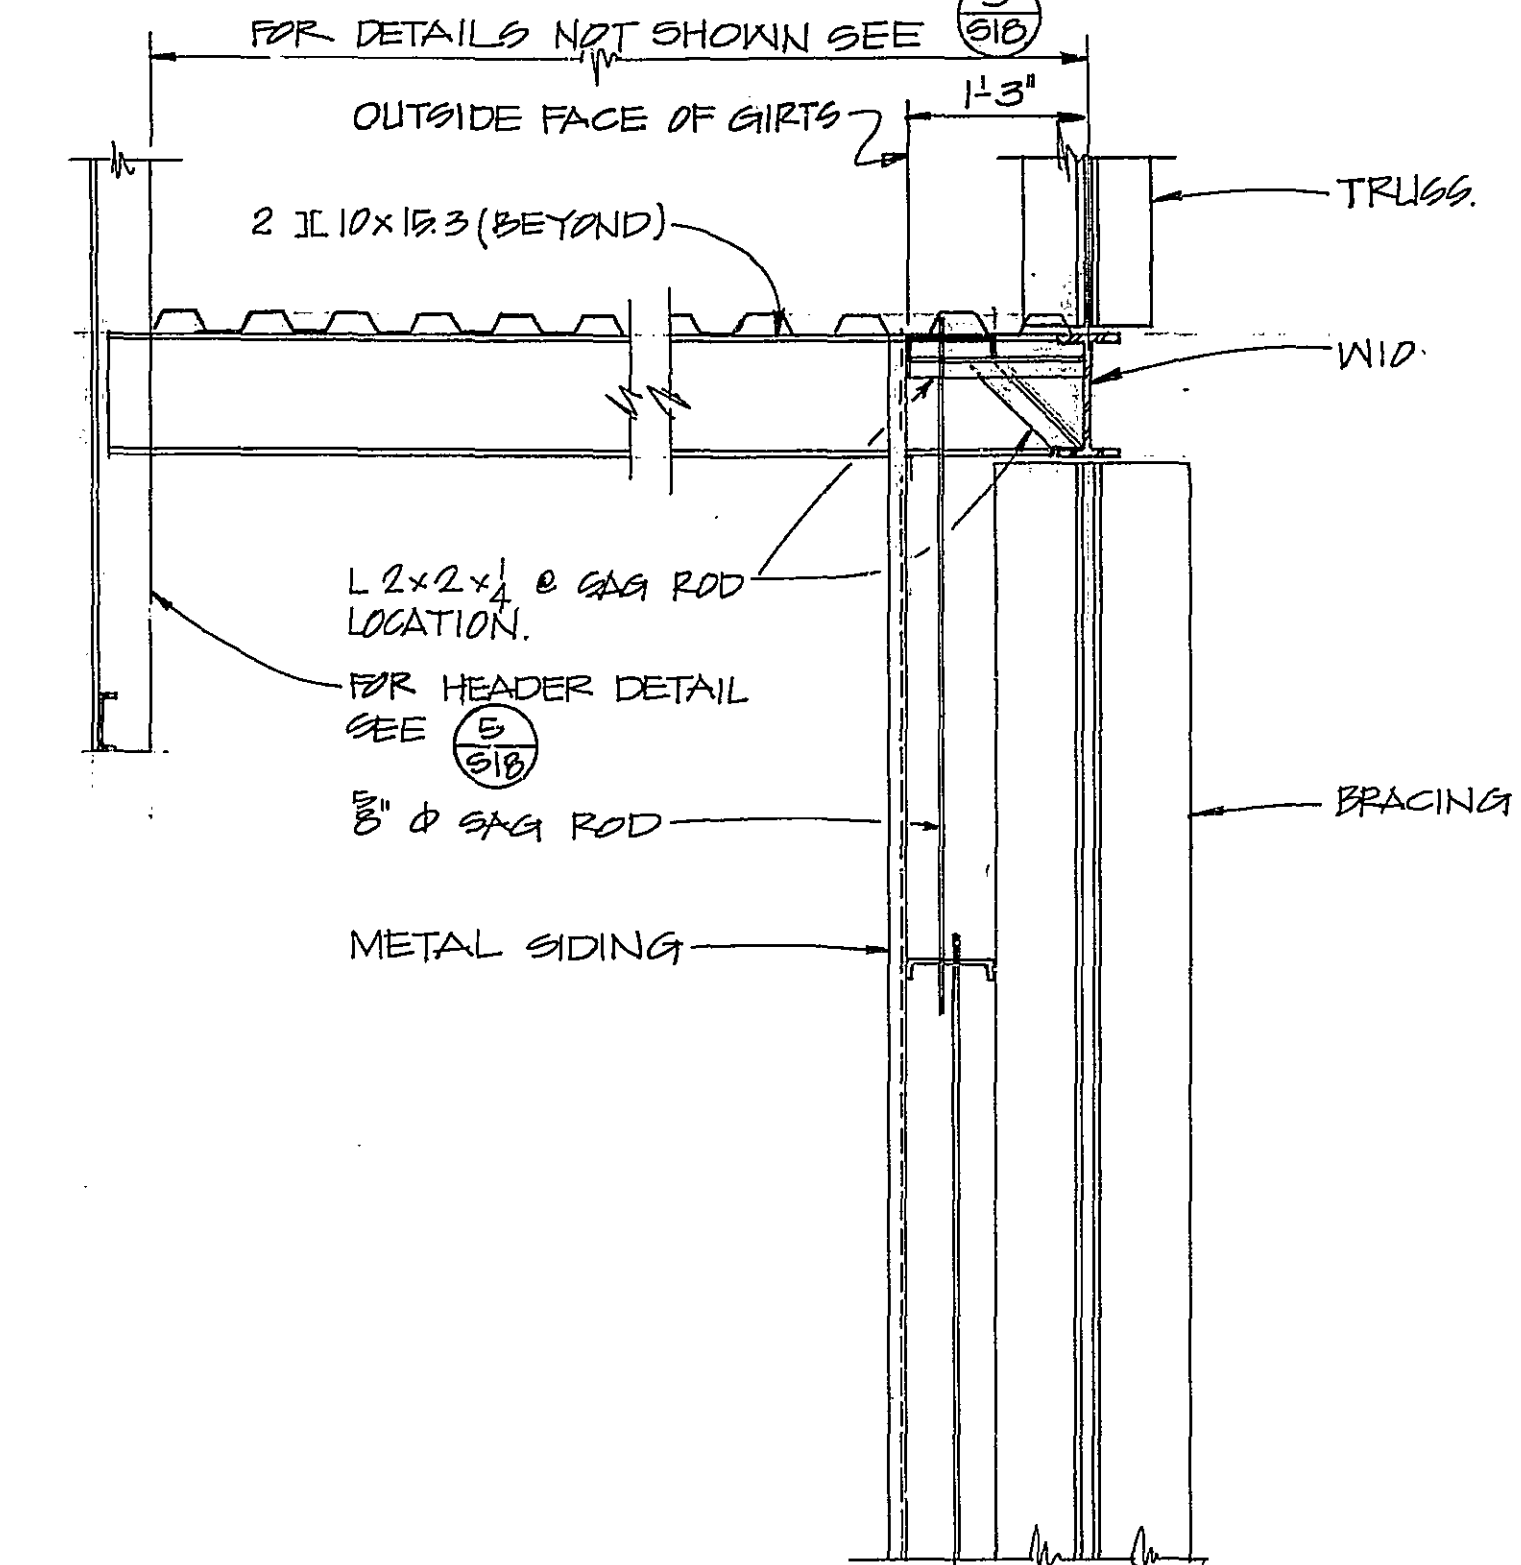


SECTION 4
SCALE: $\frac{3}{4} = 1'-0"$
S2 S20
S4
S9

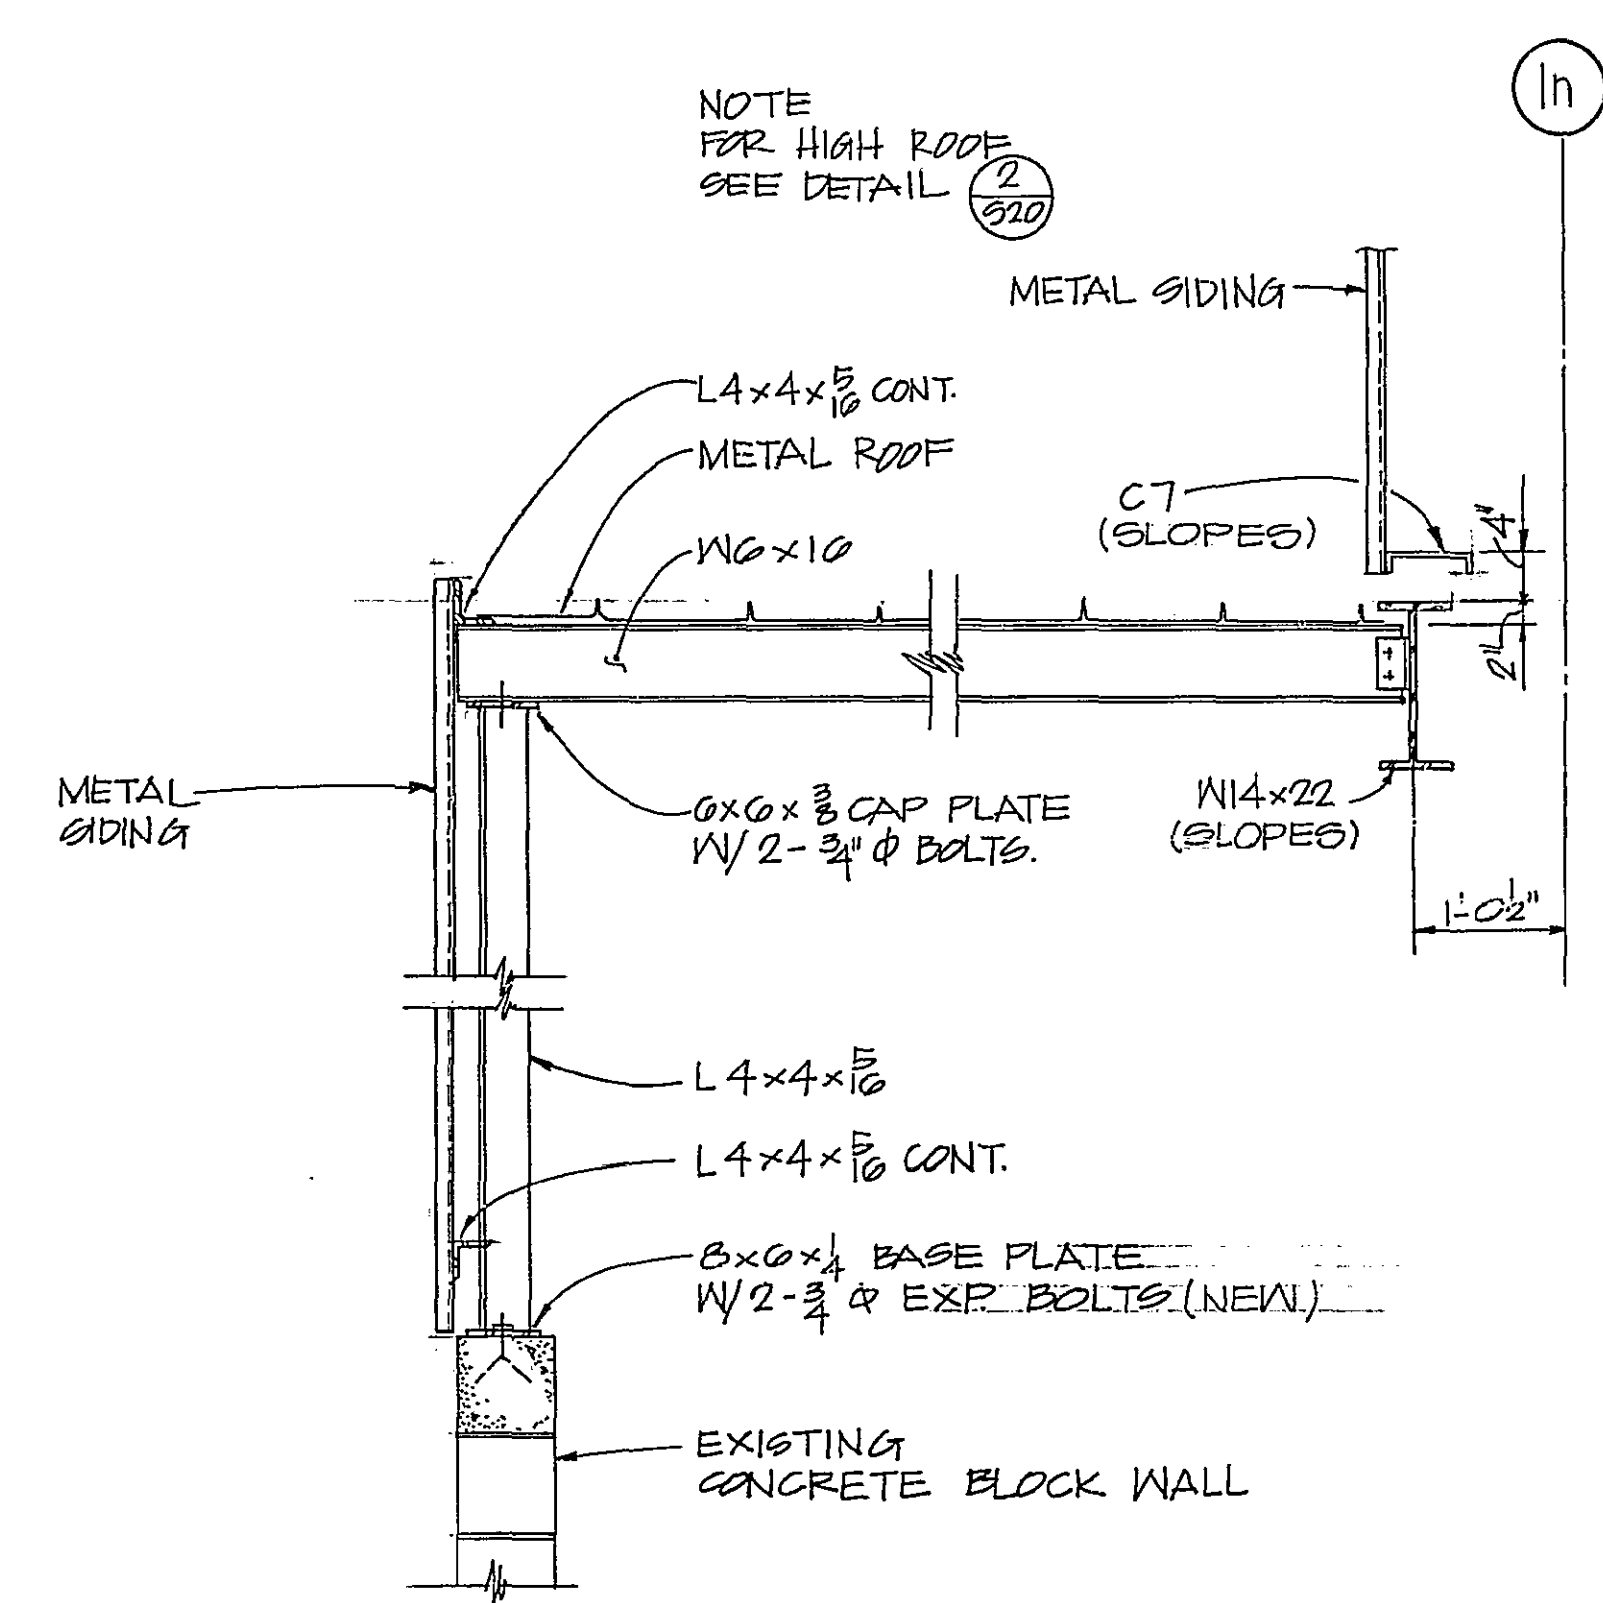


SECTION AT LOW ROOF (44)
SCALE: $\frac{3}{4} = 1'-0"$
S2 S20

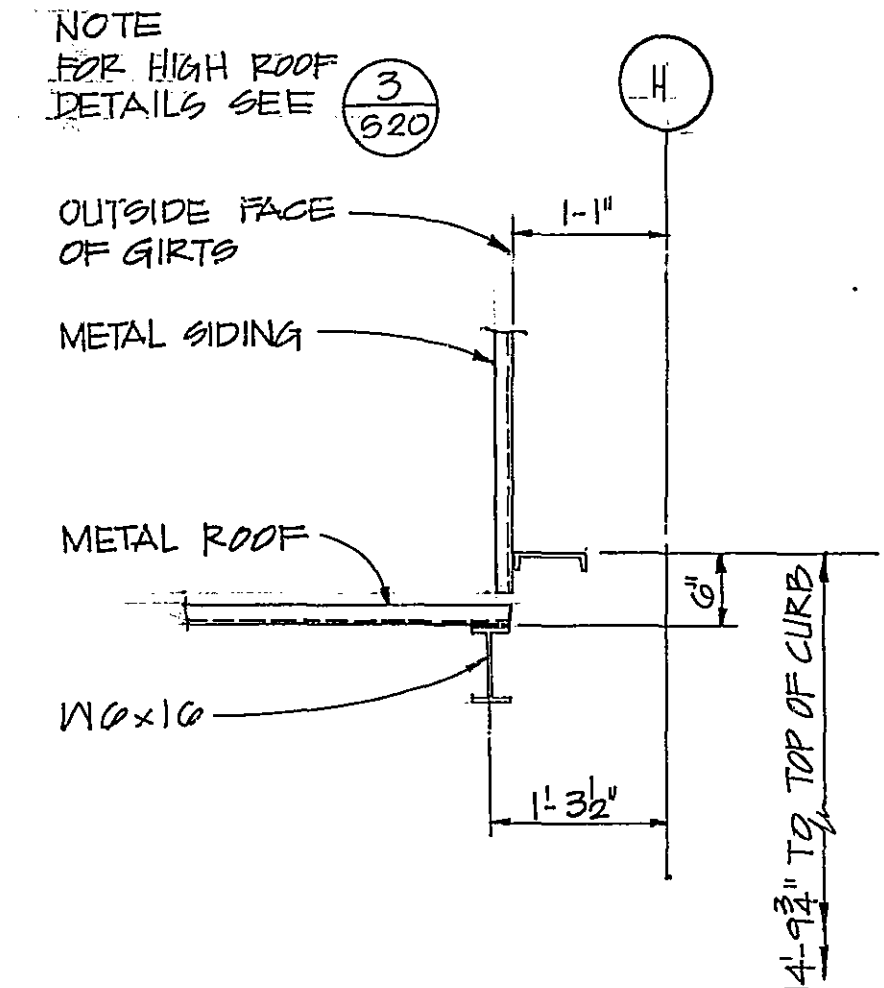

SECTION AT LOW ROOF (44)
SCALE: $\frac{3}{4} = 1'-0"$
S2 S20

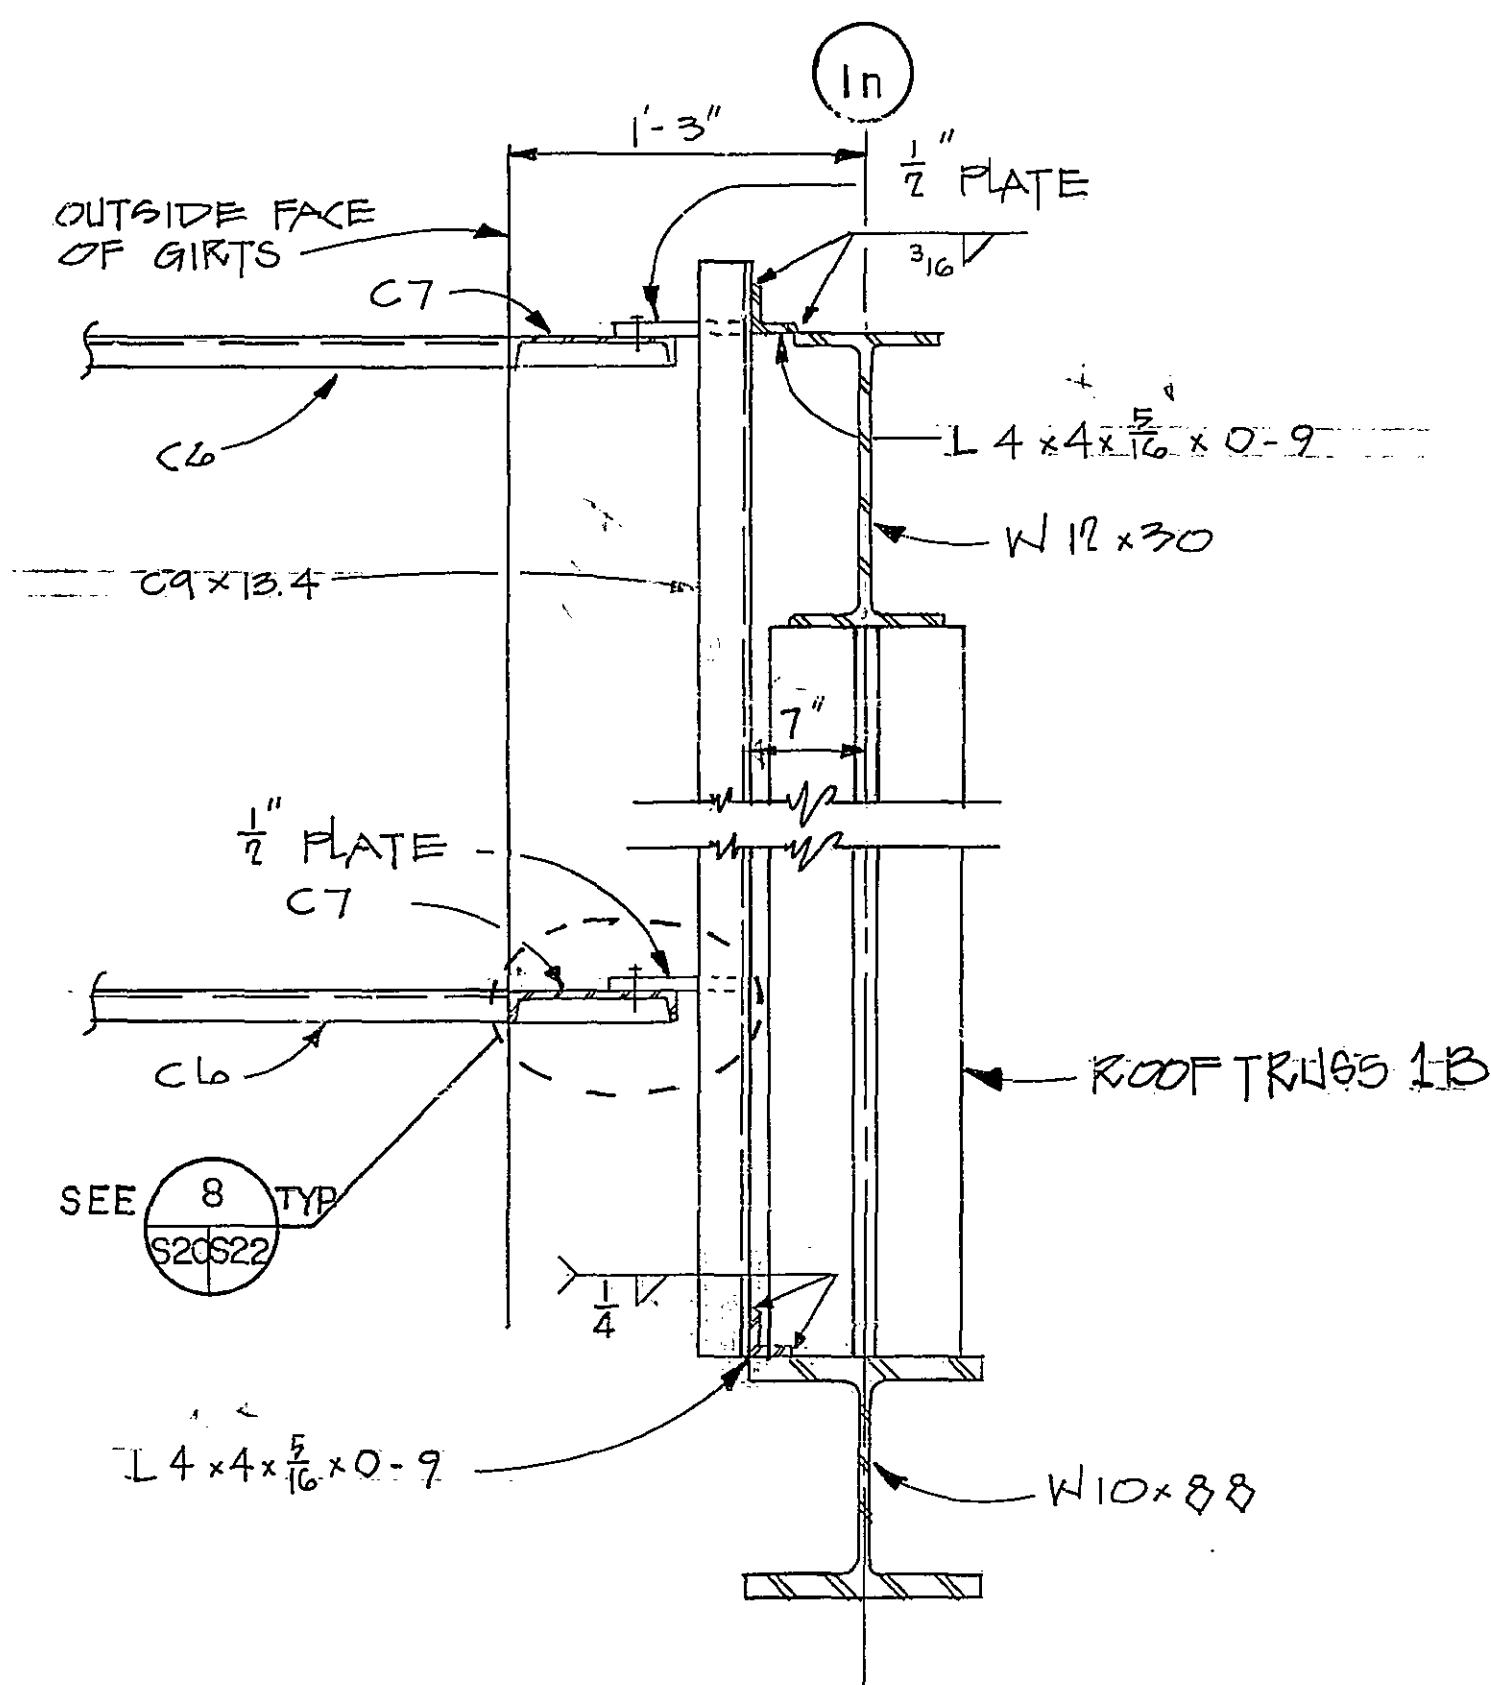

SECTION 7
SCALE: $\frac{1}{2} = 1'-0"$
S7 S20
S22

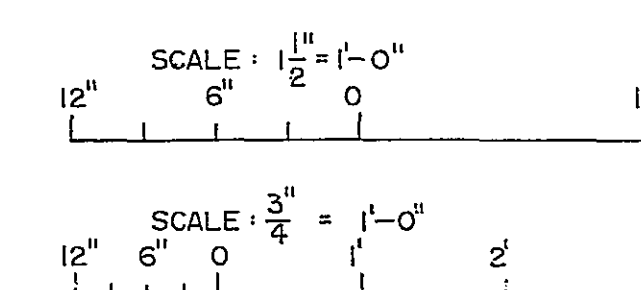

NOTES:
1) SEE 8-23 FOR NOTES.

SYMBOL	ZONE	DESCRIPTION	DATE	BY

WURZ WISECARVER & PRUETT ARCHITECTS ENGINEERS ATLANTA GEORGIA		U. S. ARMY ENGINEER DISTRICT, SAVANNAH CORPS OF ENGINEERS SAVANNAH, GEORGIA	
NOSE DOCK EMPENNAGE ENCLOSURE			
SECTIONS AND DETAILS			
ROBINS AIR FORCE BASE, GEORGIA			
SIZE	INVESTIGATION NO.	DRAWING NO.	PLATE
F	DACA 21-55-B-0090	39-01-08	S-20
SCALE: AS SHOWN			SHEET 50

